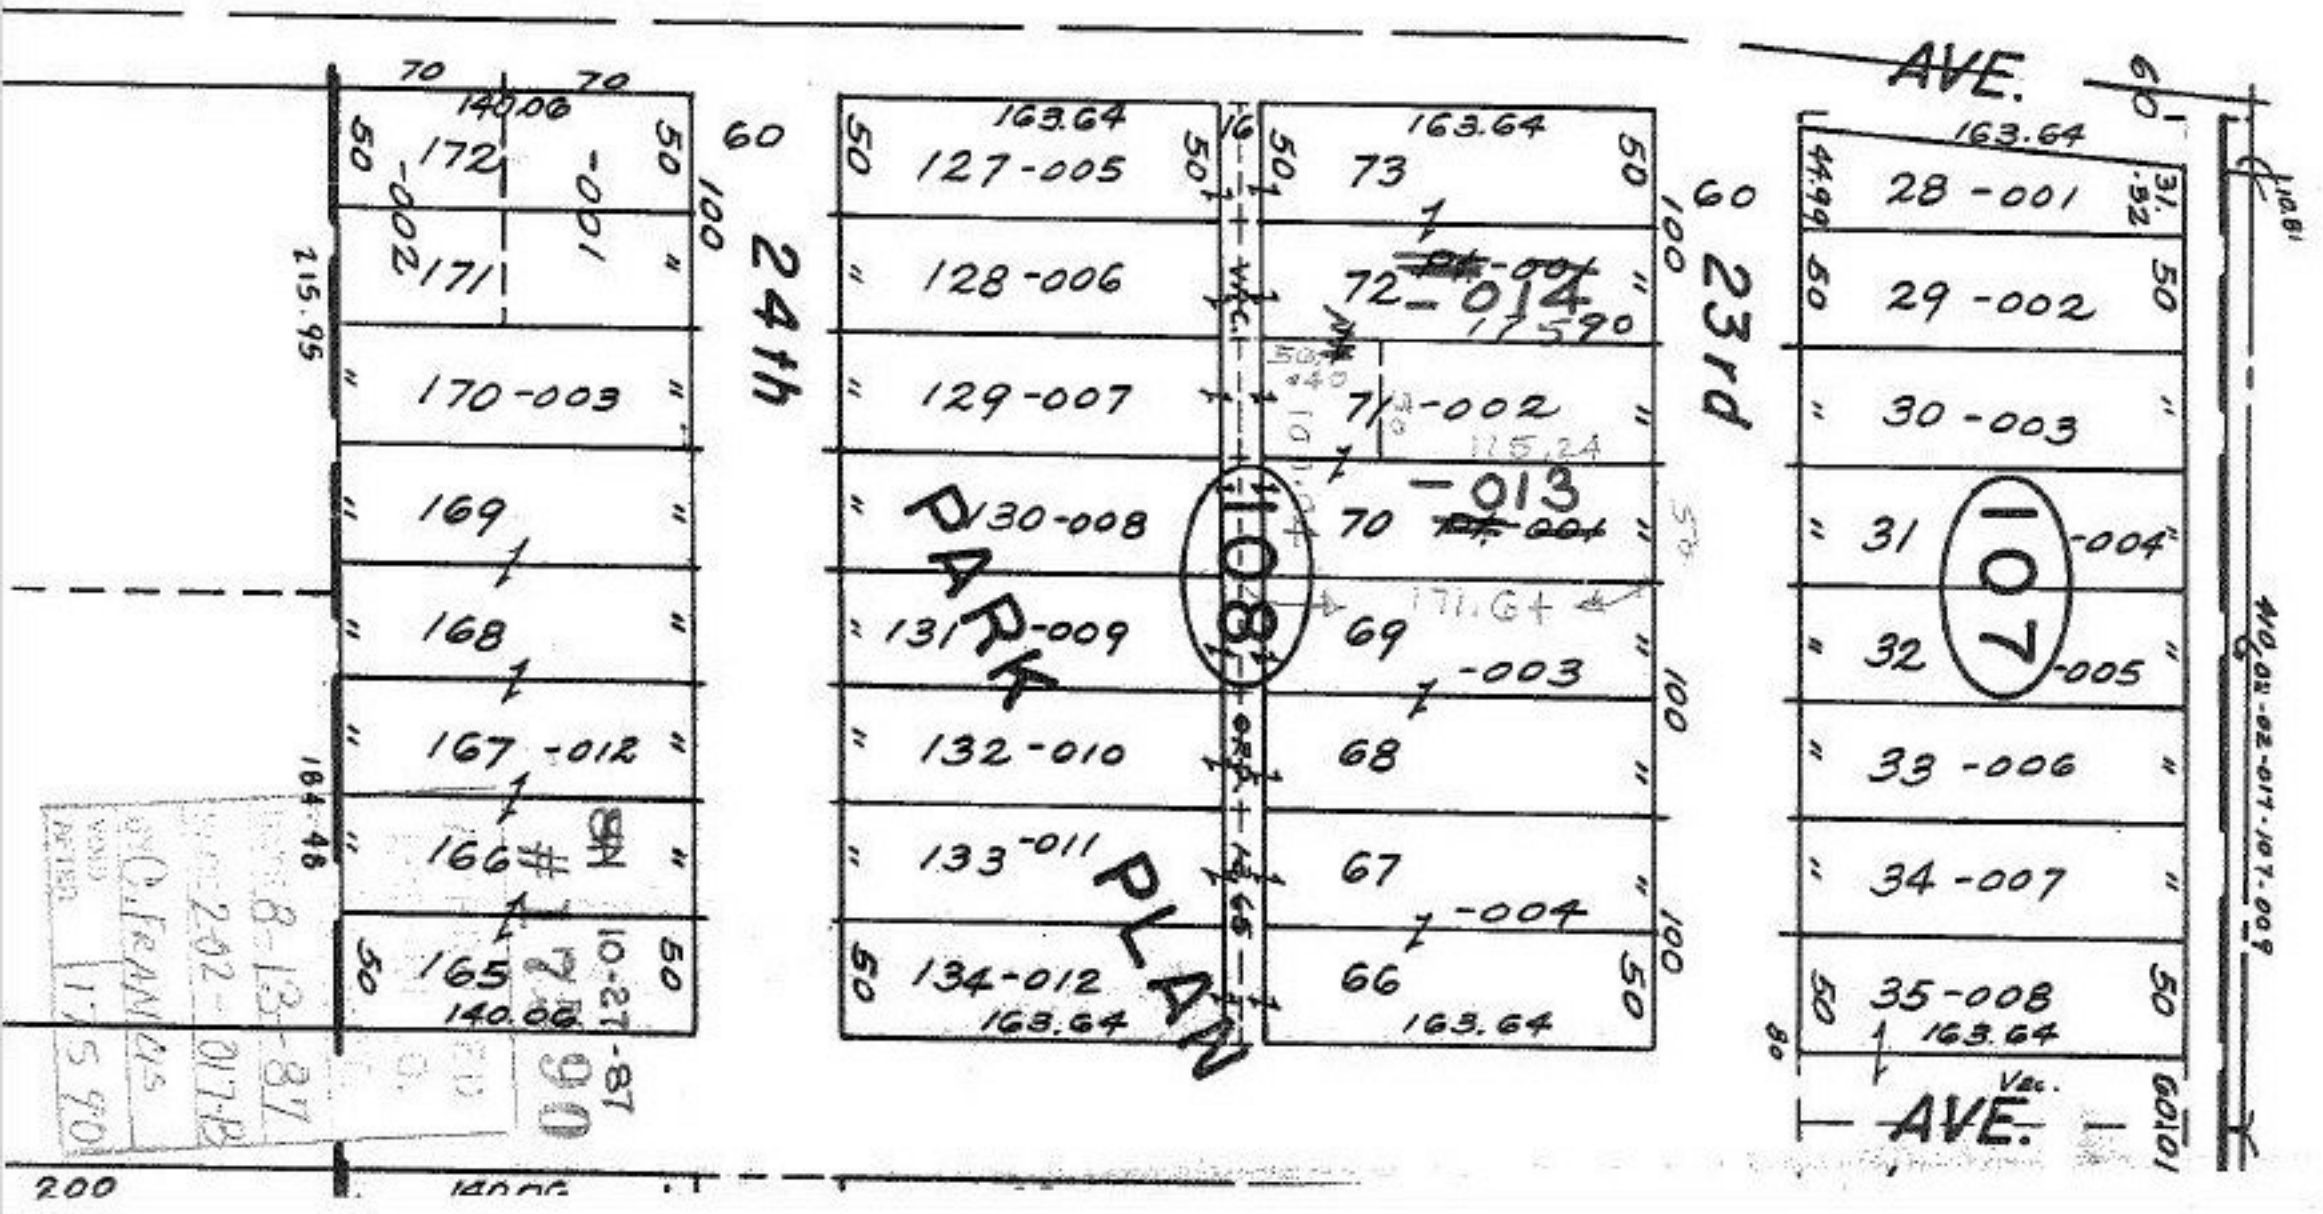02-02-017-108
Prior Deed 743-149
Surveyed By: Dane Haponek
Reg. Surveyor