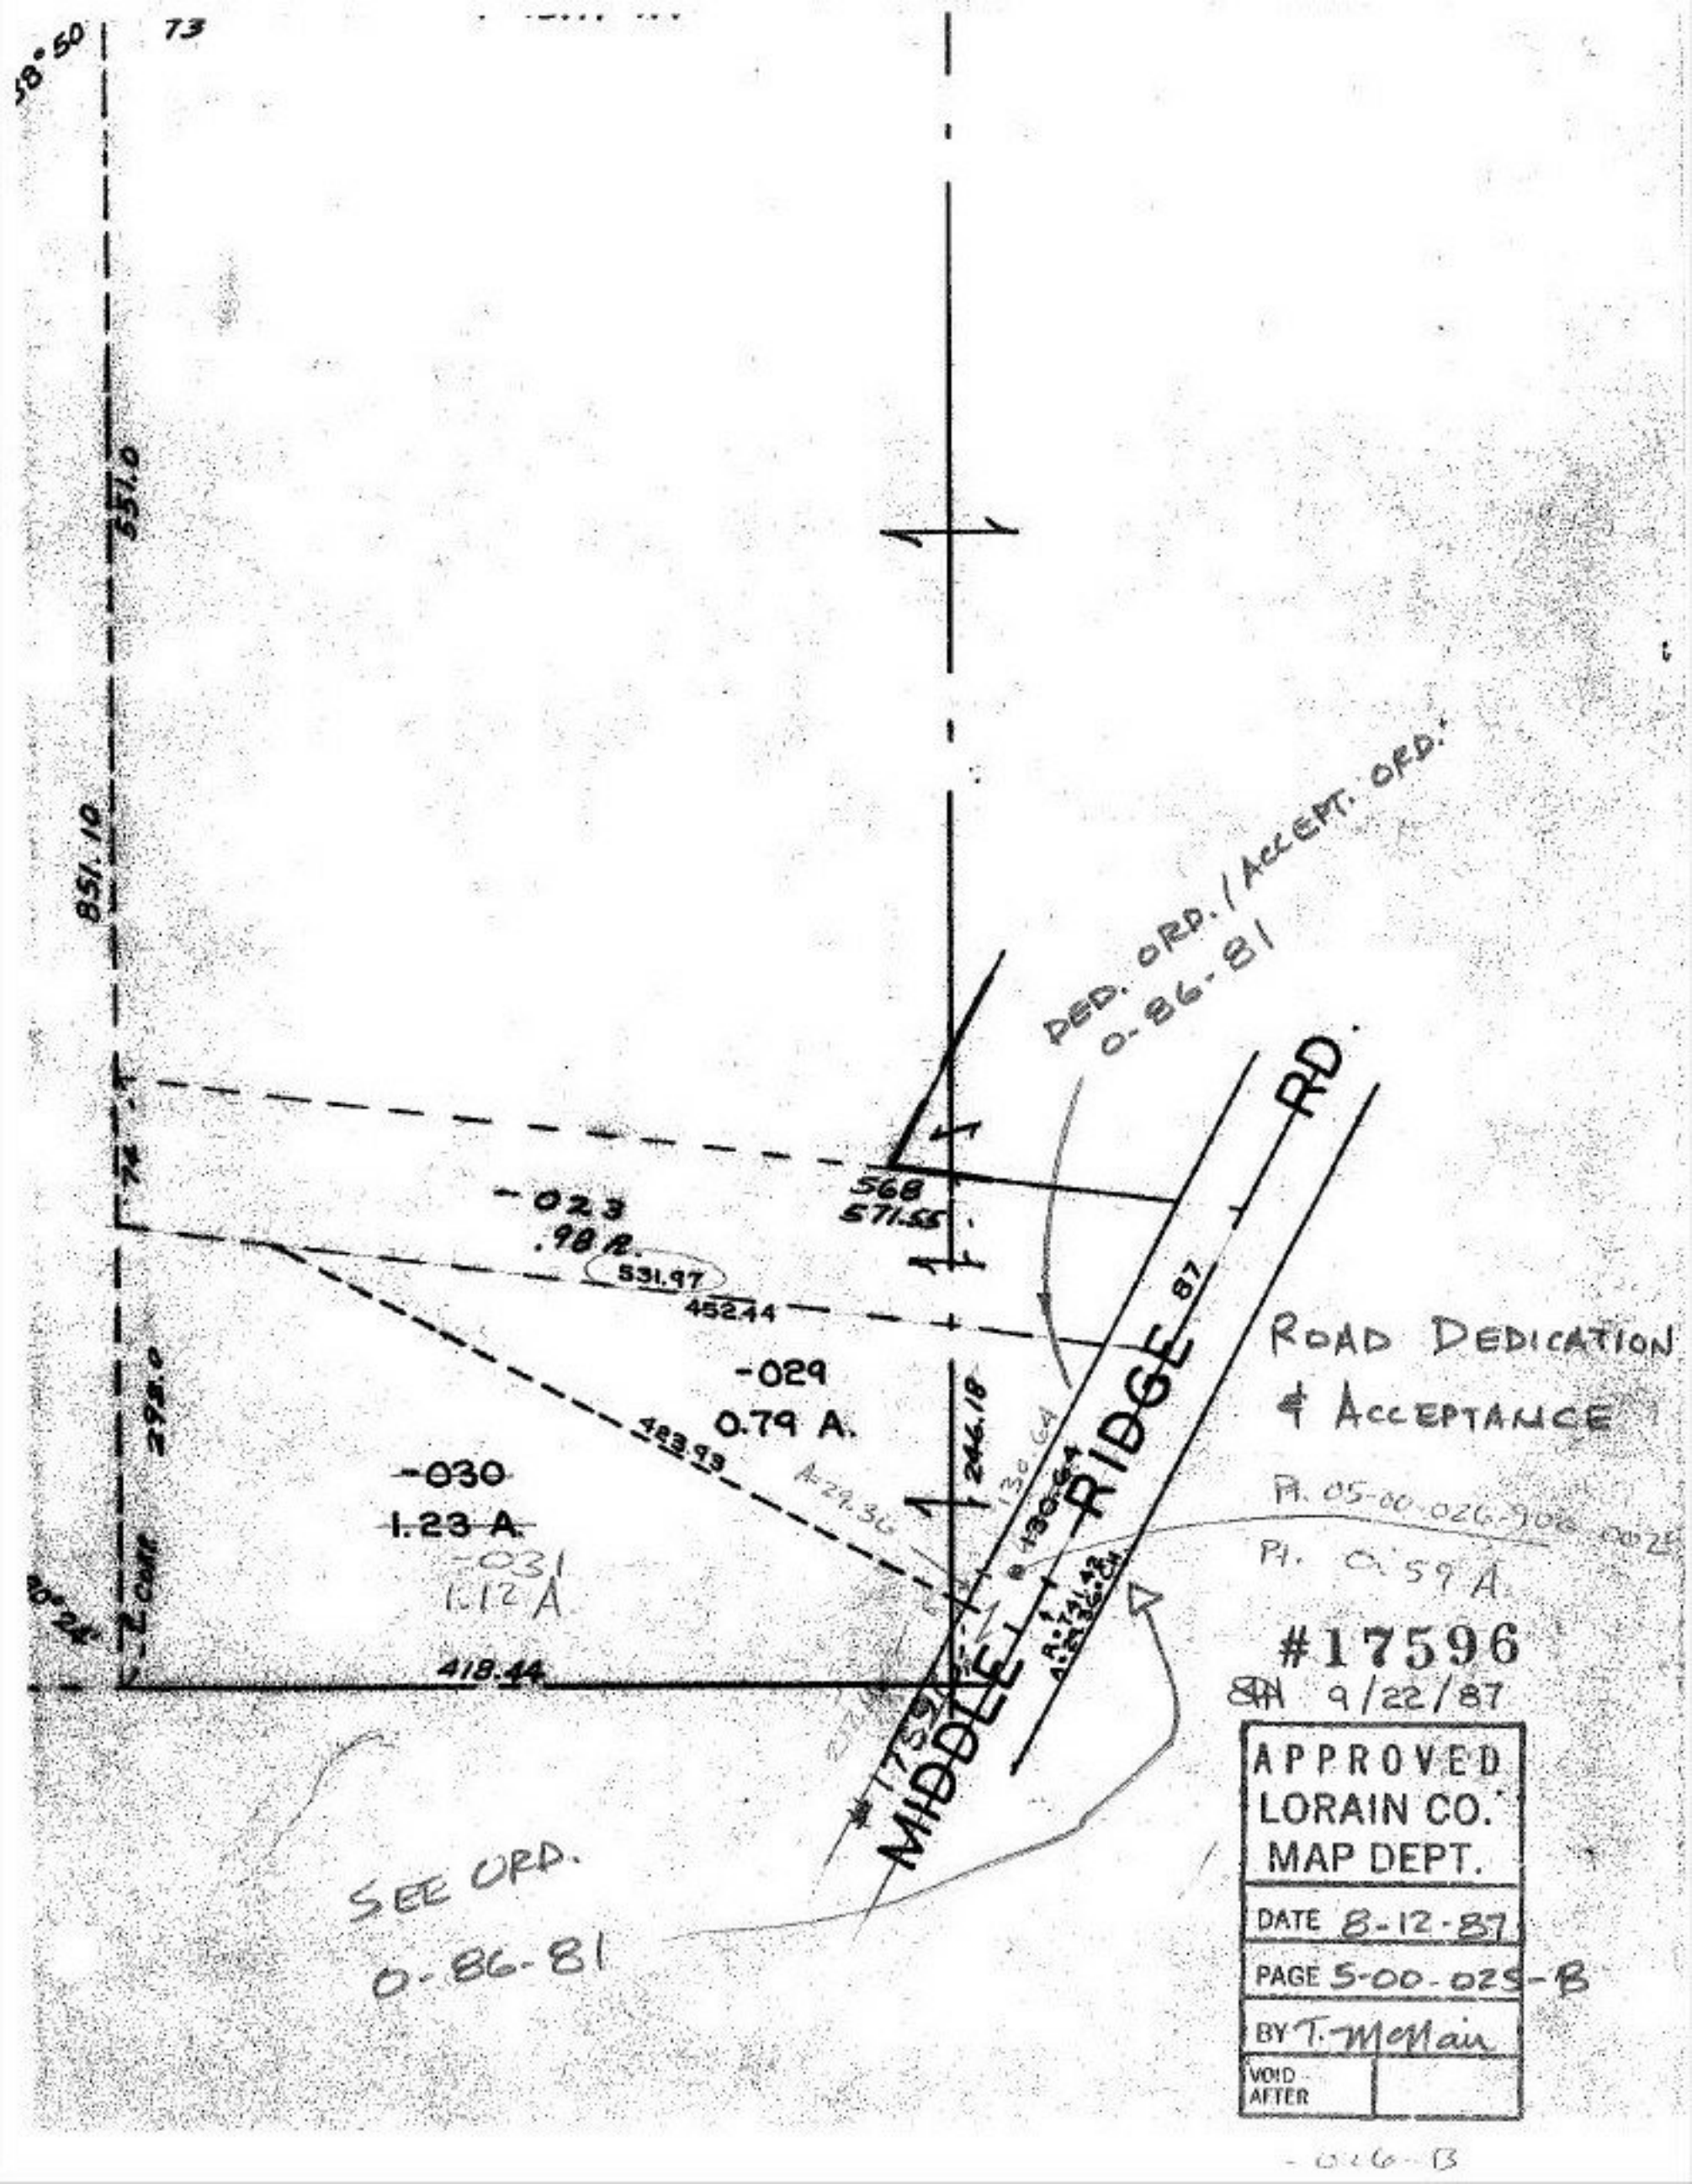
58°50'
73
857.0
851.10
74
295.0
-023
.98 A.
568
571.55
531.97
452.44
-029
0.79 A.
483.93
-030
1.23 A.
-031
1.12 A
418.44
246.18
130.64
MIDDLE RIDGE RD.
87
DED. ORD. / ACCEPT. ORD.
0-86-81
ROAD DEDICATION
& ACCEPTANCE
PA. 05-00-026-908-0025
PA. 0.59 A.
#17596
9/22/87
APPROVED
LORAIN CO.
MAP DEPT.
DATE 8-12-87
PAGE 5-00-025-B
BY T. McNair
VOID AFTER
SEE ORD.
0-86-81

-026-B