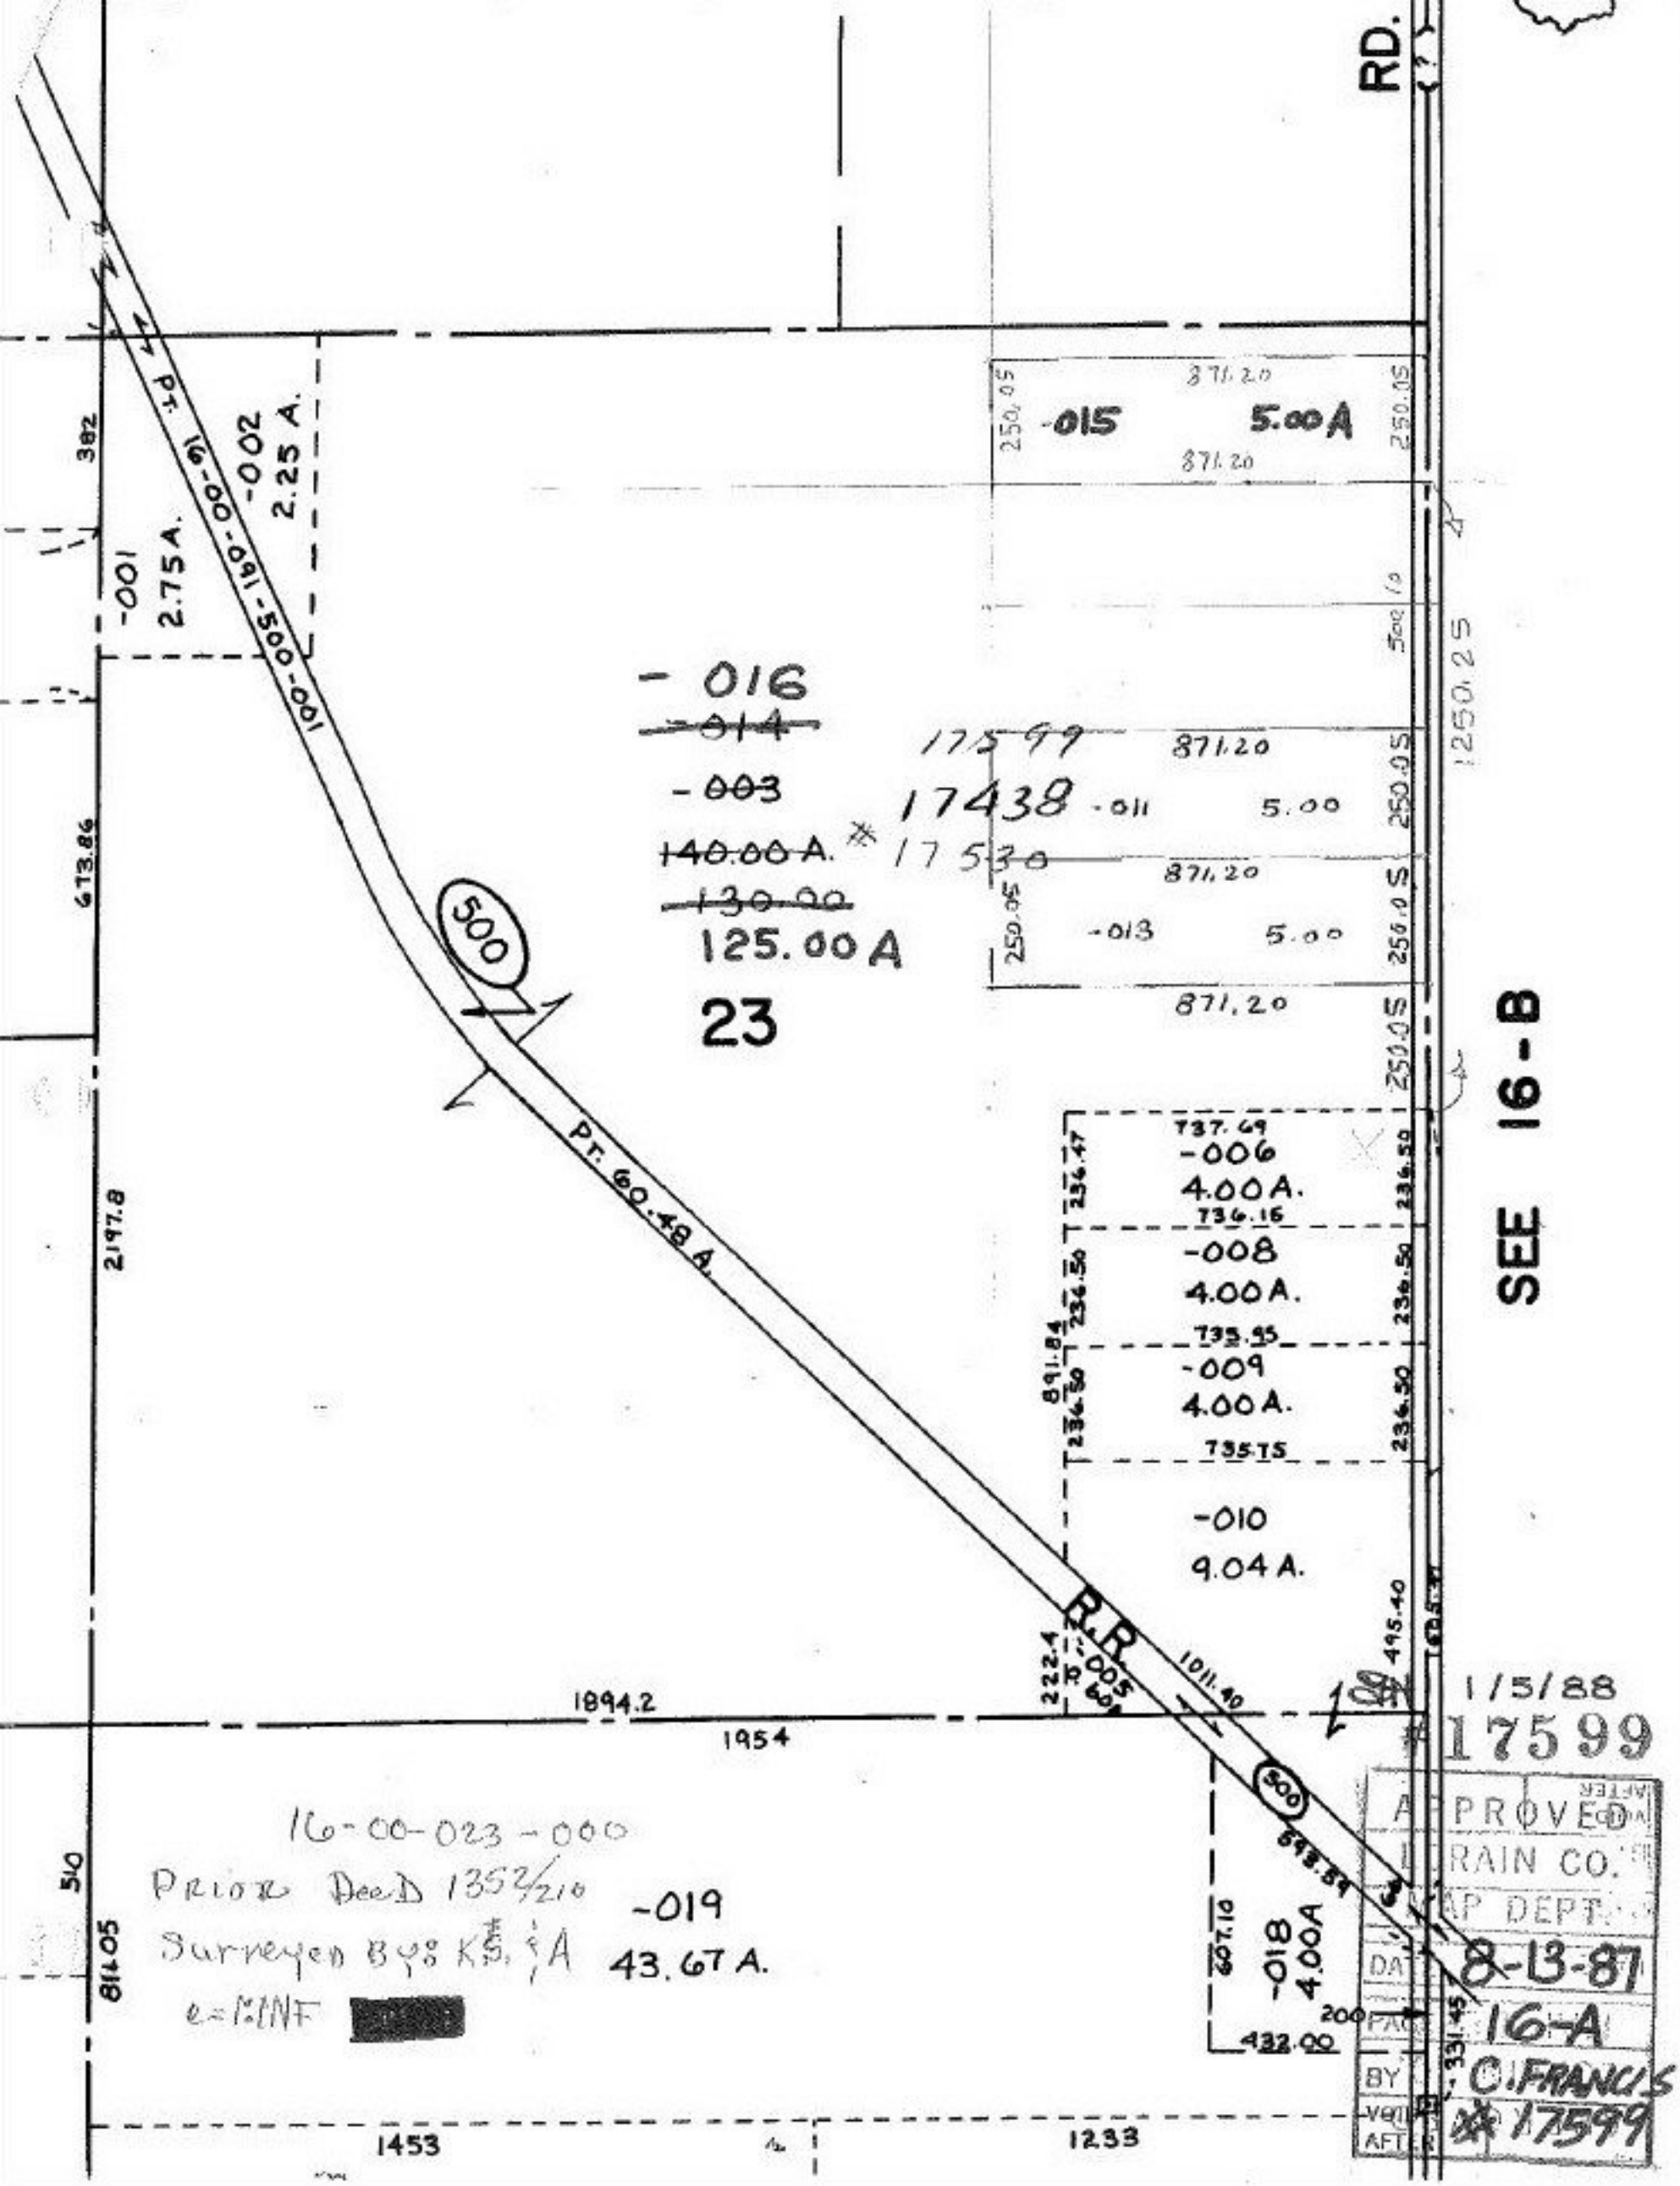
RD.
-015
5.00 A
871.20
250.05
-016
~~-014~~
-003
~~140.00 A.~~
~~130.00~~
125.00 A
23
17599
17438
17530
-011
5.00
-013
5.00
-006
4.00 A.
-008
4.00 A.
-009
4.00 A.
-010
9.04 A.
-018
4.00 A
-019
43.67 A.
-001
2.75 A.
-002
2.25 A.
Pt. 60.48 A.
500
R.R.
1250.25
SEE 16-B
1894.2
1954
1453
1233
2197.8
673.86
382
510
811.05
16-00-023-000
Prior Deed 1352/210
Surveyed By: K.S. & A
e=1:INF
1/5/88
#17599
APPROVED
MAP DEPT.
DATE 8-13-87
PAGE 16-A
BY C. FRANCIS
VOID AFTER #17599