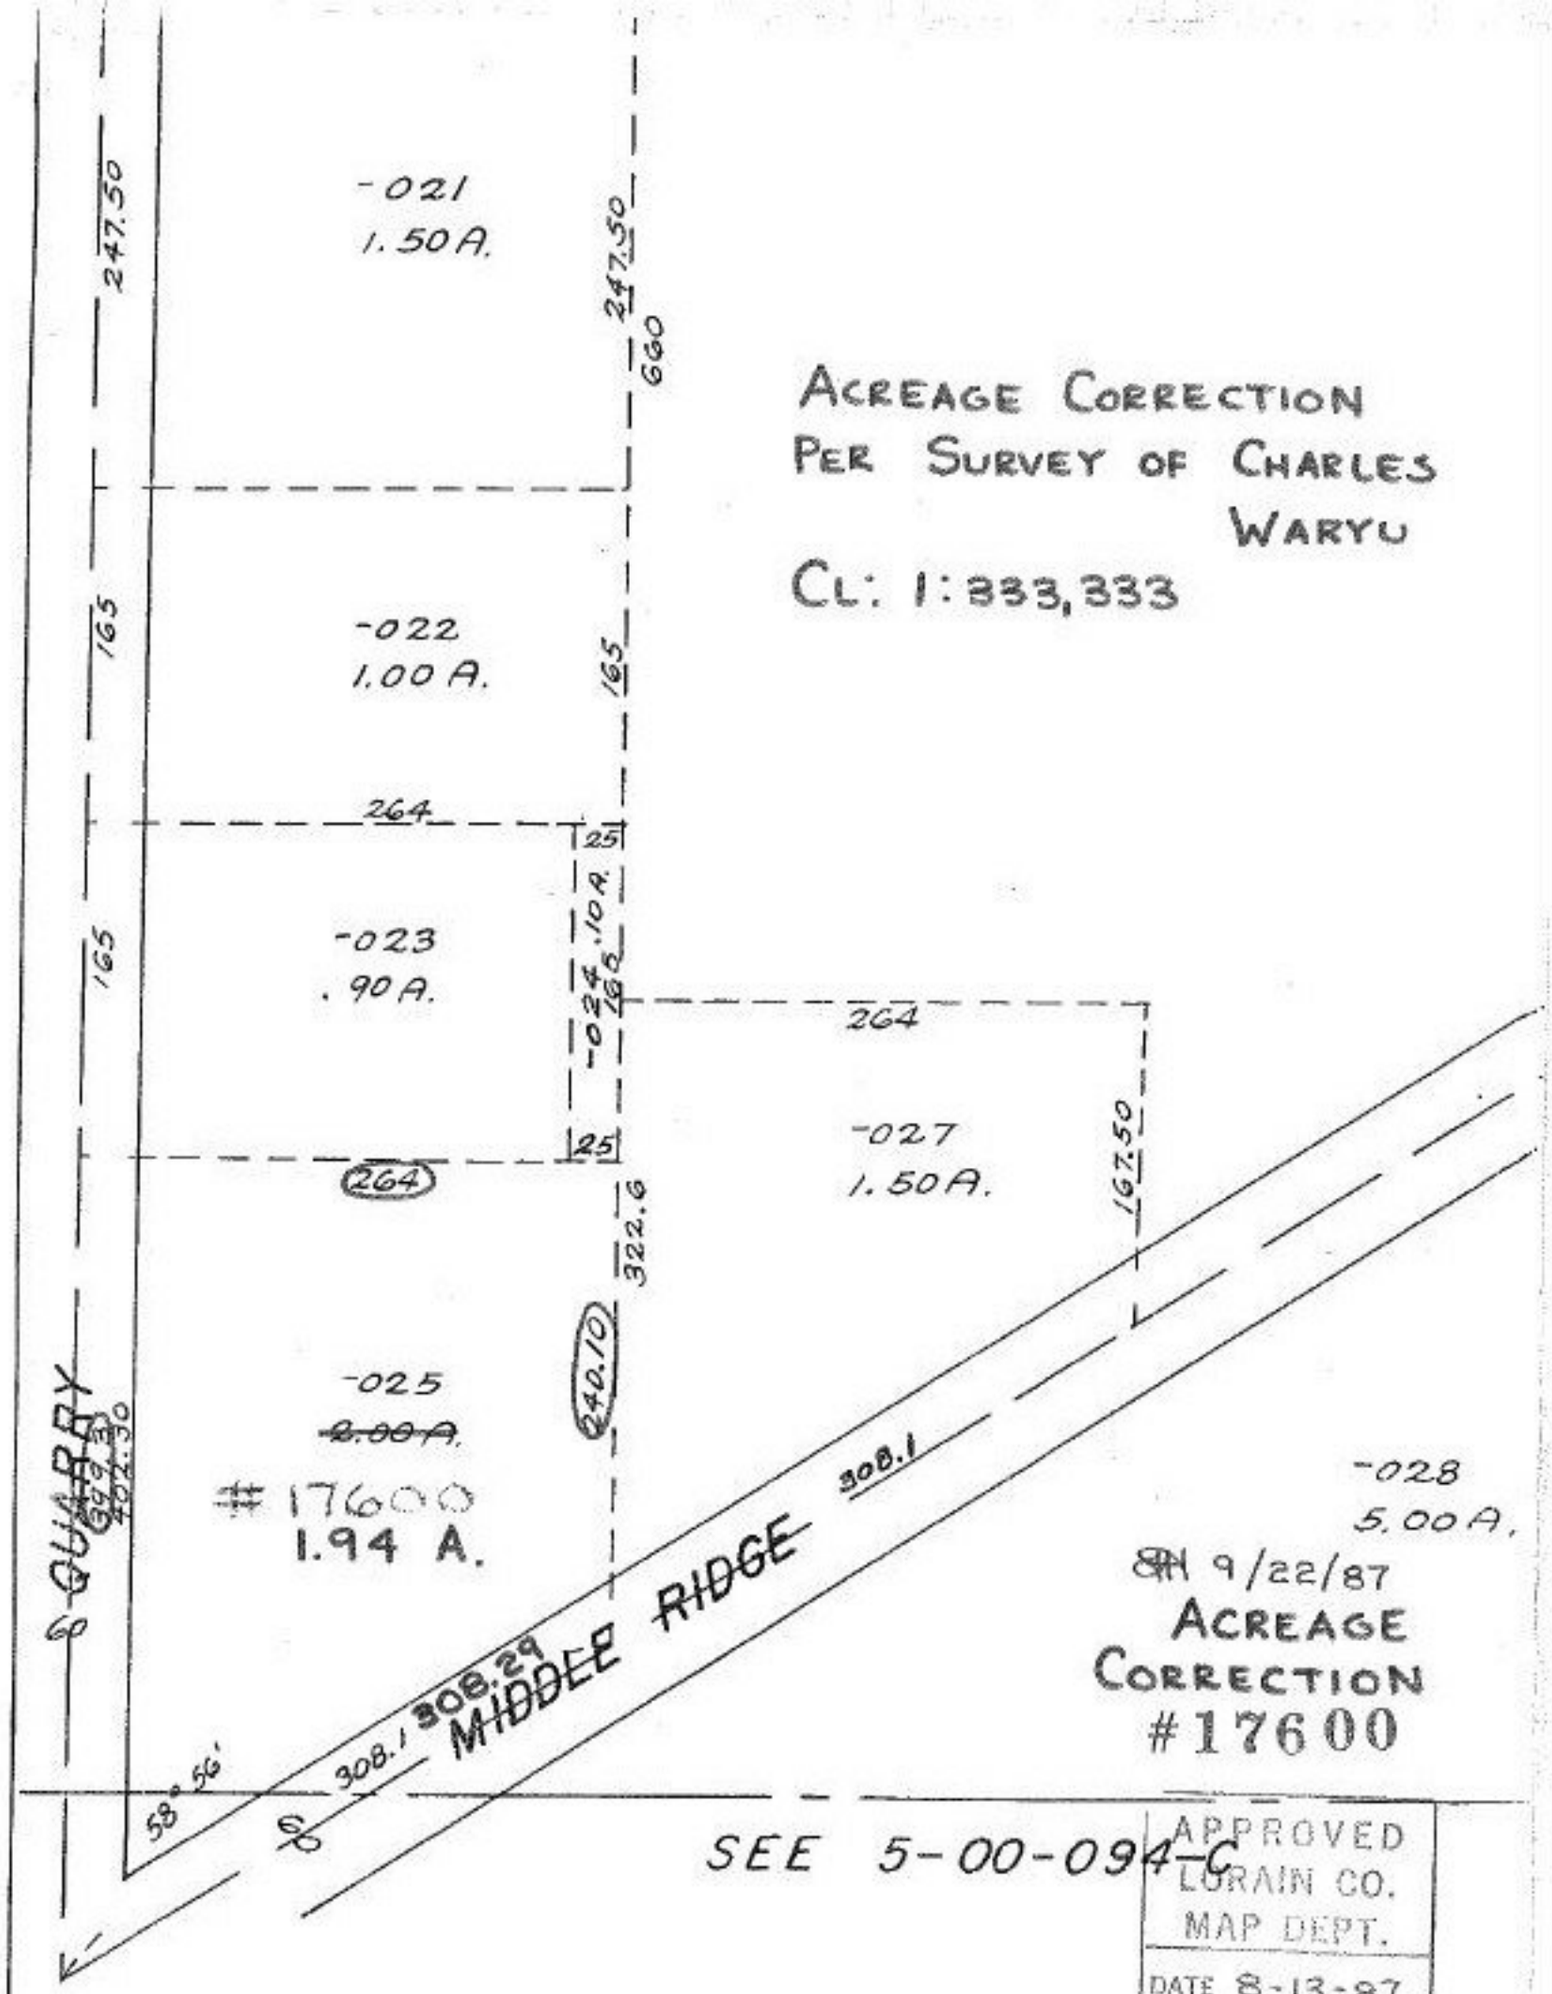

ACREAGE CORRECTION
PER SURVEY OF CHARLES WARYU

CL: 1:333,333

SH 9/22/87
ACREAGE CORRECTION
#17600

APPROVED LORAIN CO. MAP DEPT.	
DATE 8-13-87	
PAGE 5-00-095-C	
BY T. HOLLIS	
VOID AFTER	17600