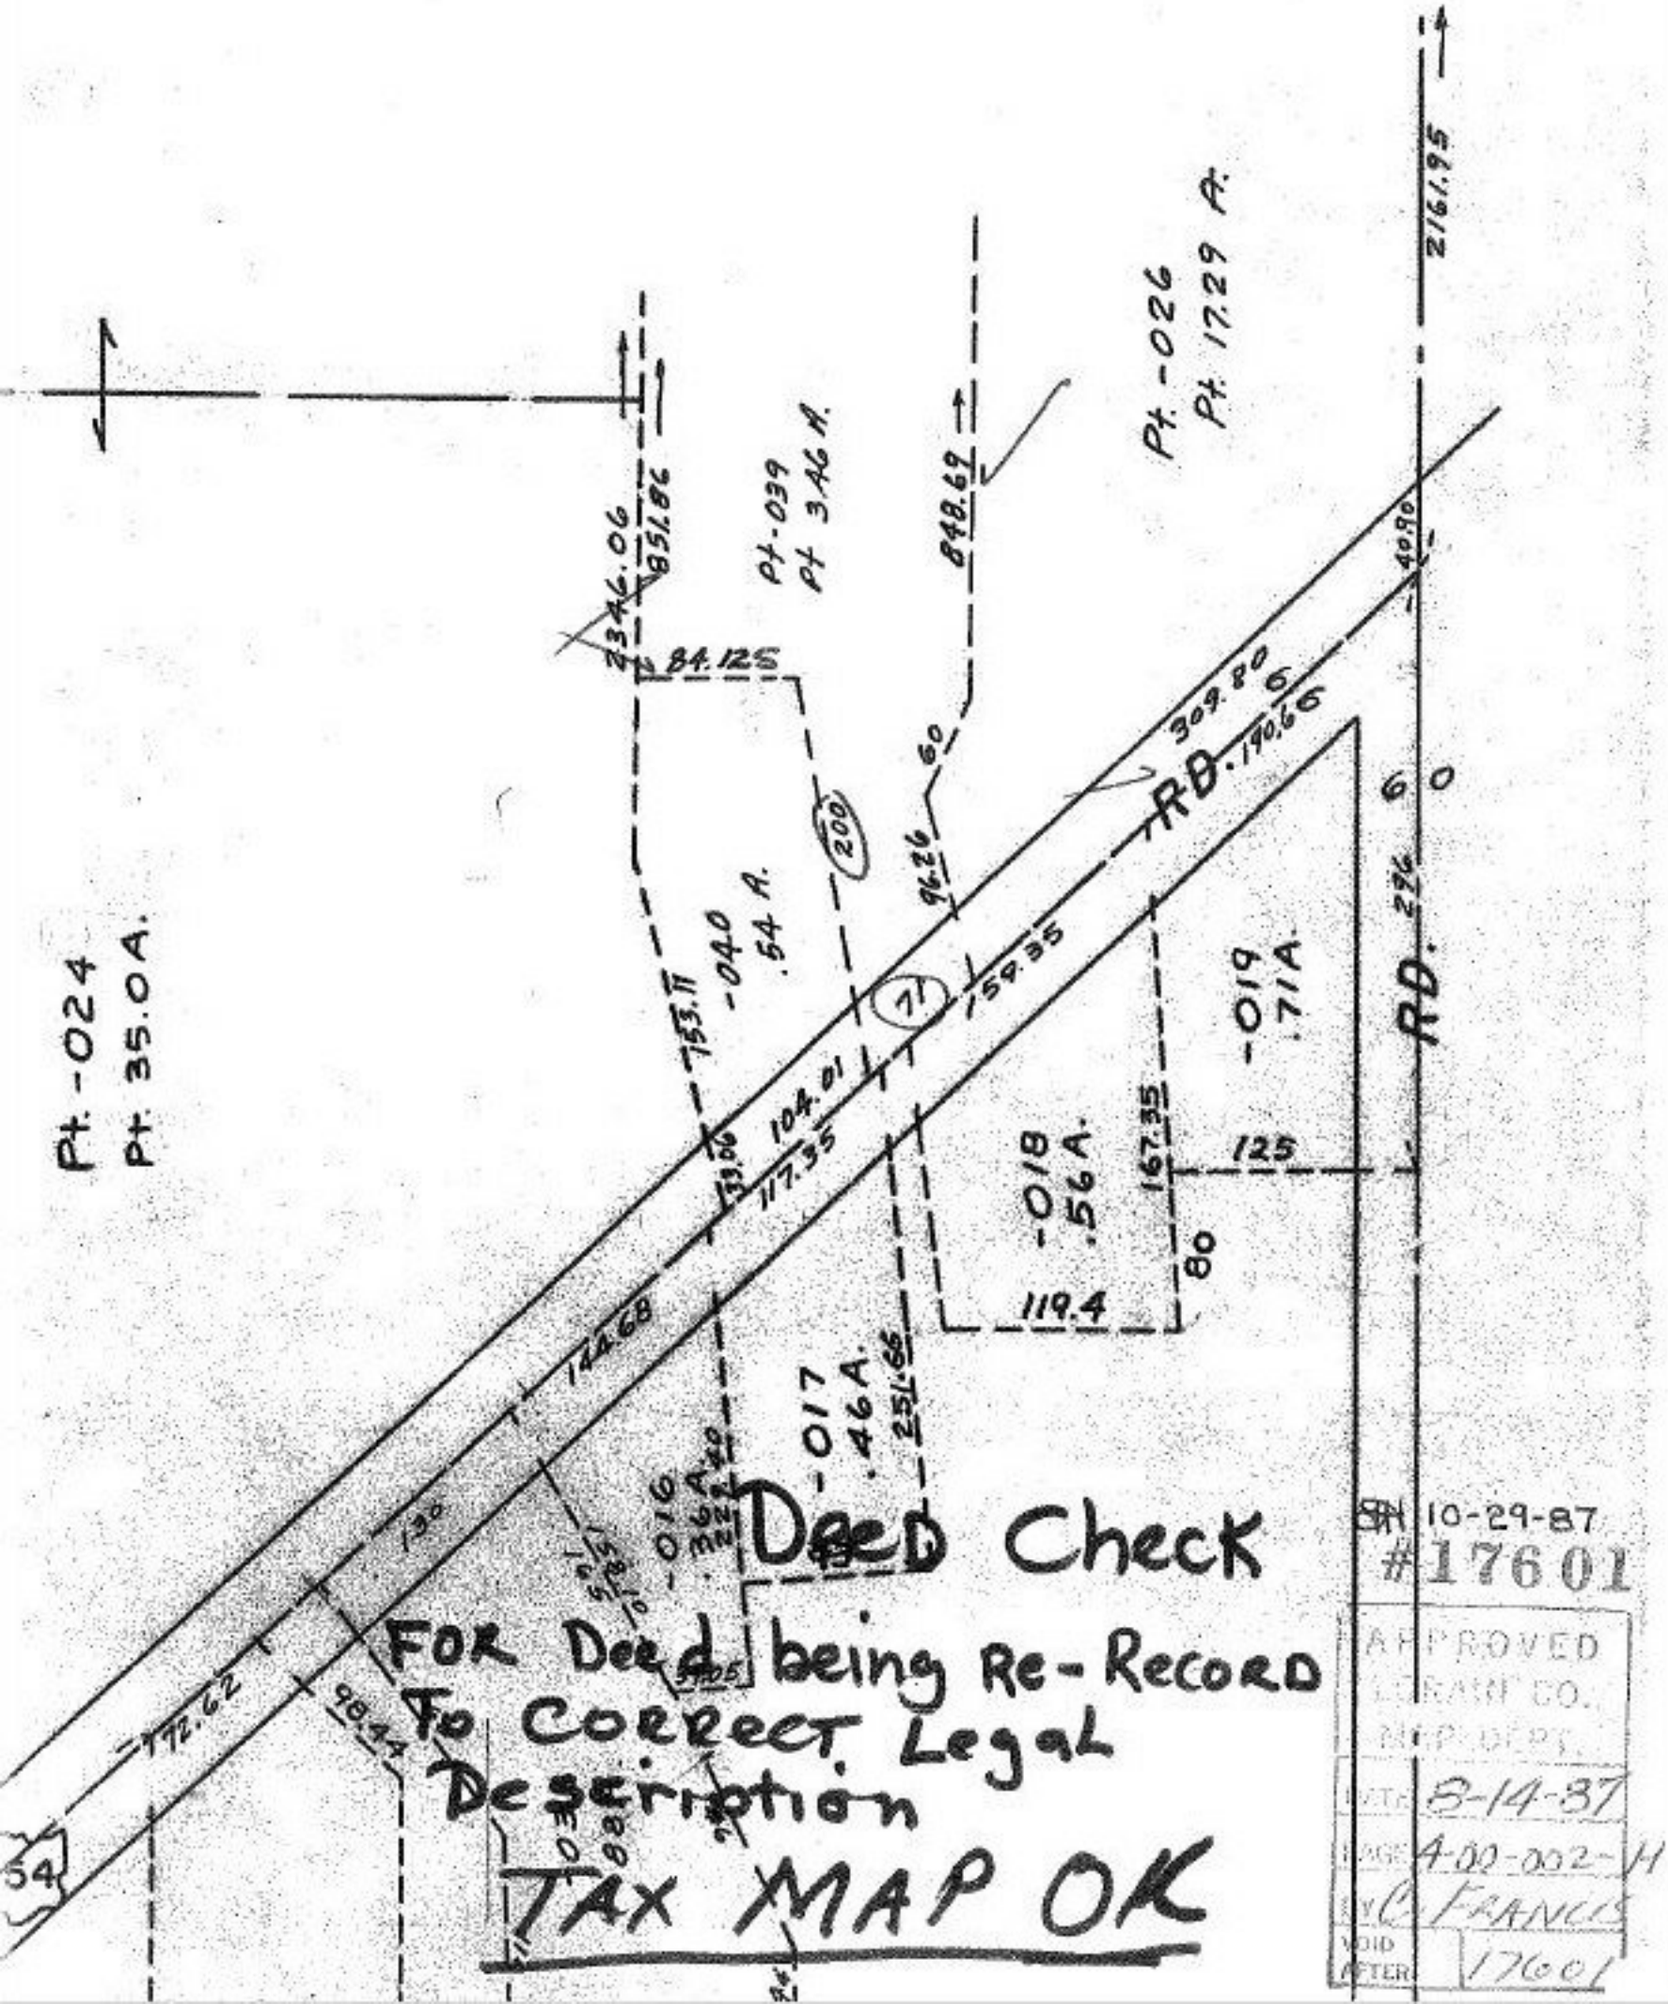
Pt. -024
Pt. 35.0 A.
Pt. -039
Pt 3.46 A.
Pt. -026
Pt. 17.29 A.
2161.95
2346.06
851.86
848.69
84.125
309.80
190.66
RD.
RD.
-040
.54 A.
-019
.71 A.
-018
.56 A.
-017
.46 A.
-016
.36 A.
104.01
117.35
159.35
167.35
125
119.4
144.68
251.66
172.62
98.44
Deed Check
For Deed being Re-Record
To Correct Legal
Description
TAX MAP OK
10-29-87
#17601
APPROVED
LORAIN CO.
MAP DEPT.
DATE 8-14-87
PAGE 4-00-002-H
BY C. FRANCIS
VOID AFTER 17601