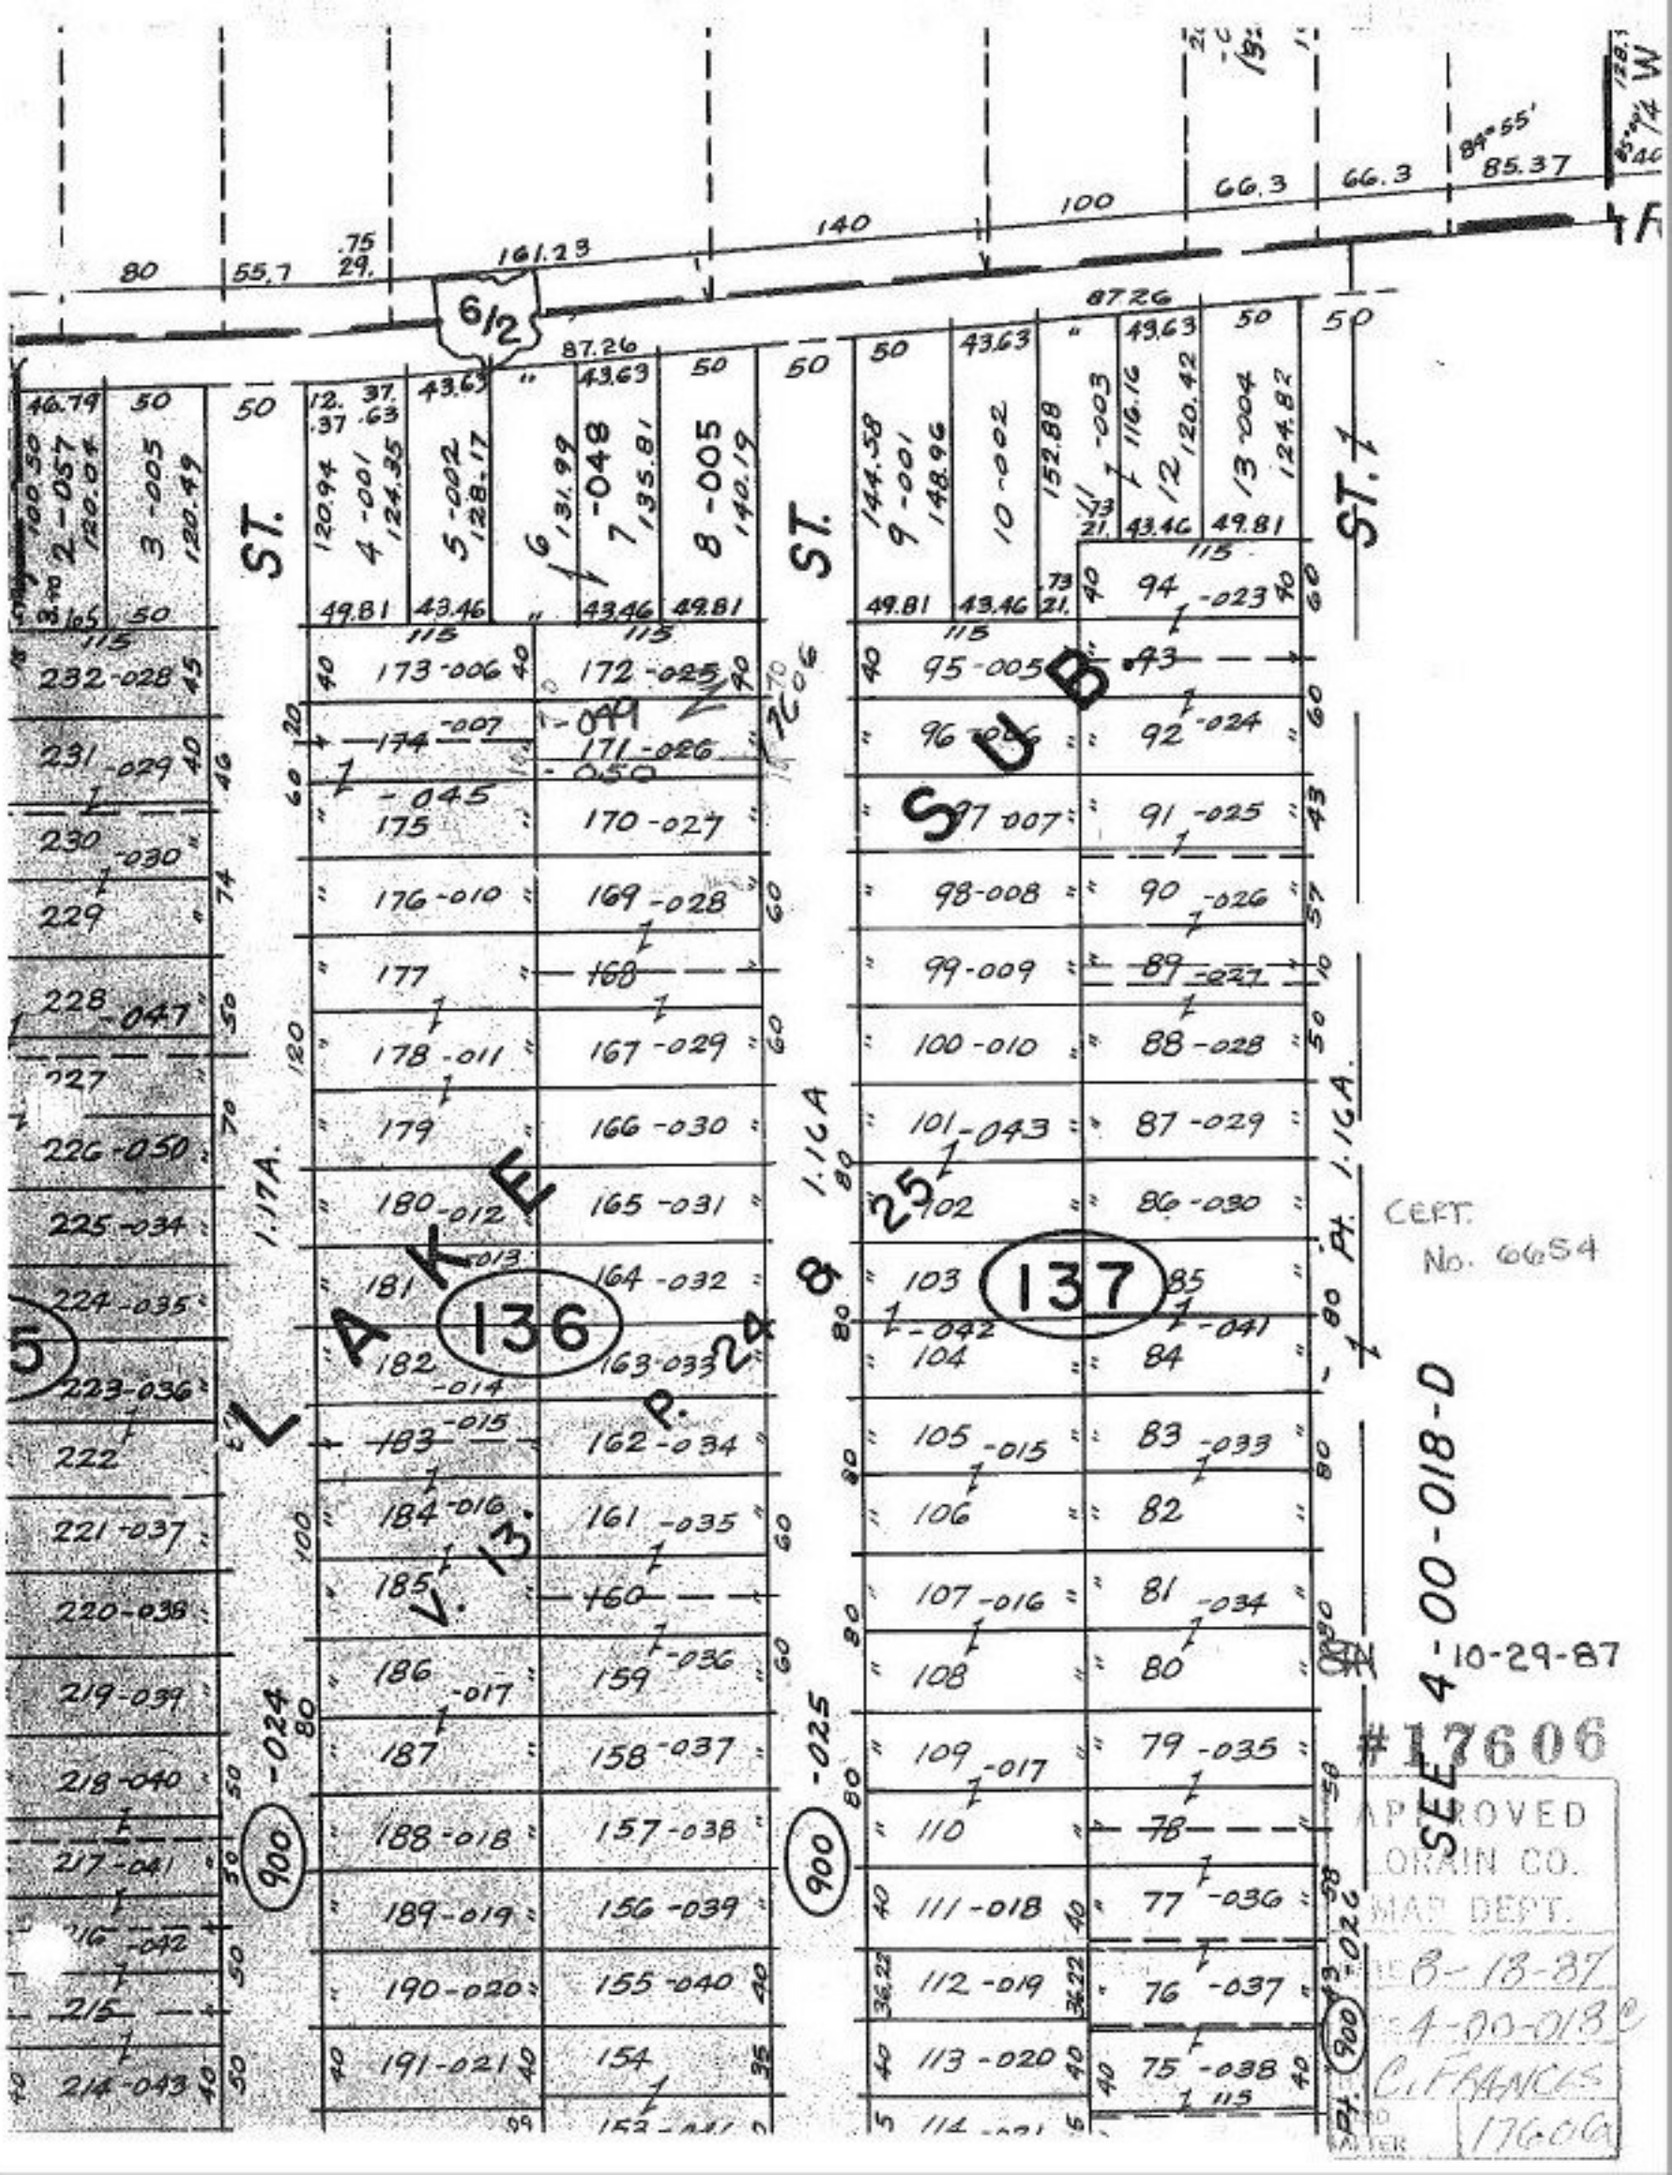
80
55.7
.75
29.
161.23
140
100
66.3
66.3
85.37
84°55'
87.26
6 1/2
ST.
ST.
ST.
SUB
LAKE
136
137
1.17A.
1.16A.
1.16A.
25
24
8
V. 13 P.
900
-024
-025
-026
CERT. No. 6654
4-00-018-D
4-10-29-87
#17606
SEE
APPROVED
LORAIN CO.
MAP DEPT.
8-18-87
4-00-018
C. FRANCES
17606