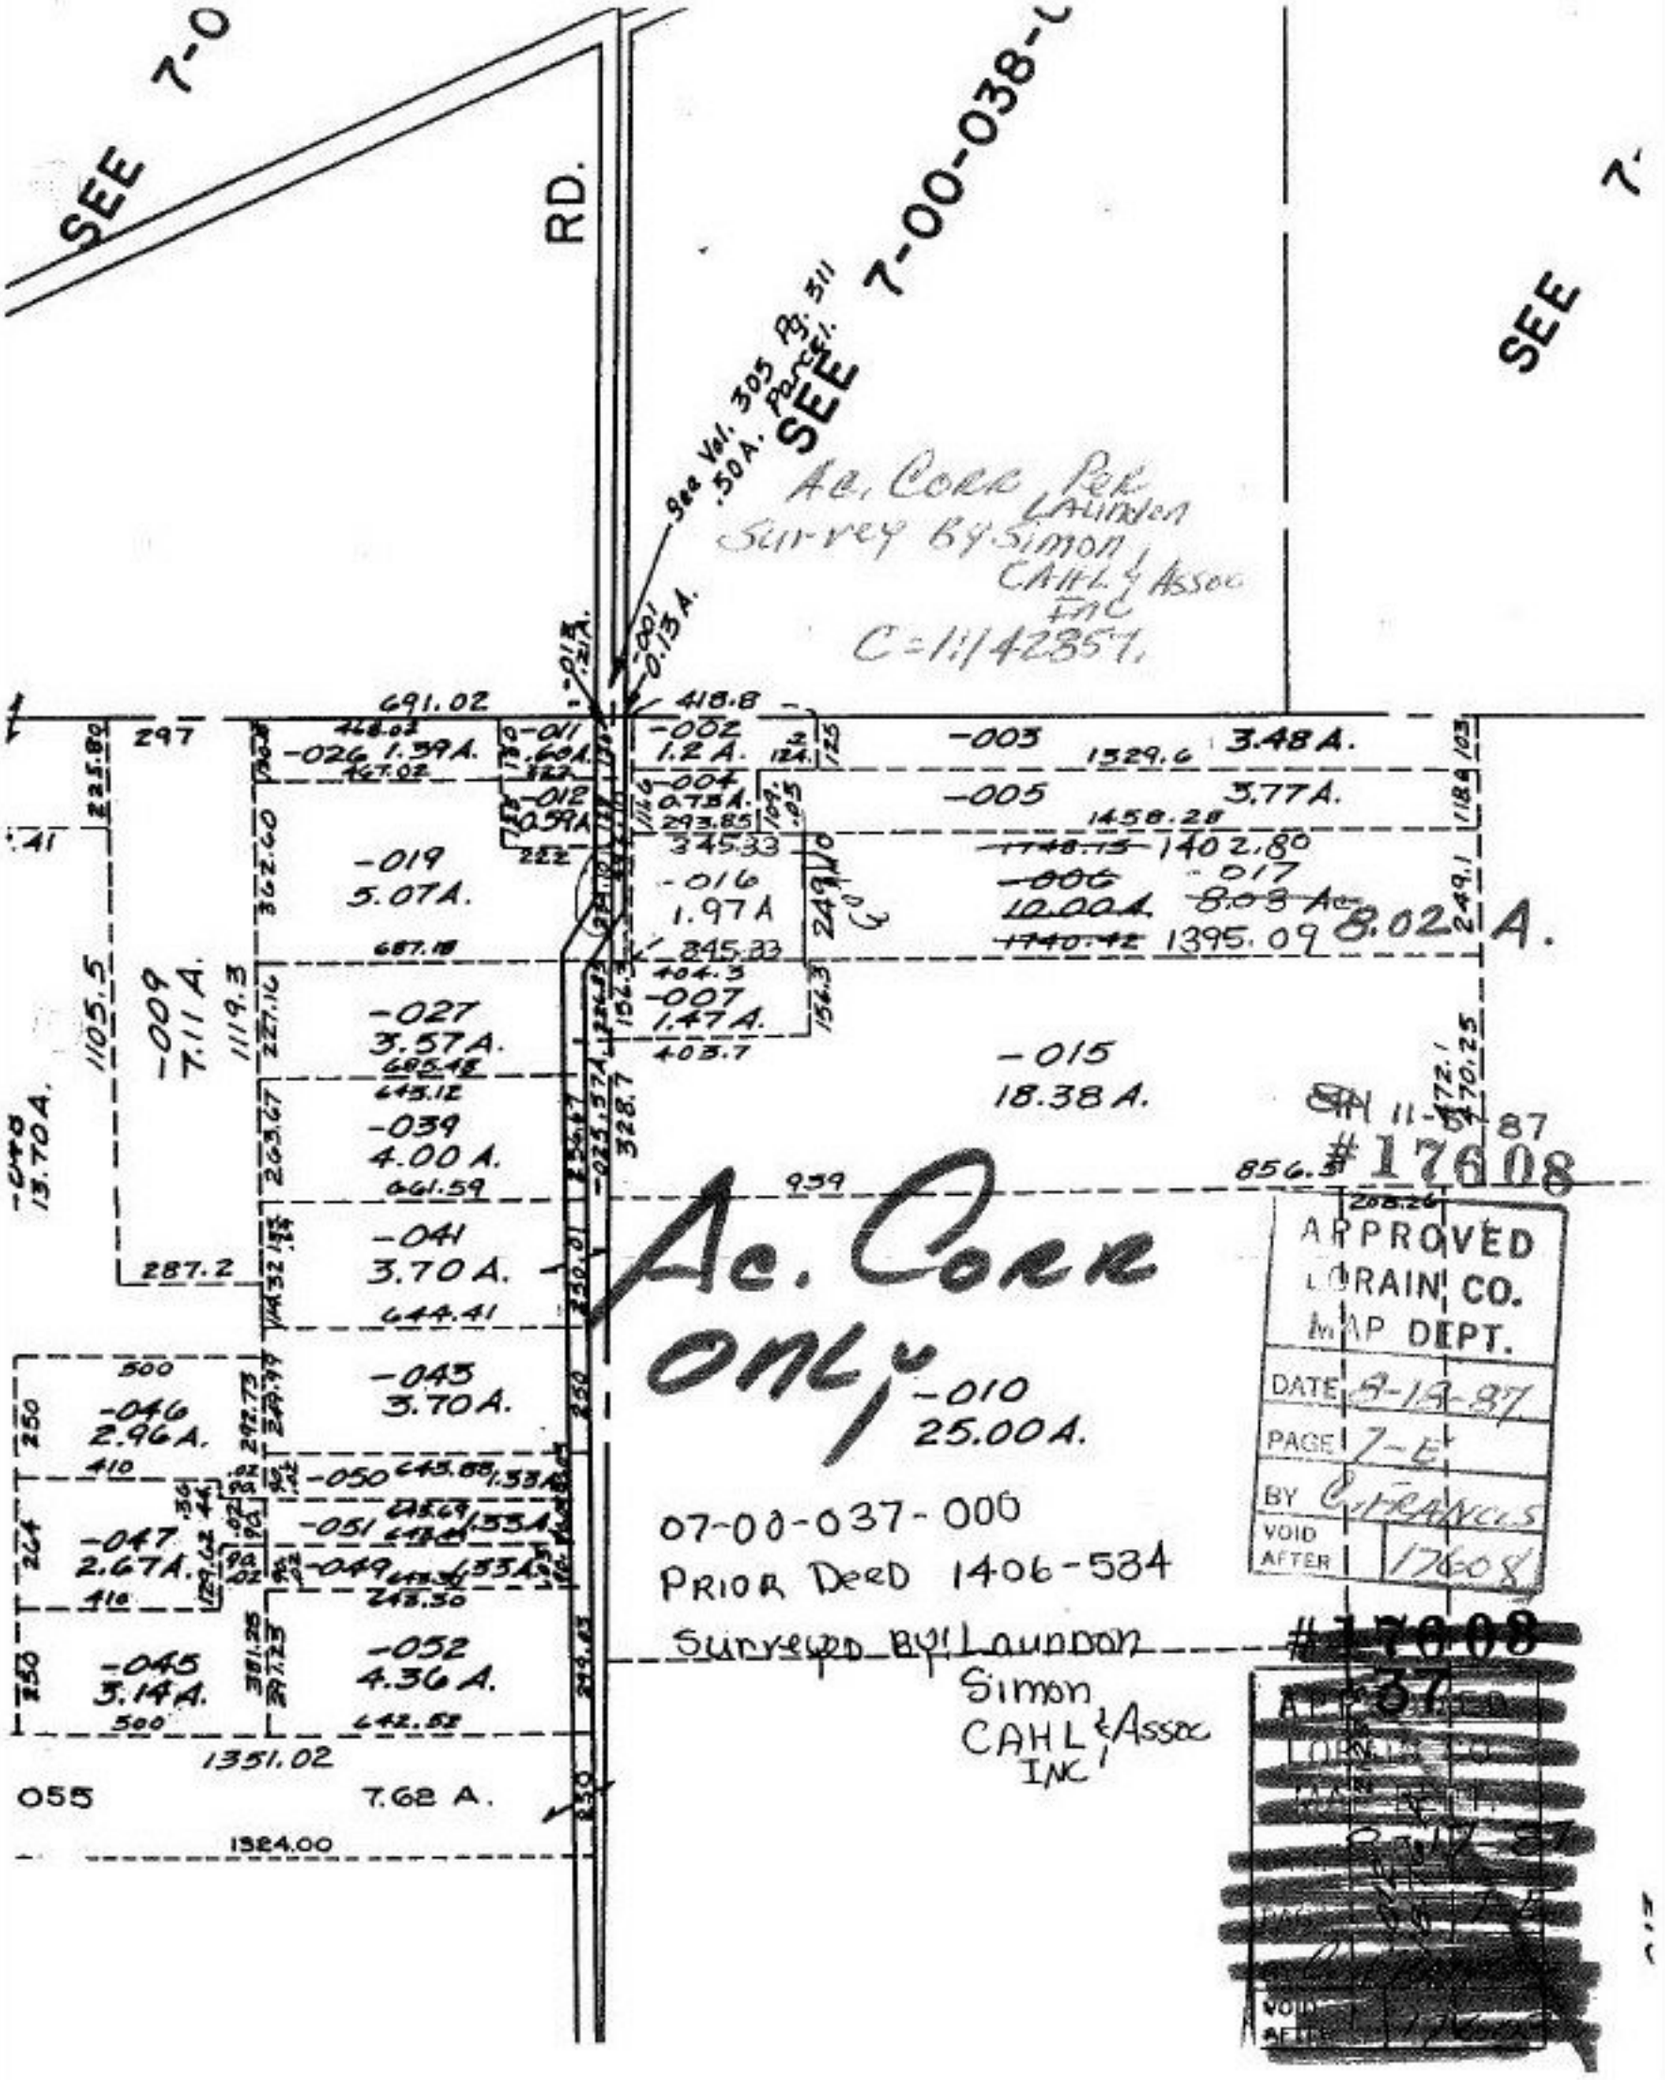
SEE 7-0
RD.
SEE 7-00-038-(
SEE 7-
See Vol. 305 Pg. 311 .50A. Parcel 1.
.21A.
.001 0.13A.
Ac. Corr Per Launder Survey By Simon CAHL & Assoc INC C=11/42857.
691.02
418.8
-026 1.39A.
-011 1.60A.
-002 1.2A.
-003 3.48A.
-012 0.39A.
-004 0.78A.
-005 3.77A.
-019 5.07A.
-016 1.97A
-006 10.00A.
-017 8.08 Ac.
8.02 A.
-009 7.11A.
-027 3.57A.
-007 1.47A.
-015 18.38A.
-039 4.00A.
-041 3.70A.
-043 3.70A.
-046 2.96A.
-050
-051
-049
-047 2.67A.
-045 3.14A.
-052 4.36A.
055 7.62 A.
1351.02
1324.00
Ac. Corr only
-010 25.00A.
07-00-037-006
PRIOR DEED 1406-584
Surveyed By Launder Simon CAHL & Assoc INC
SAH 11-87
#17608
APPROVED
LORAIN CO.
MAP DEPT.
DATE 9-19-97
PAGE 7-E
BY G. FRANCIS
VOID AFTER 17608
#17608
11-87
VOID