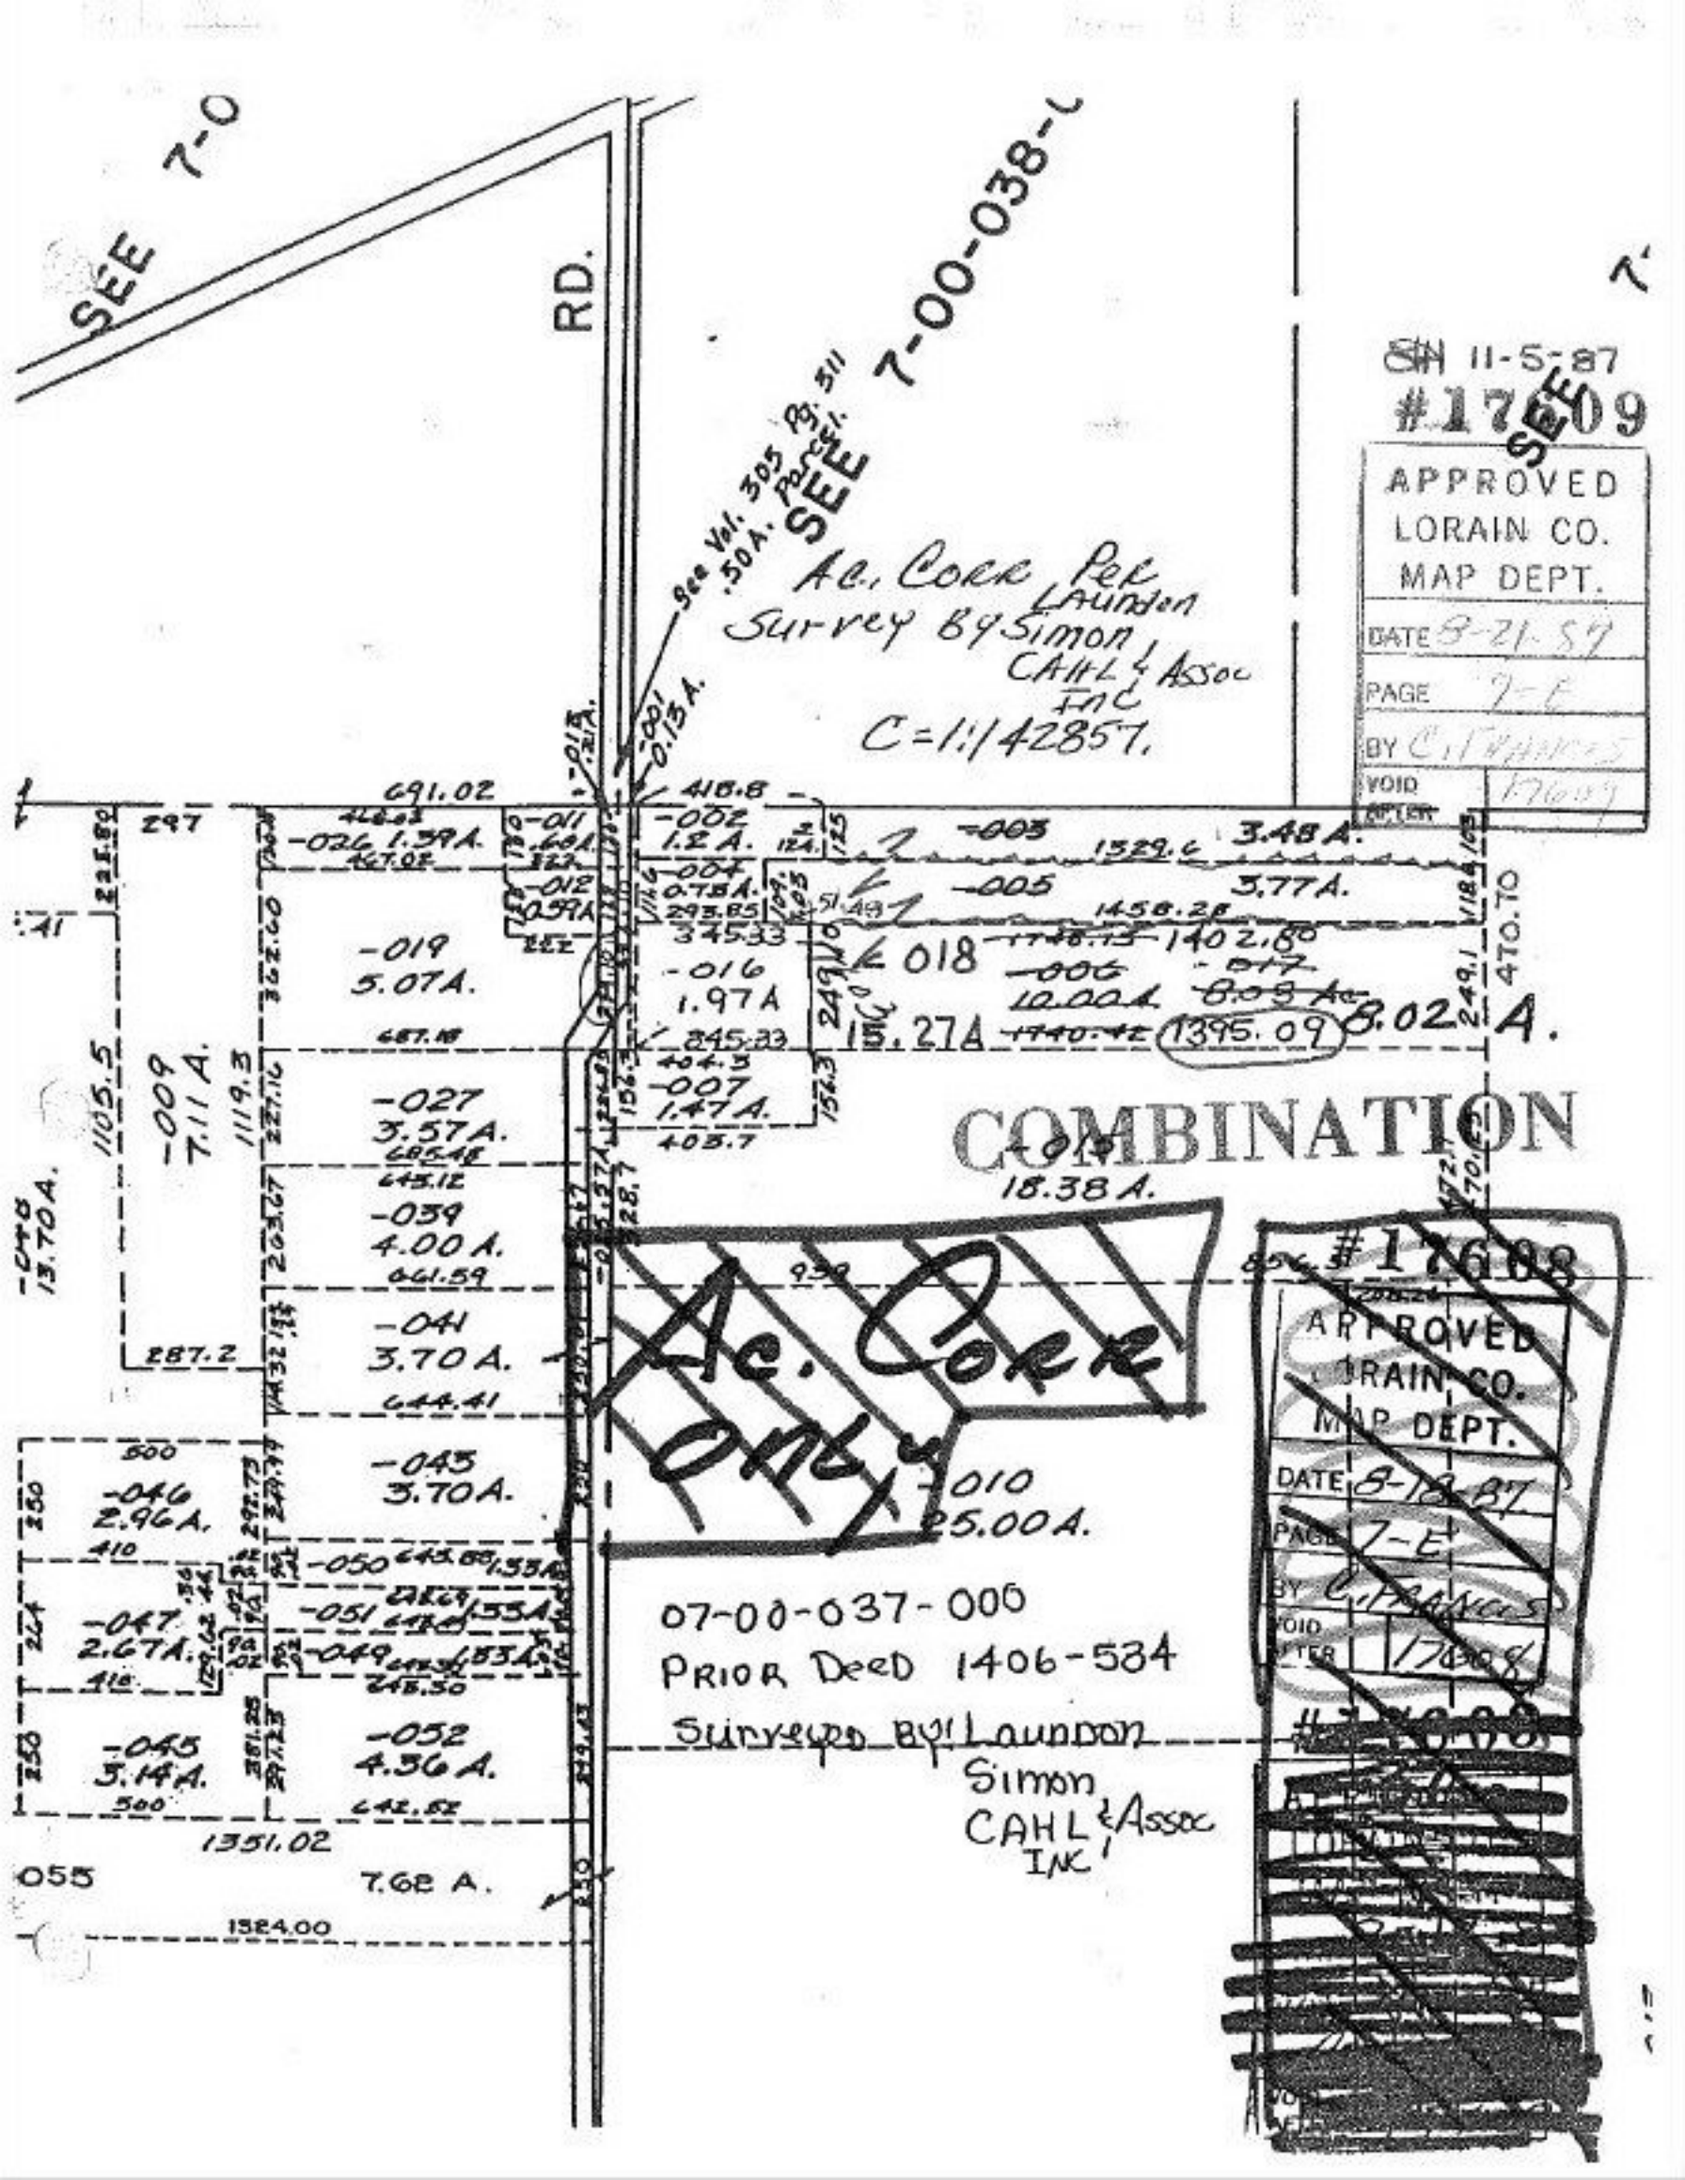
SEE 7-0
RD.
SEE 7-00-038-C
See Vol. 305 Pg. 311 .50A. Parcel 1.
SEE
SEE
SH 11-5-87
#1709
APPROVED
LORAIN CO.
MAP DEPT.
DATE 8-21-87
PAGE 7-E
VOID
AFTER
Ac. Cork Pck
Launder
Survey By Simon
CAHL & Assoc
INC
C=1:1/42857.
691.02
416.8
-026 1.39A.
-011 .60A.
-012 .59A
-002 1.2A.
-004 .78A.
-003
3.48A.
-005
3.77A.
1529.6
1456.28
1402.80
-019 5.07A.
-016 1.97A
018
-006 10.00A.
-017 8.05 Ac.
8.02 A.
15.27A
1395.09
-009 7.11A.
-027 3.57A.
-007 1.47A.
COMBINATION
18.38A.
-039 4.00A.
-041 3.70A.
-045 3.70A.
-046 2.96A.
-047 2.67A.
-050
-051
-049
-052 4.36A.
-045 3.14A.
-010 25.00A.
Ac. Cork Only
#17688
APPROVED
LORAIN CO.
MAP DEPT.
DATE 8-18-87
PAGE 7-E
VOID
07-00-037-006
PRIOR DEED 1406-534
Surveyed By: Launder
Simon
CAHL & Assoc
INC
7.68 A.
1324.00
1351.02
055