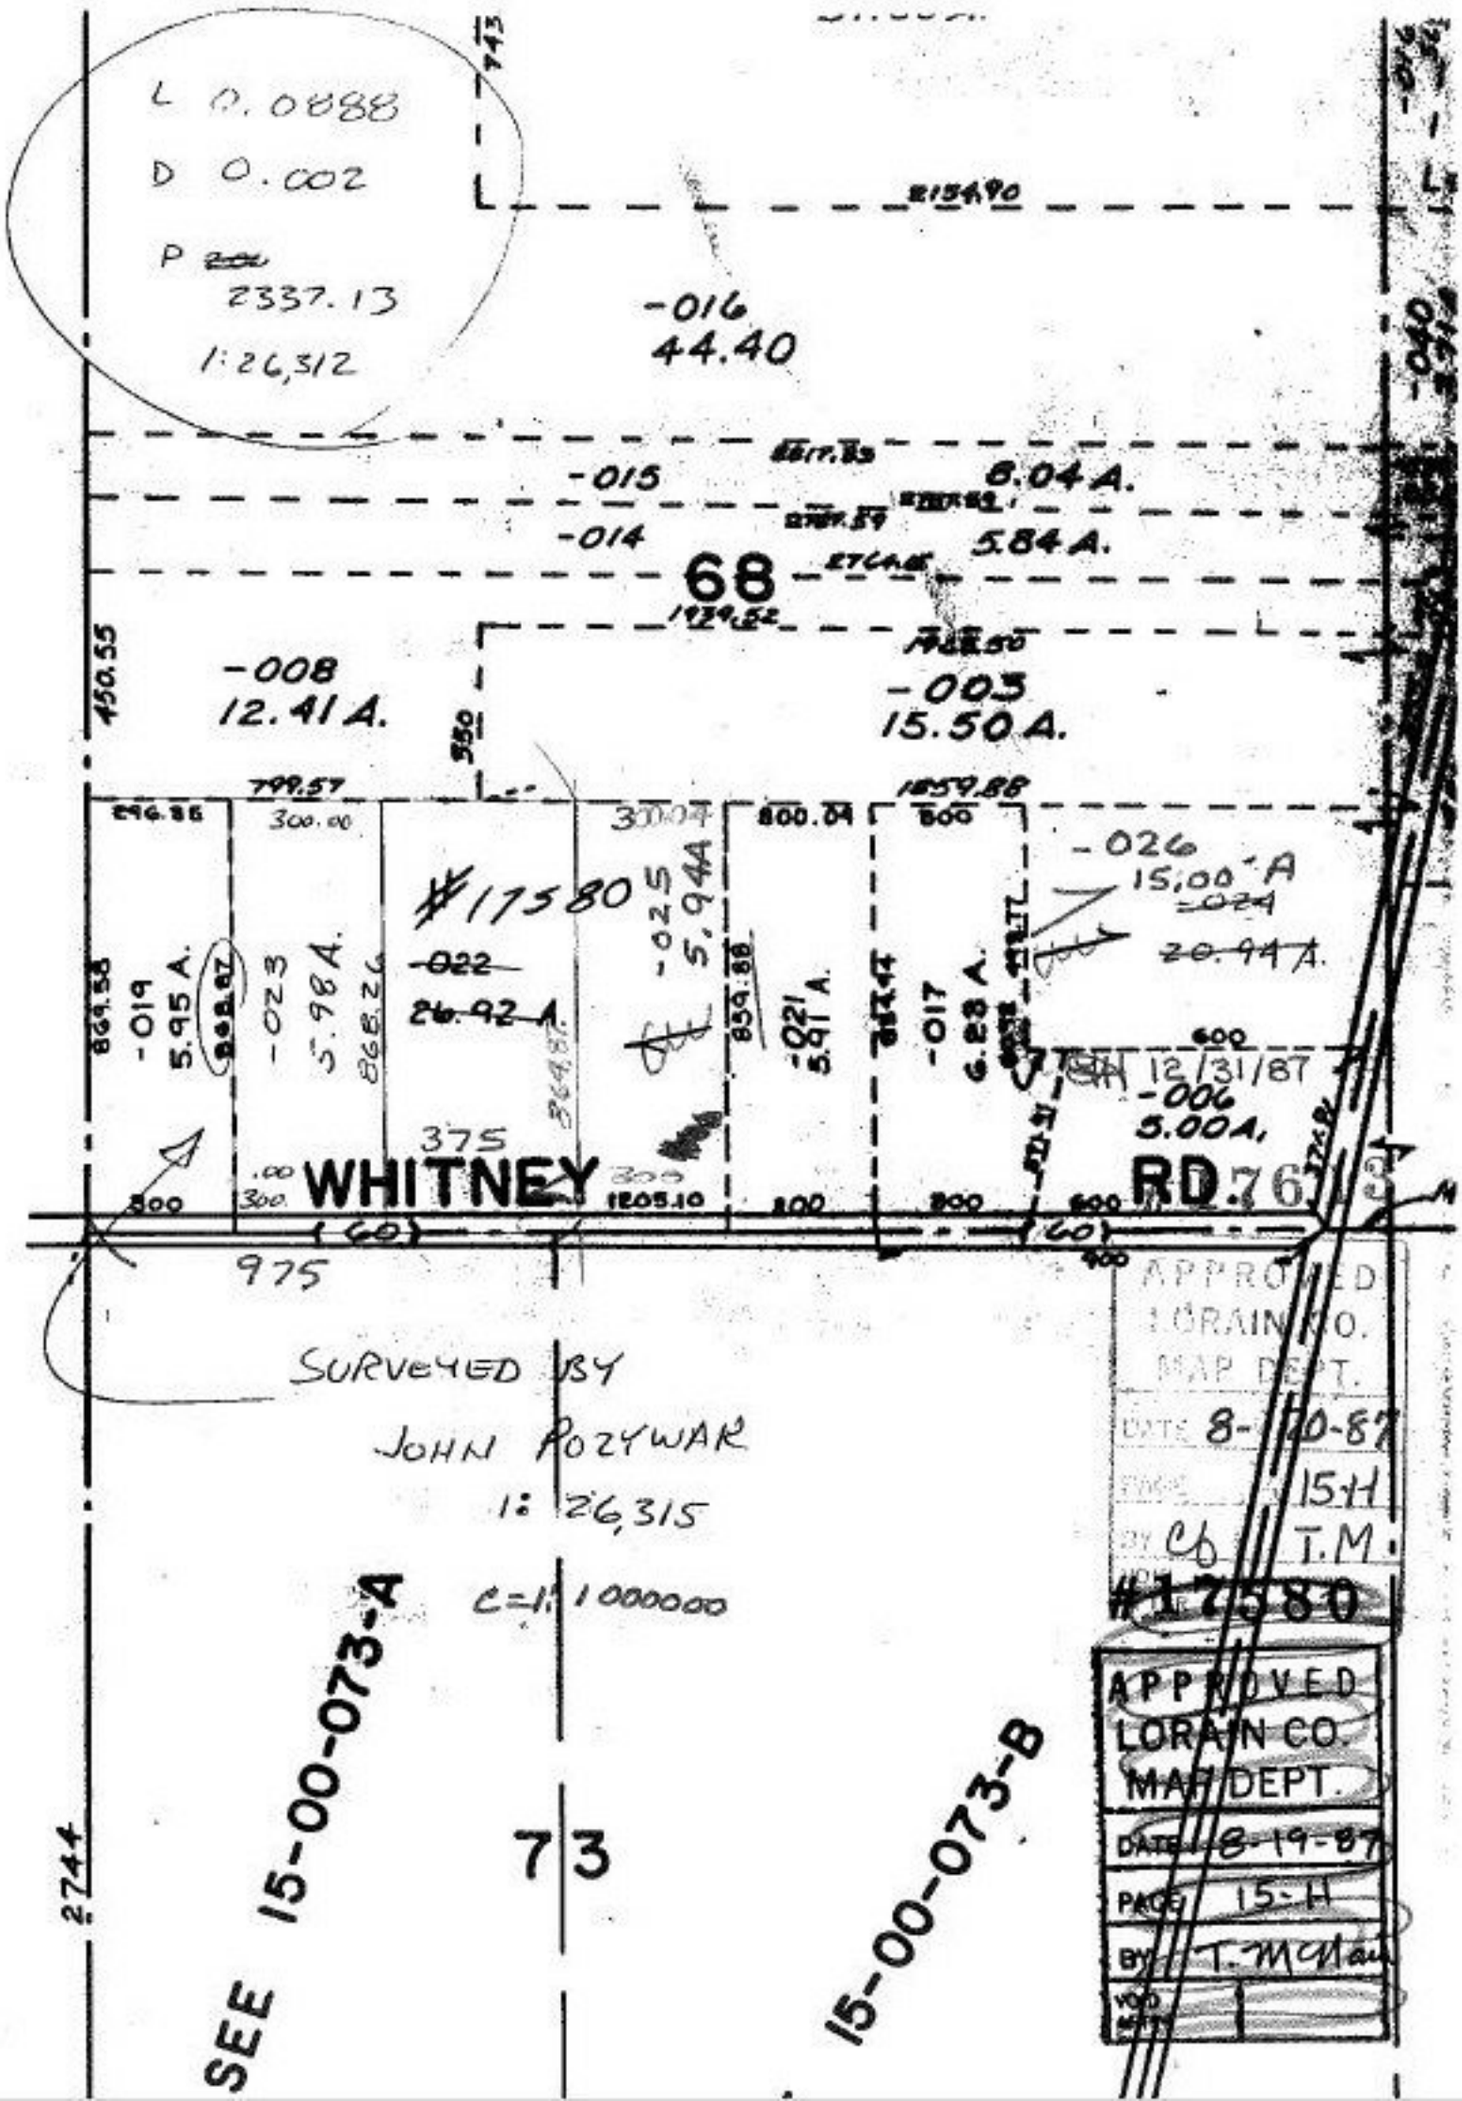
L 0.0088
D 0.002
P
2337.13
1:26,312
-016
44.40
-015
8.04 A.
-014
5.84 A.
68
-008
12.41 A.
-003
15.50 A.
-026
15.00 A
-024
20.94 A.
-025
5.944
-022
26.92 A.
-021
5.91 A.
-019
5.95 A.
-023
5.98 A.
-017
6.28 A.
#17580
12/31/87
-006
5.00 A.
WHITNEY
RD.
375
975
SURVEYED BY
JOHN POZYWAR
1: 26,315
C=1:1000000
APPROVED
LORAIN CO.
MAP DEPT.
DATE 8-10-87
PAGE 15-H
BY C.J. T.M.
#17580
APPROVED
LORAIN CO.
MAP DEPT.
DATE 8-19-87
PAGE 15-H
BY T. McNair
SEE 15-00-073-A
15-00-073-B
73
2744