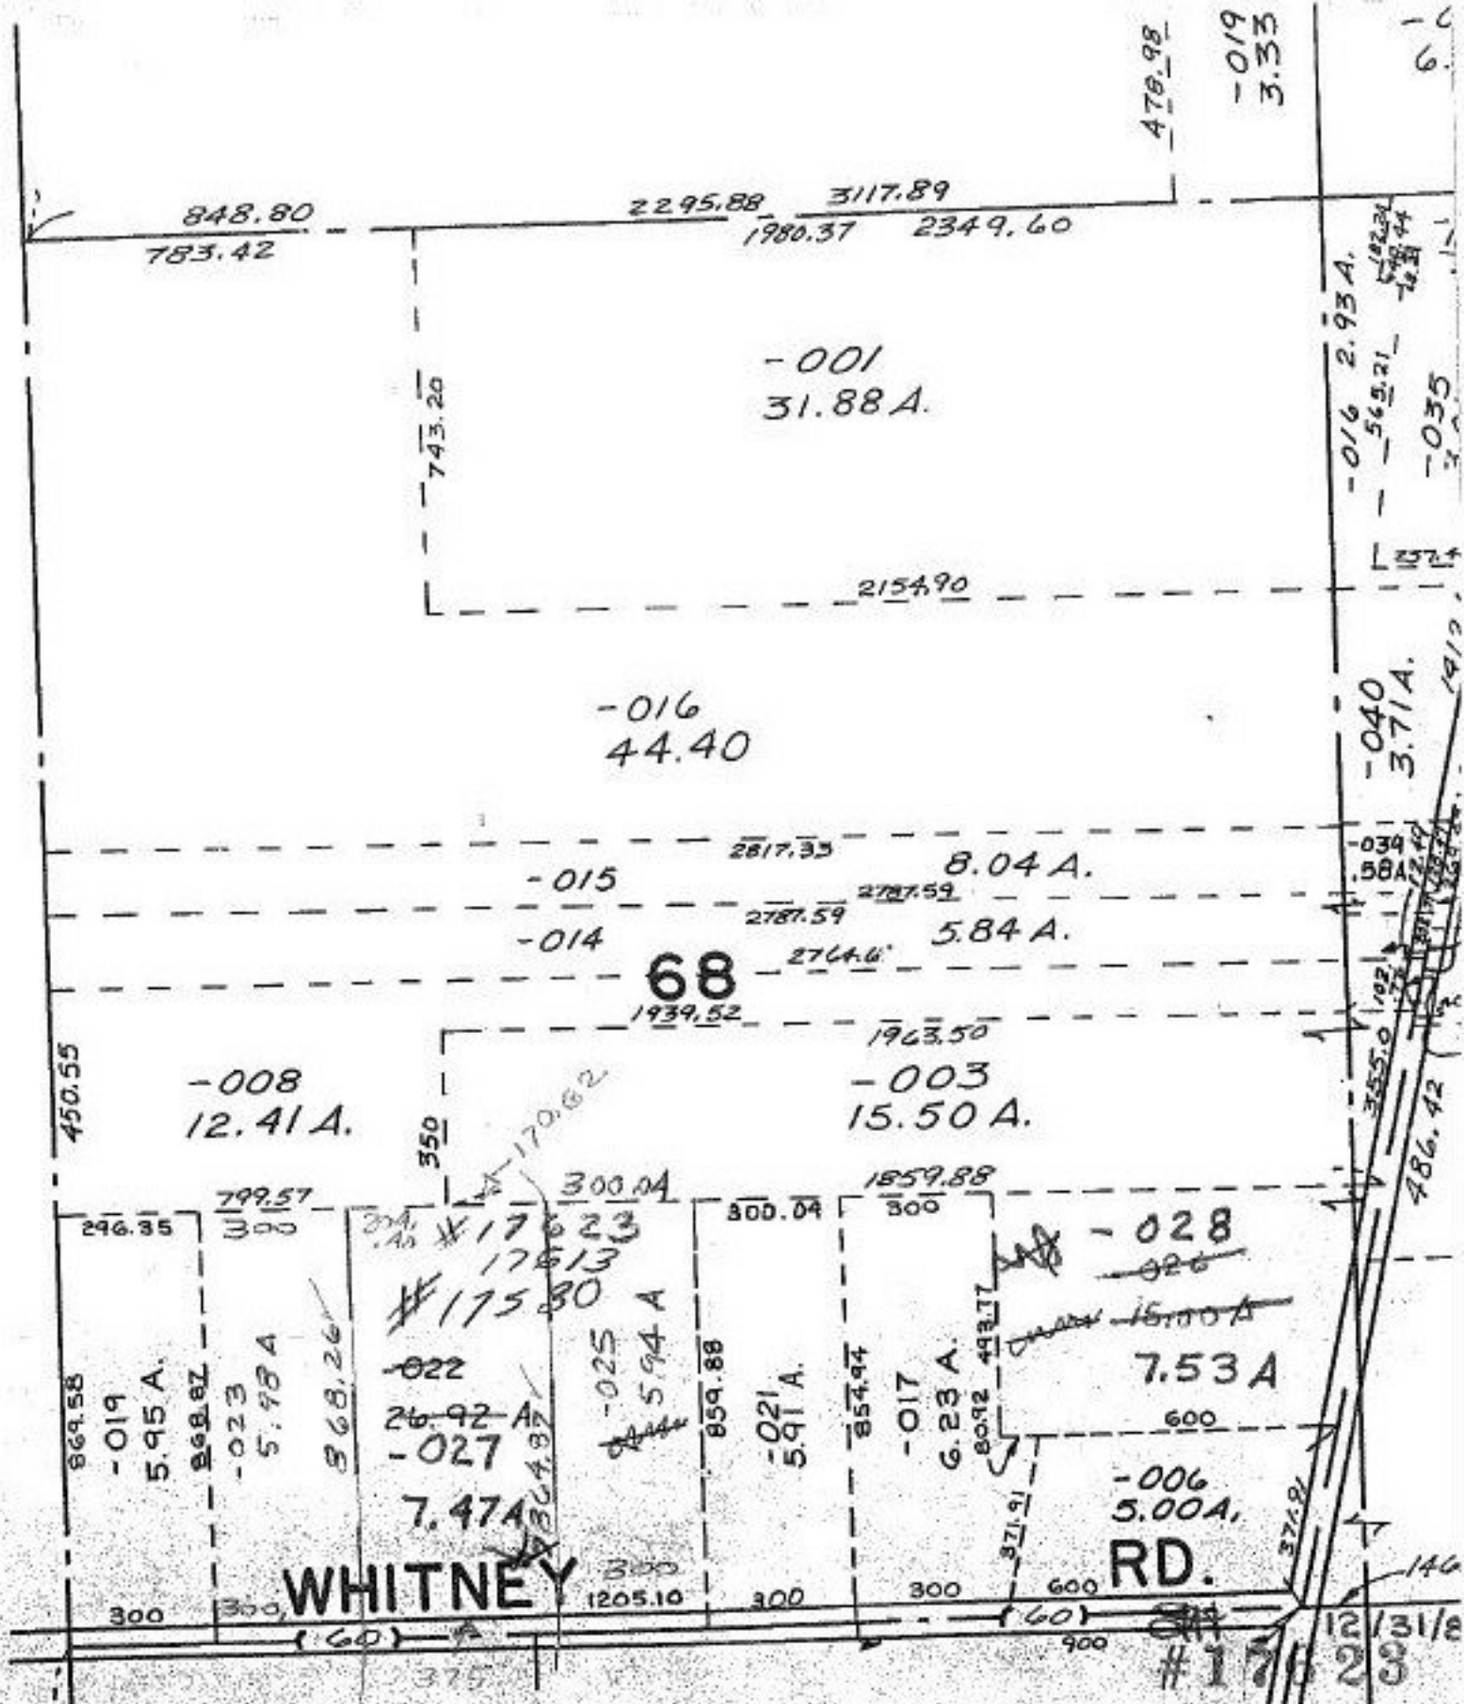

15-00-068-000
Prior Dee D 1284/670
Surveyed by John Pozywak
Reg Surveyor

APPROVED
LORAIN CO.
MAP DEPT.
DATE 8-27-87
PAGE 15-H
BY
VOID AFTER 17623

073-A

COMPLETE