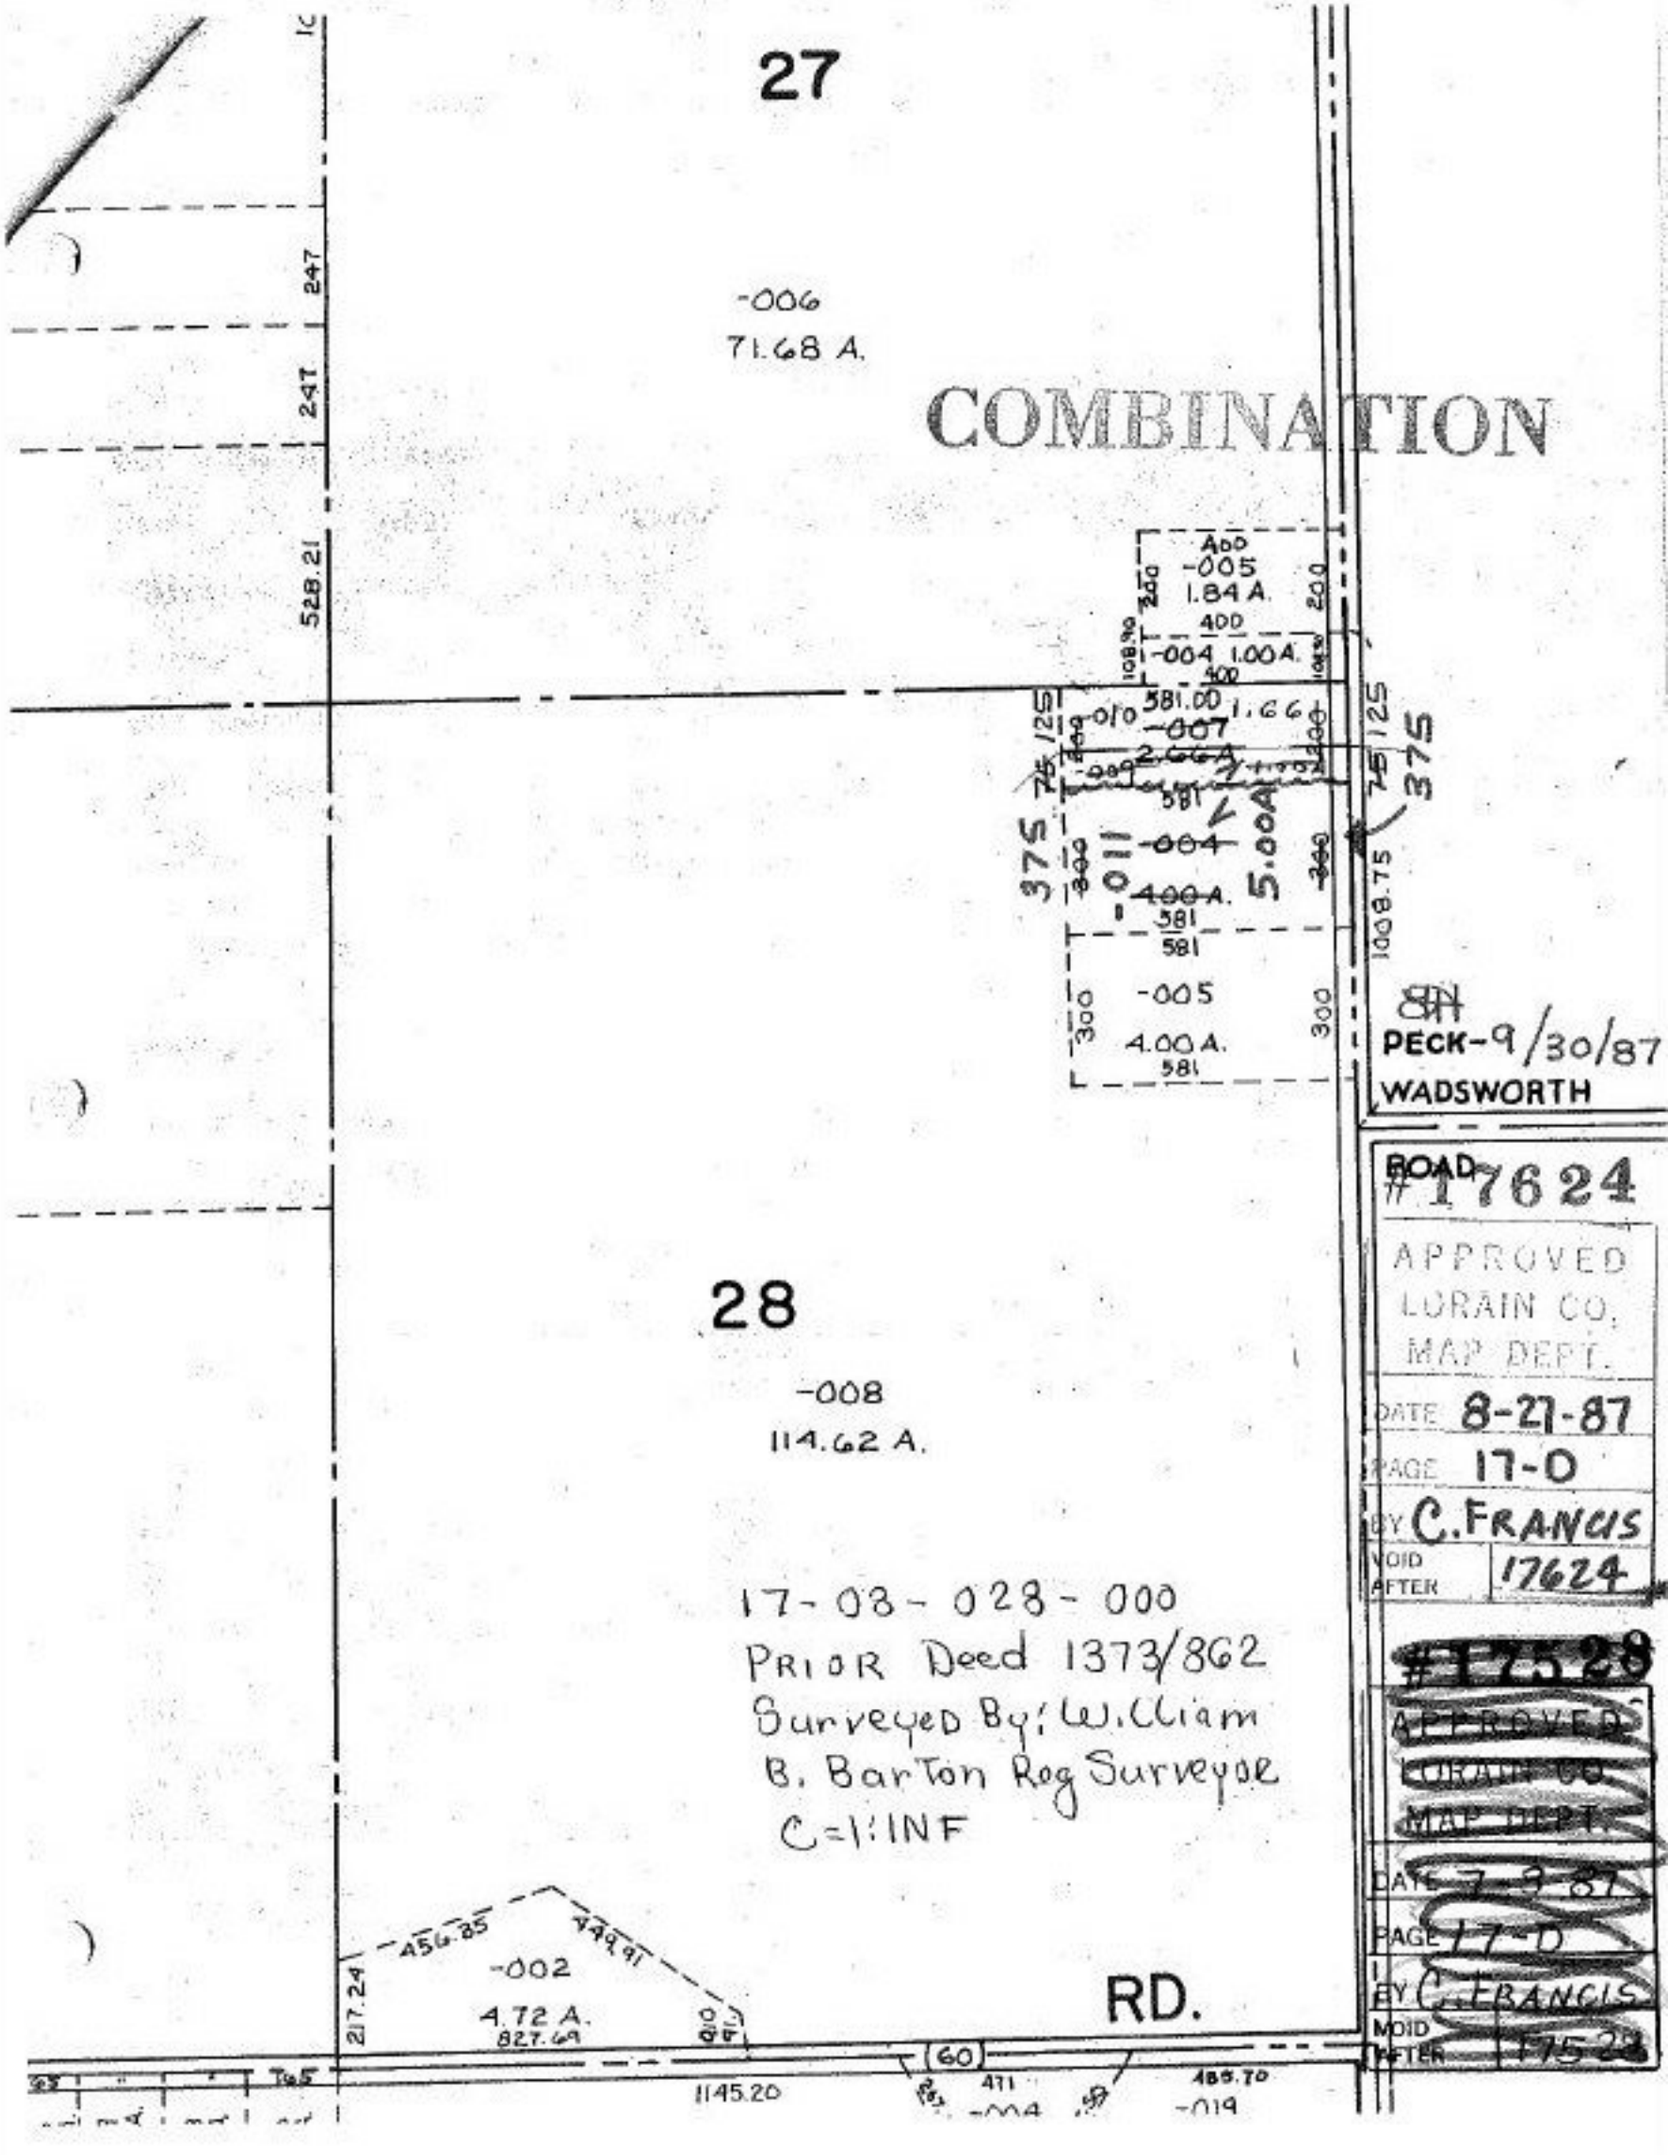
27
-006
71.68 A.
COMBINATION
528.21
247
247
ADD
-005
1.84 A.
400
-004 1.00 A.
400
581.00
-010
-007
1.66
2.66 A.
581
-004
4.00 A.
581
581
-005
4.00 A.
581
375
375
125
125
5.00 A
1008.75
300
300
28
-008
114.62 A.
17-08-028-000
PRIOR Deed 1373/862
Surveyed By: William
B. Barton Reg Surveyor
C=1:INF
456.85
449.91
-002
4.72 A.
827.69
217.24
RD.
60
1145.20
471
-004
485.70
-019
PECK-9/30/87
WADSWORTH
ROAD #17624
APPROVED
LORAIN CO.
MAP DEPT.
DATE 8-27-87
PAGE 17-D
BY C. FRANCIS
VOID AFTER 17624
#17528
APPROVED
LORAIN CO.
MAP DEPT.
DATE 7-9-87
PAGE 17-D
BY C. FRANCIS
VOID AFTER 17528