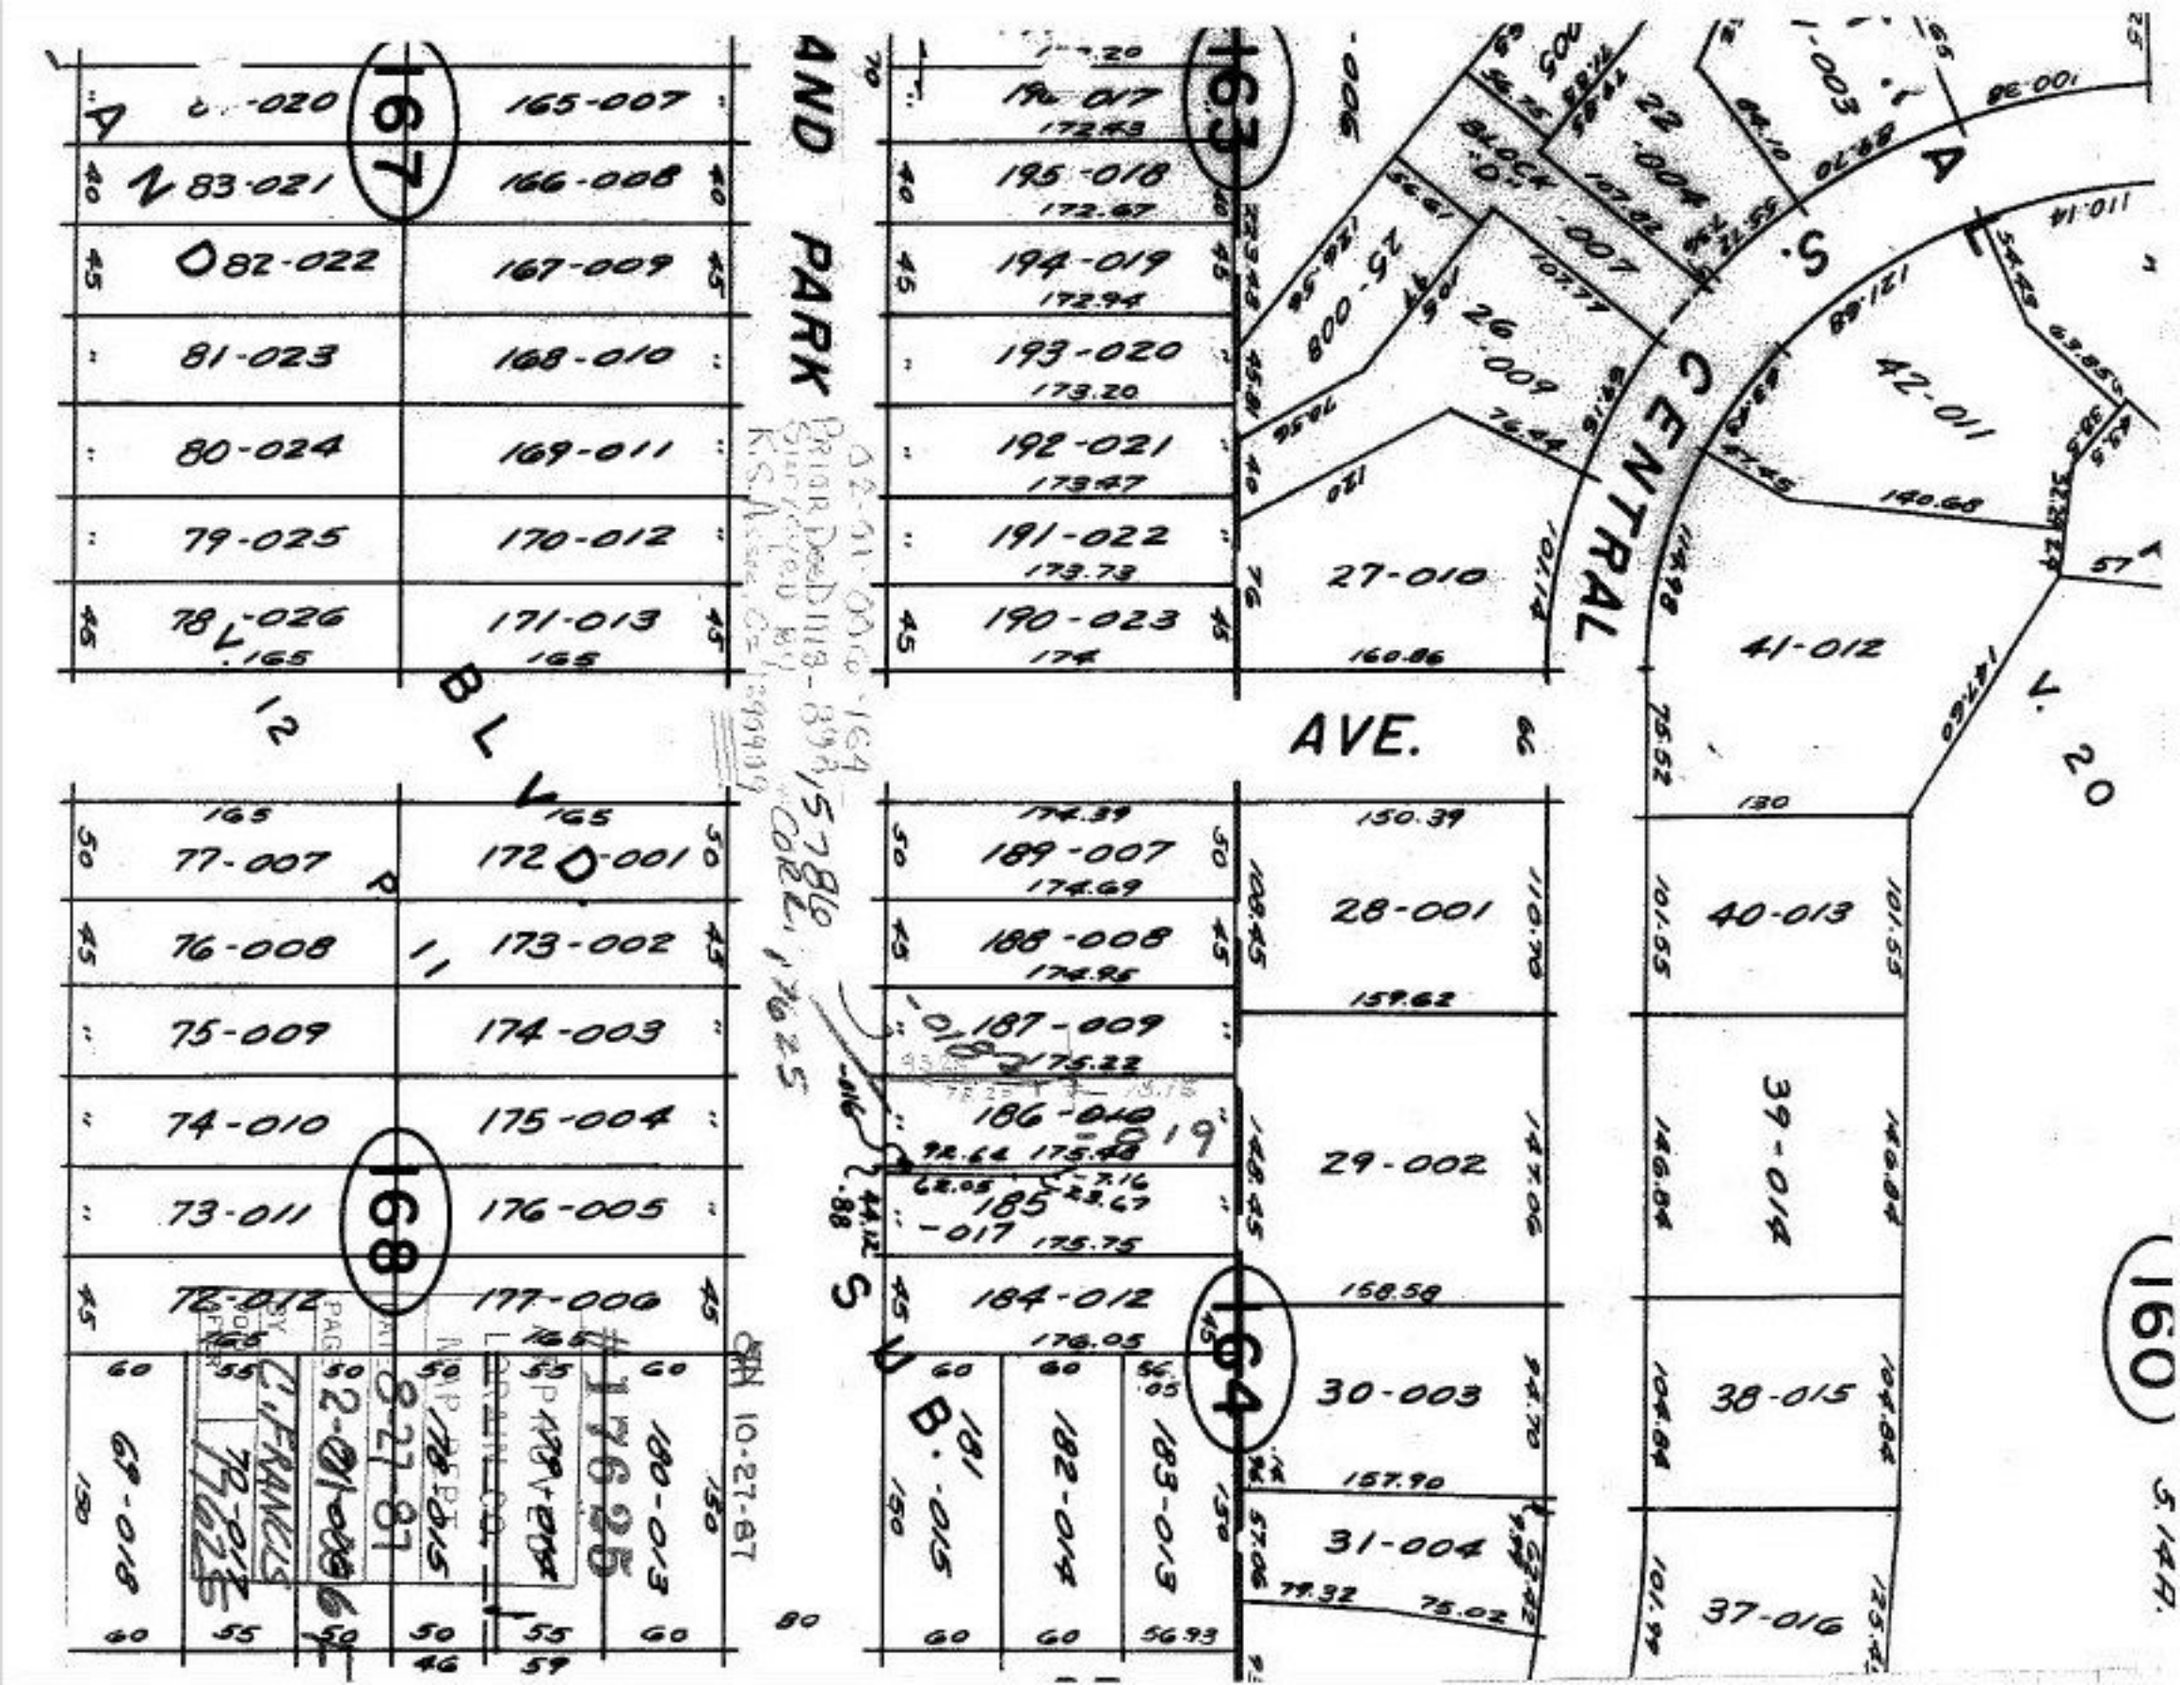
AND PARK
AVE.
CENTRAL
AVE.
S. 14TH.
BLK 167
BLK 168
BLK 163
BLK 164
BLK 160
BLK 20
165-007
166-008
167-009
168-010
169-011
170-012
171-013
172-001
173-002
174-003
175-004
176-005
177-006
195-018
194-019
193-020
192-021
191-022
190-023
189-007
188-008
187-009
186-010
185-017
184-012
28-001
29-002
30-003
31-004
27-010
41-012
42-011
40-013
39-014
38-015
37-016
26-009
(PRIOR DED 1119-899)
(SURVEYED BY)
10-27-87