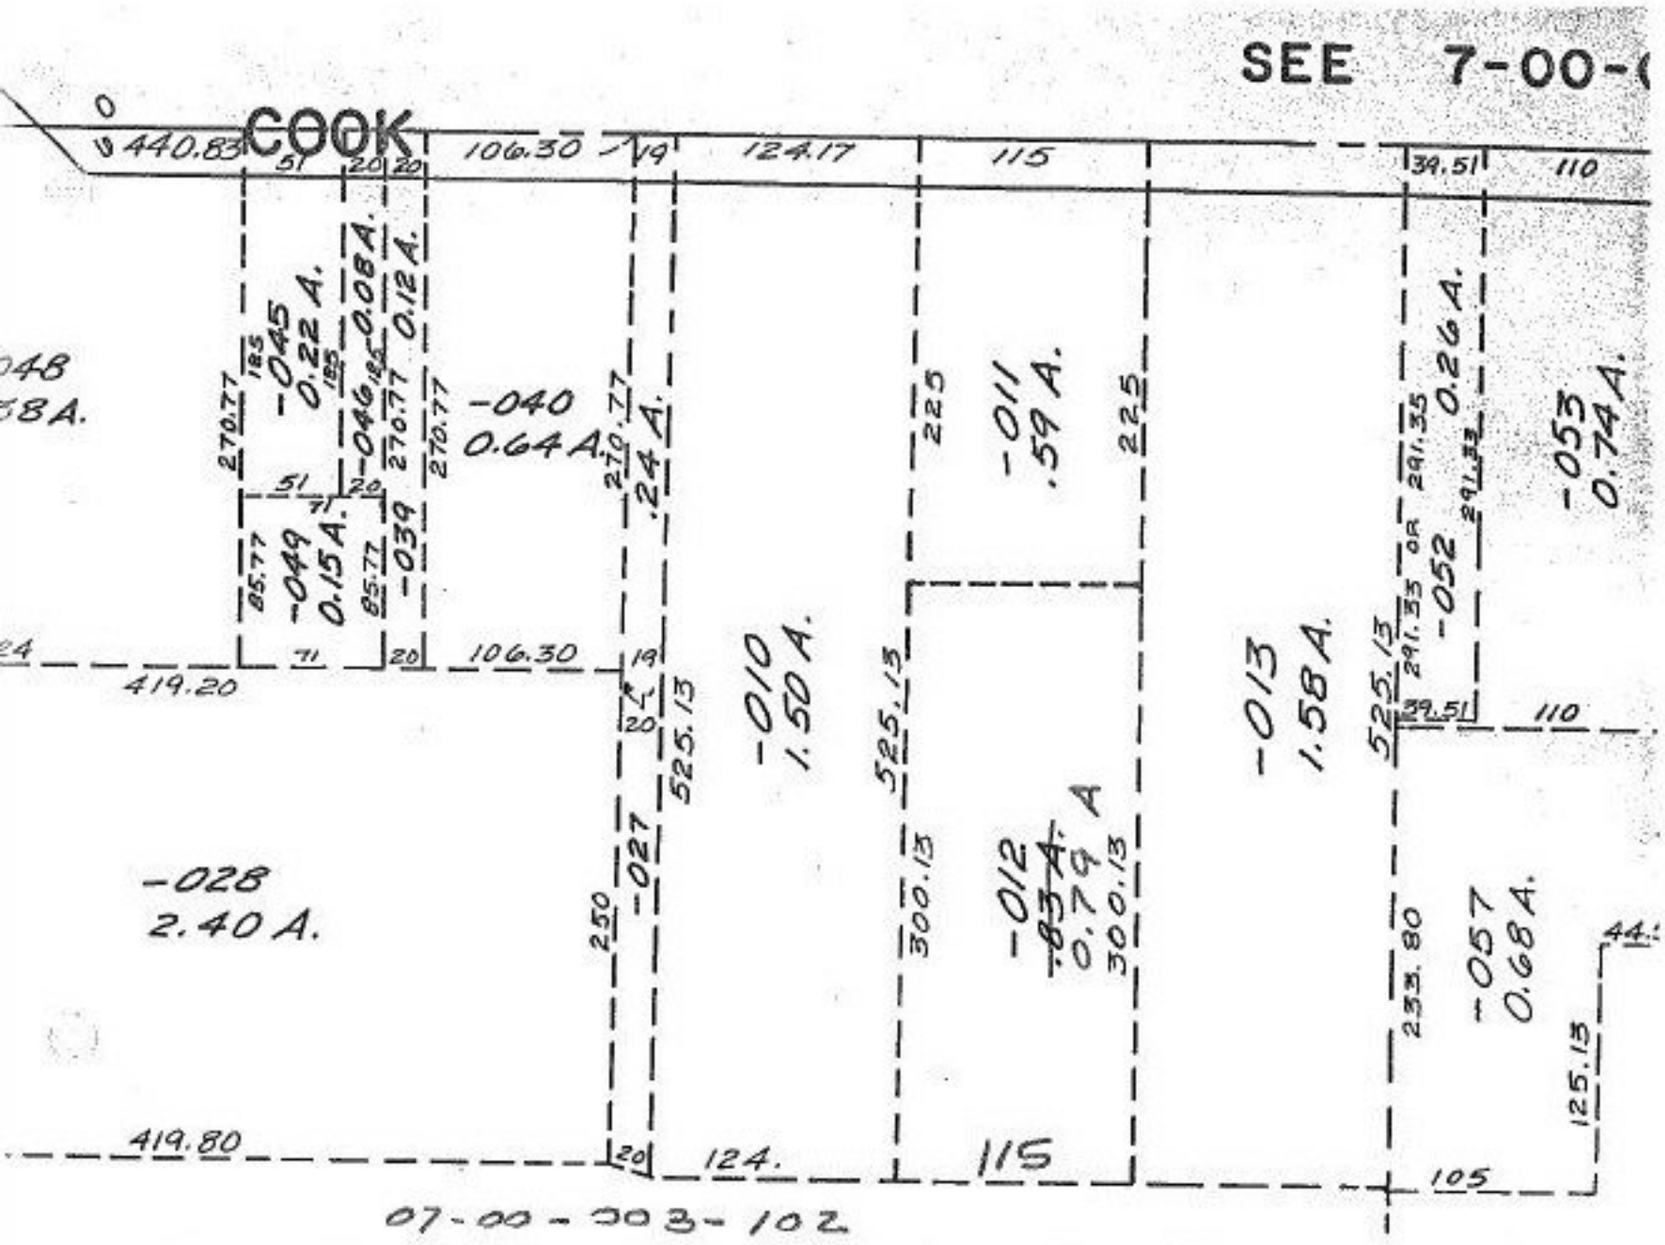

Ac. Corr. per CALC. of Deed by TAX MAP Dept.

Prior Deed 627-471

C=1.1NF.

Ac. Corr.

11-5-87

#17629

APPROVED
LORAIN CO.
MAP DEPT.
DATE 8-31.87
PAR 7-00-003-B
BY C. FRANCIS
VOID AFTER 17629