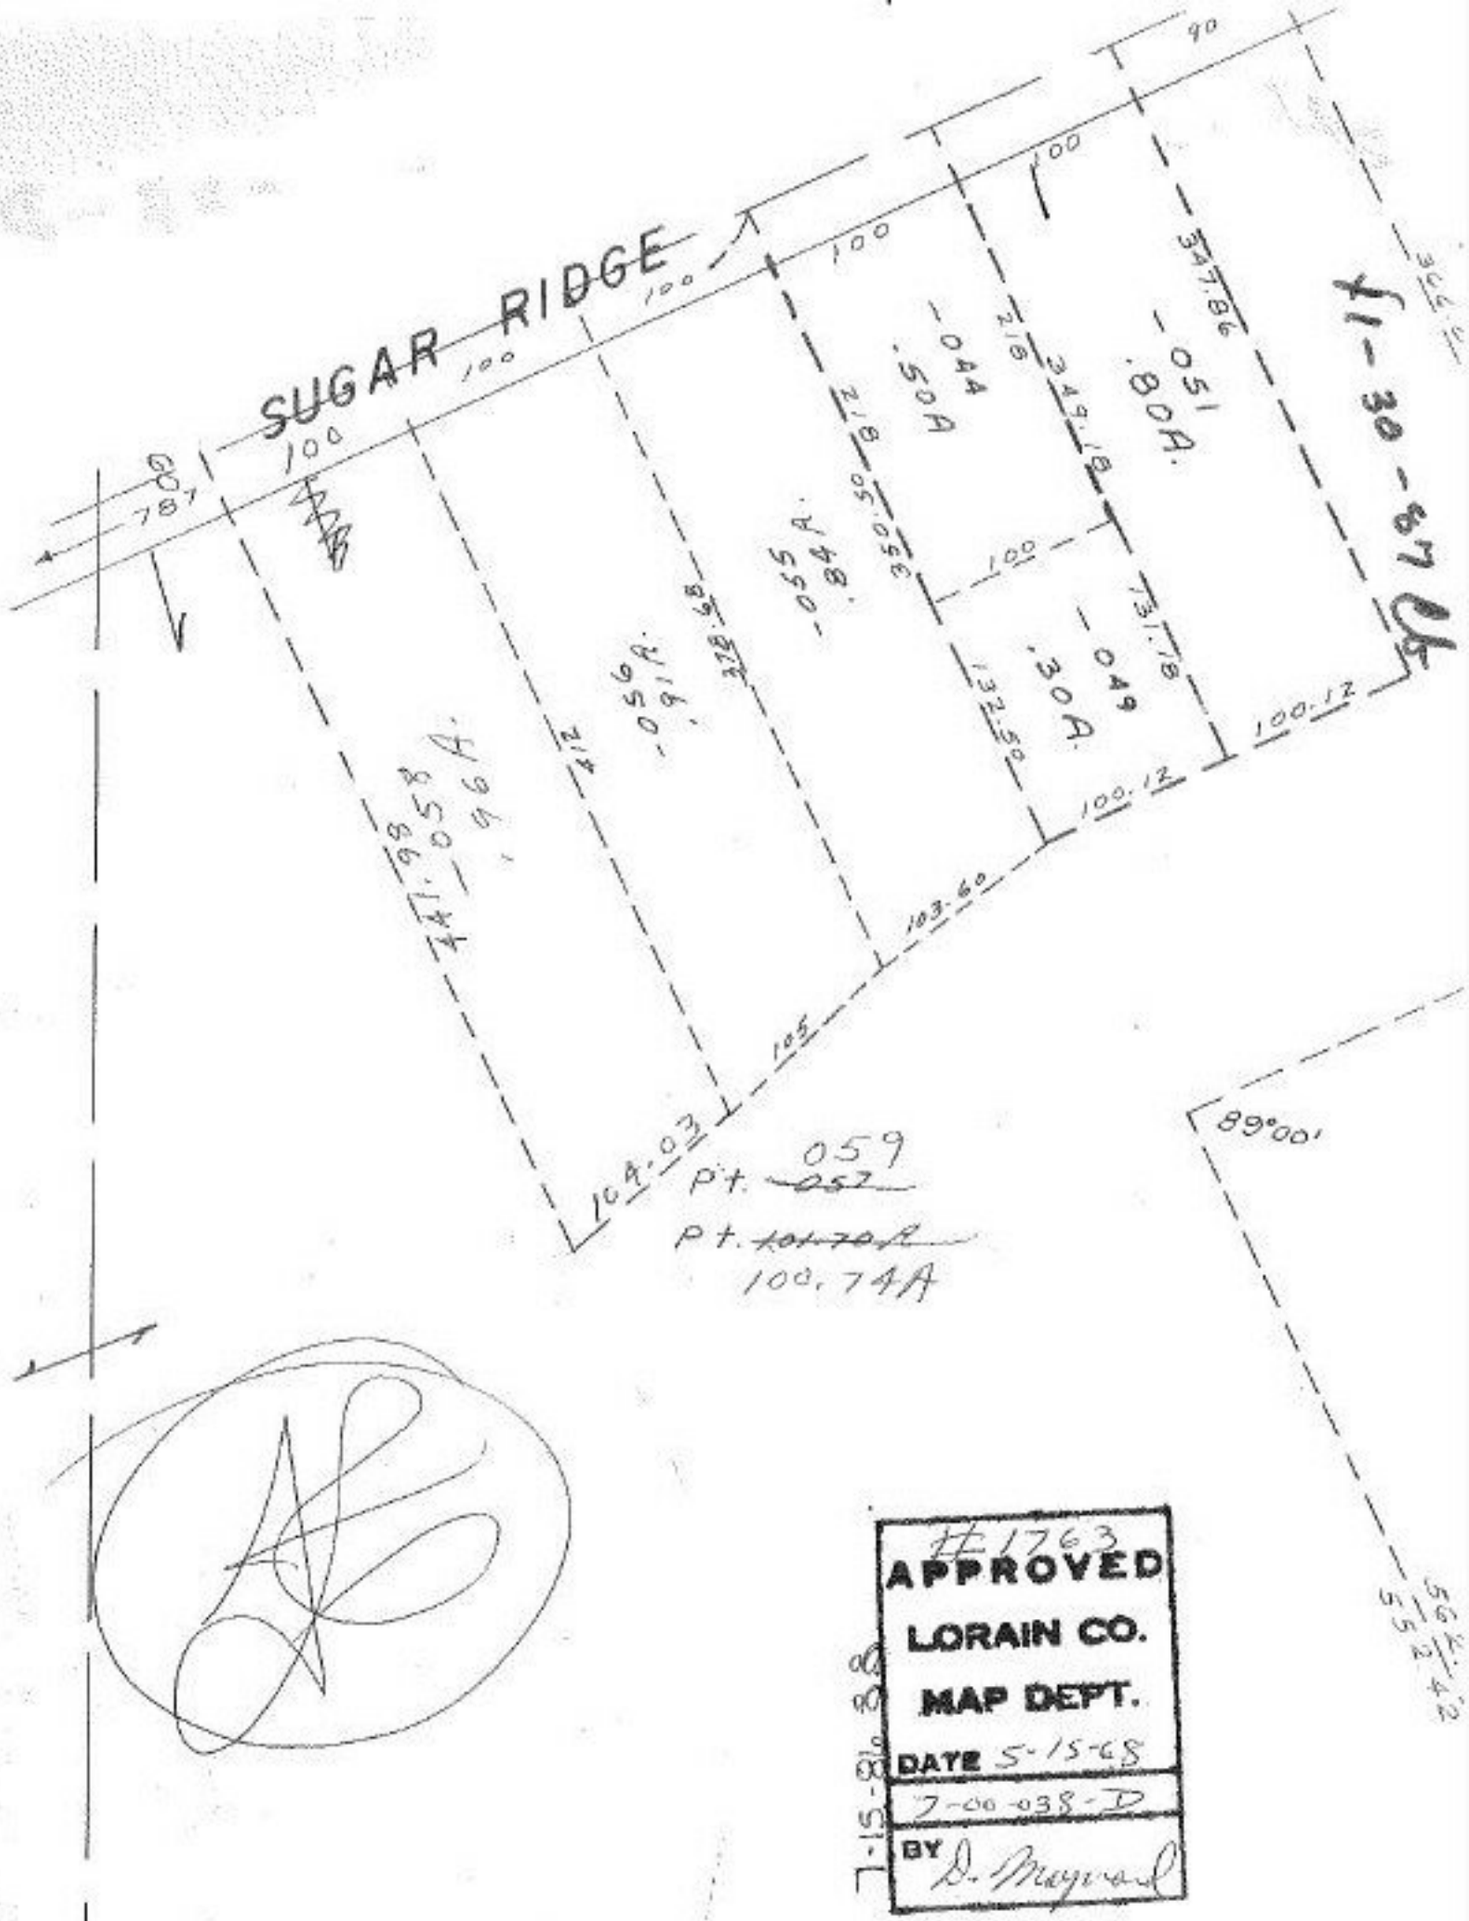

DONE 7/8/68 — W. Kochis