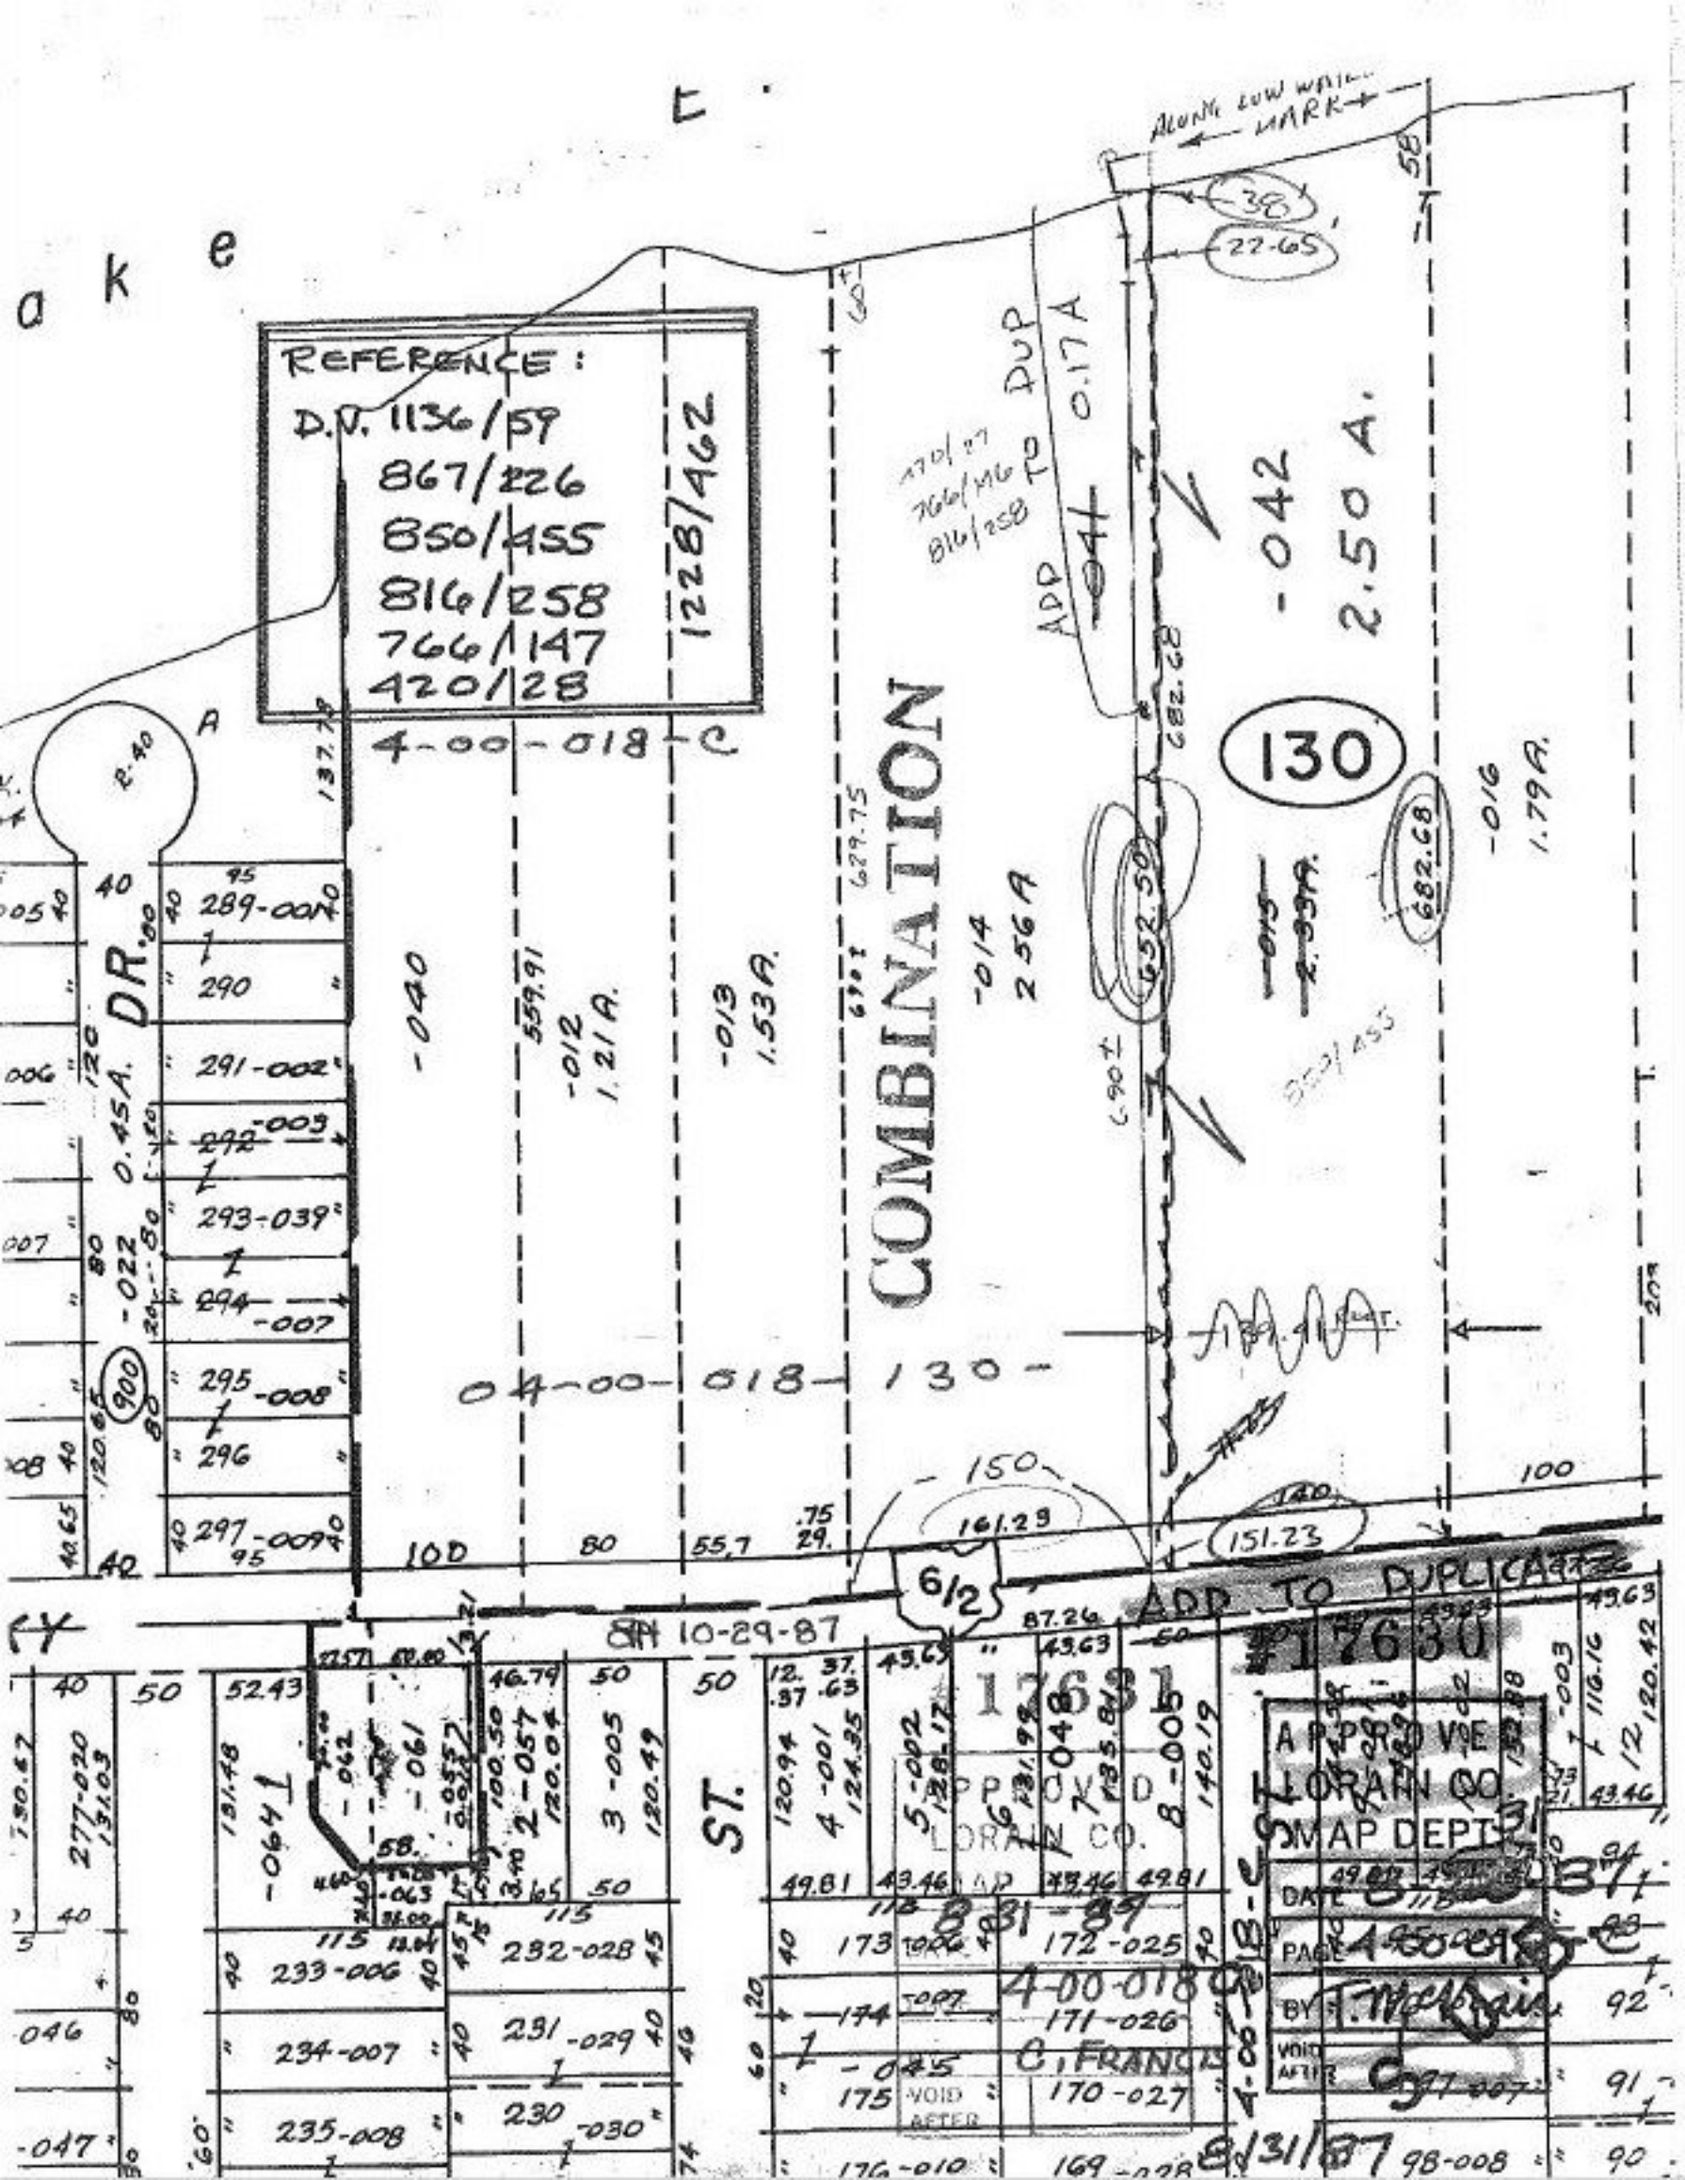
REFERENCE:
D.N. 1136/59
867/226
850/455
816/258
766/147
420/28
12287/462
4-00-018-C
COMBINATION
ADD 0.17A
DUP
770/27
766/146
816/258
-042
2.50 A.
130
-016
1.79A.
-040
0.45A.
-022
-012
1.21A.
-013
1.53A.
-014
2.56A
-015
2.93A.
682.68
682.50
629.75
559.91
DR.
289-004
290
291-002
292-003
293-039
294-007
295-008
296
297-009
04-00-018-130
ADD TO DUPLICATE
#17630
#17631
APPROVED
LORAIN CO.
MAP DEPT.
DATE 8-31-87
BY T. McClain
VOID AFTER 8/31/87
4-00-018
ST.
6/2
10-29-87