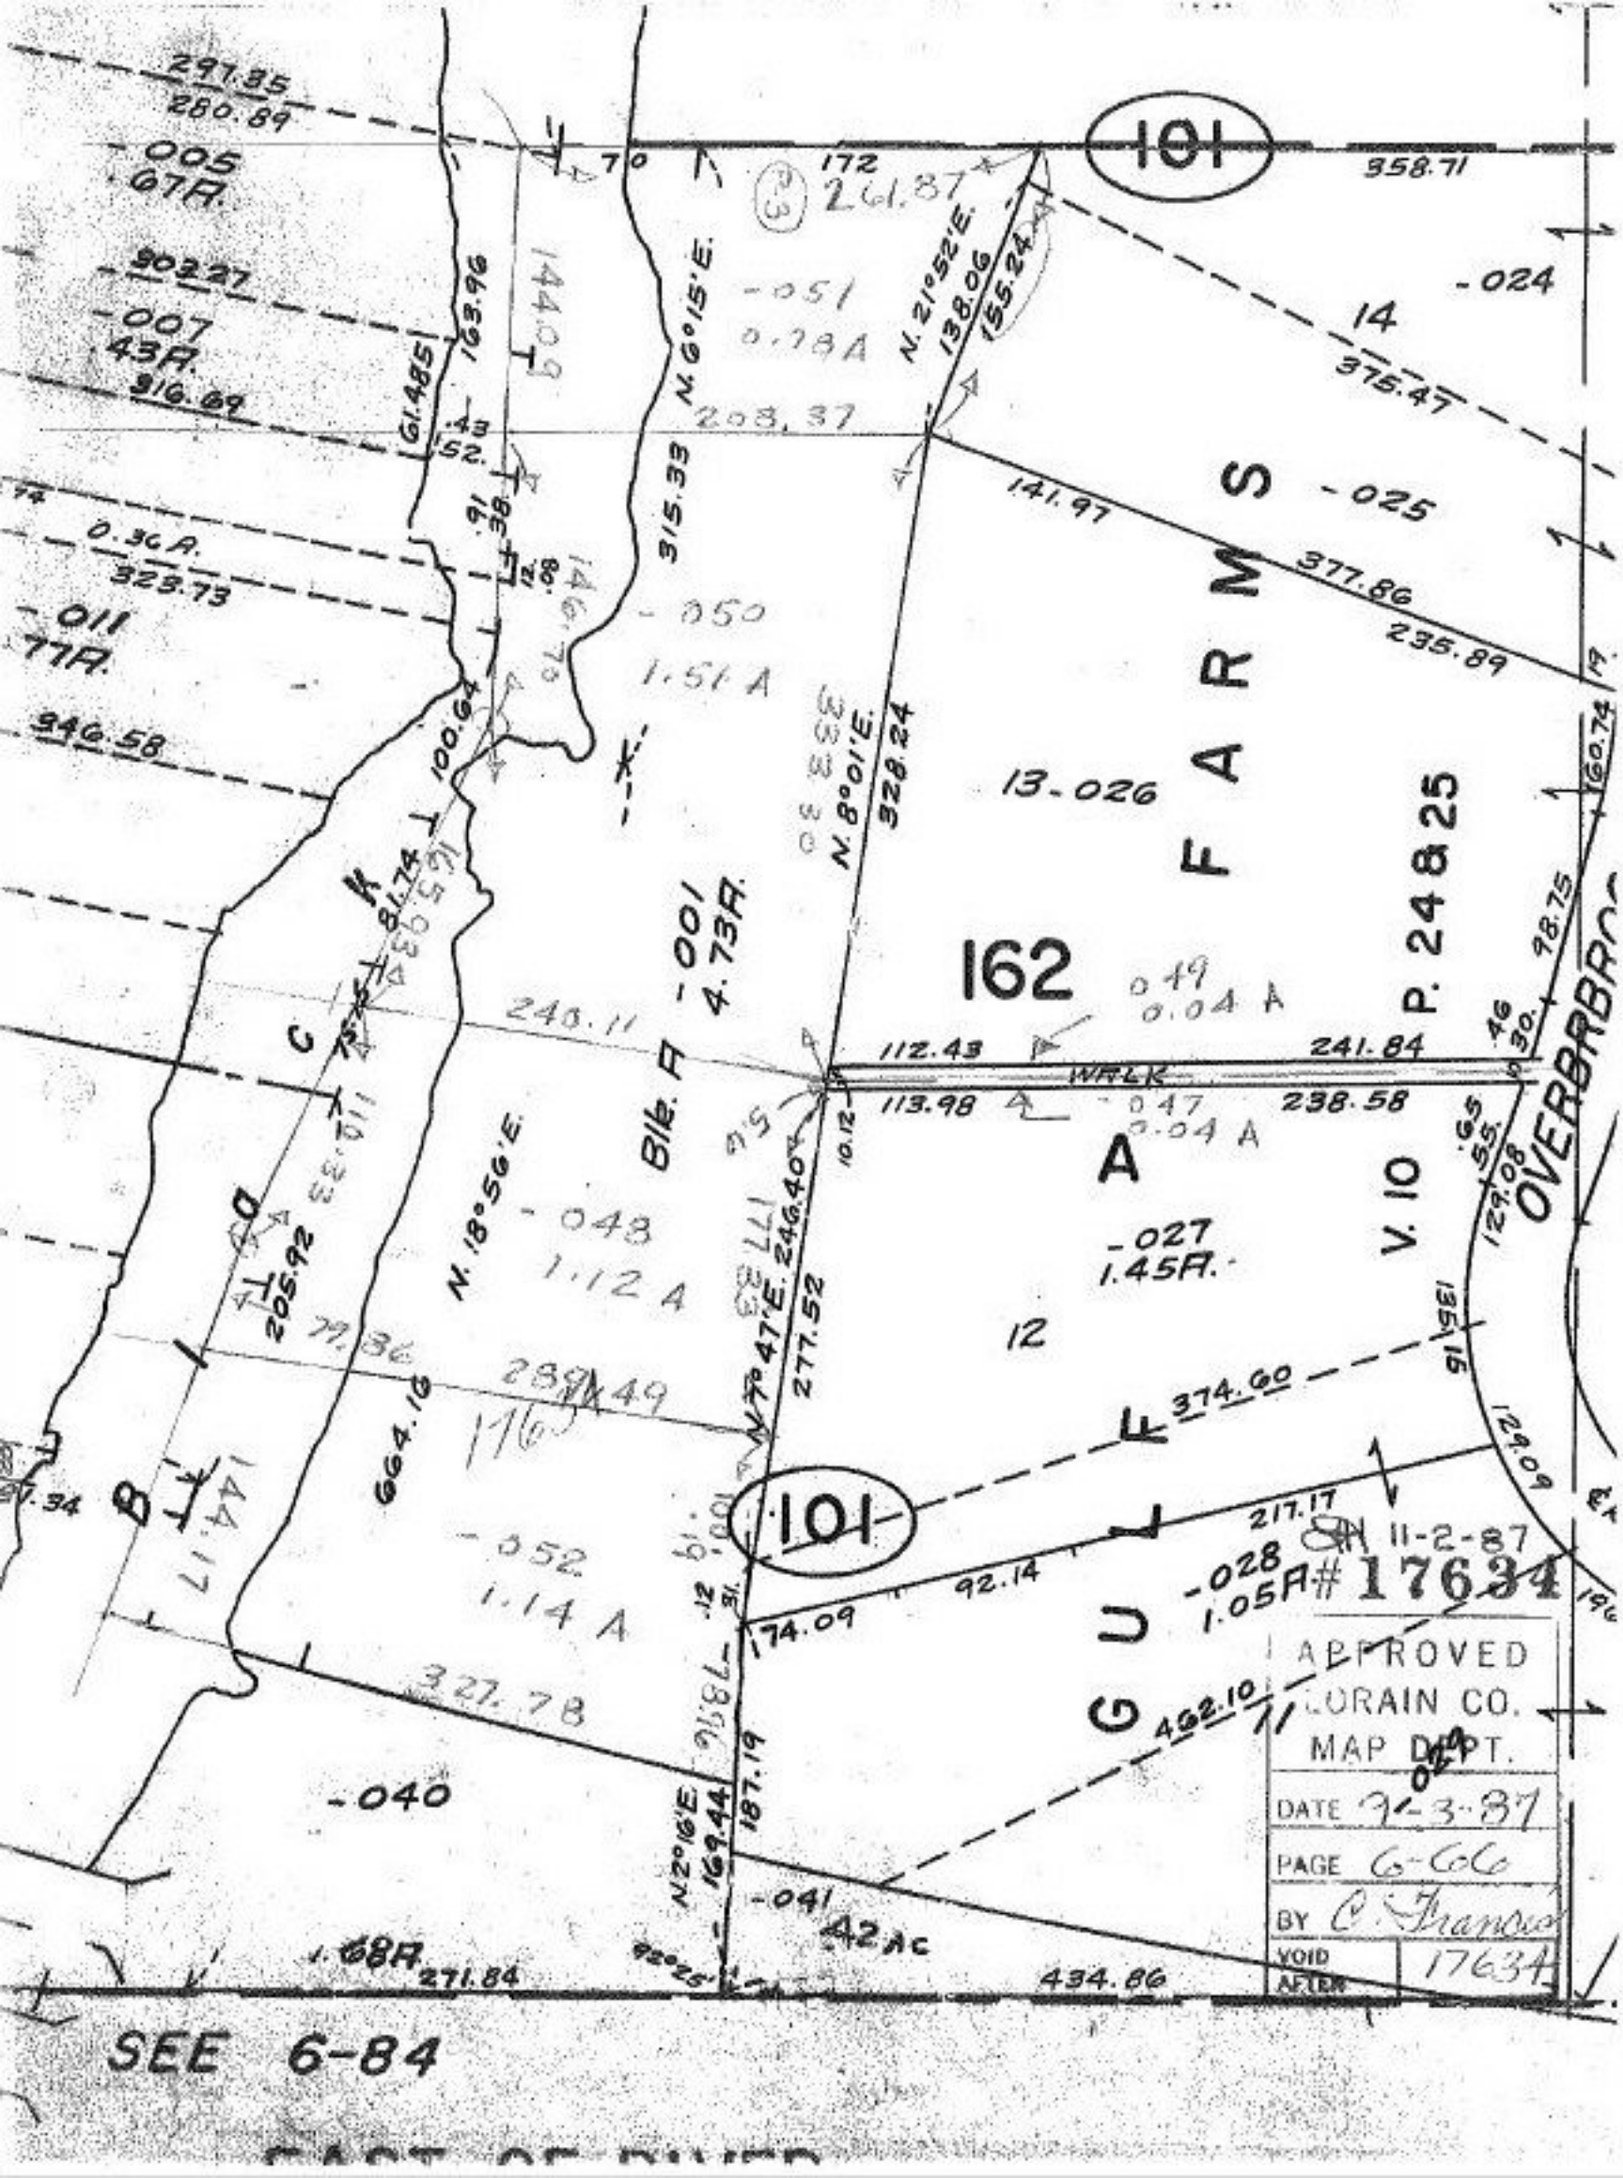

11-2-87
#17634
APPROVED
LORAIN CO.
MAP DEPT.
DATE 9-3-87
PAGE 6-66
BY C. Francis
VOID AFTER 17634

SEE 6-84

EAST OF RIVER