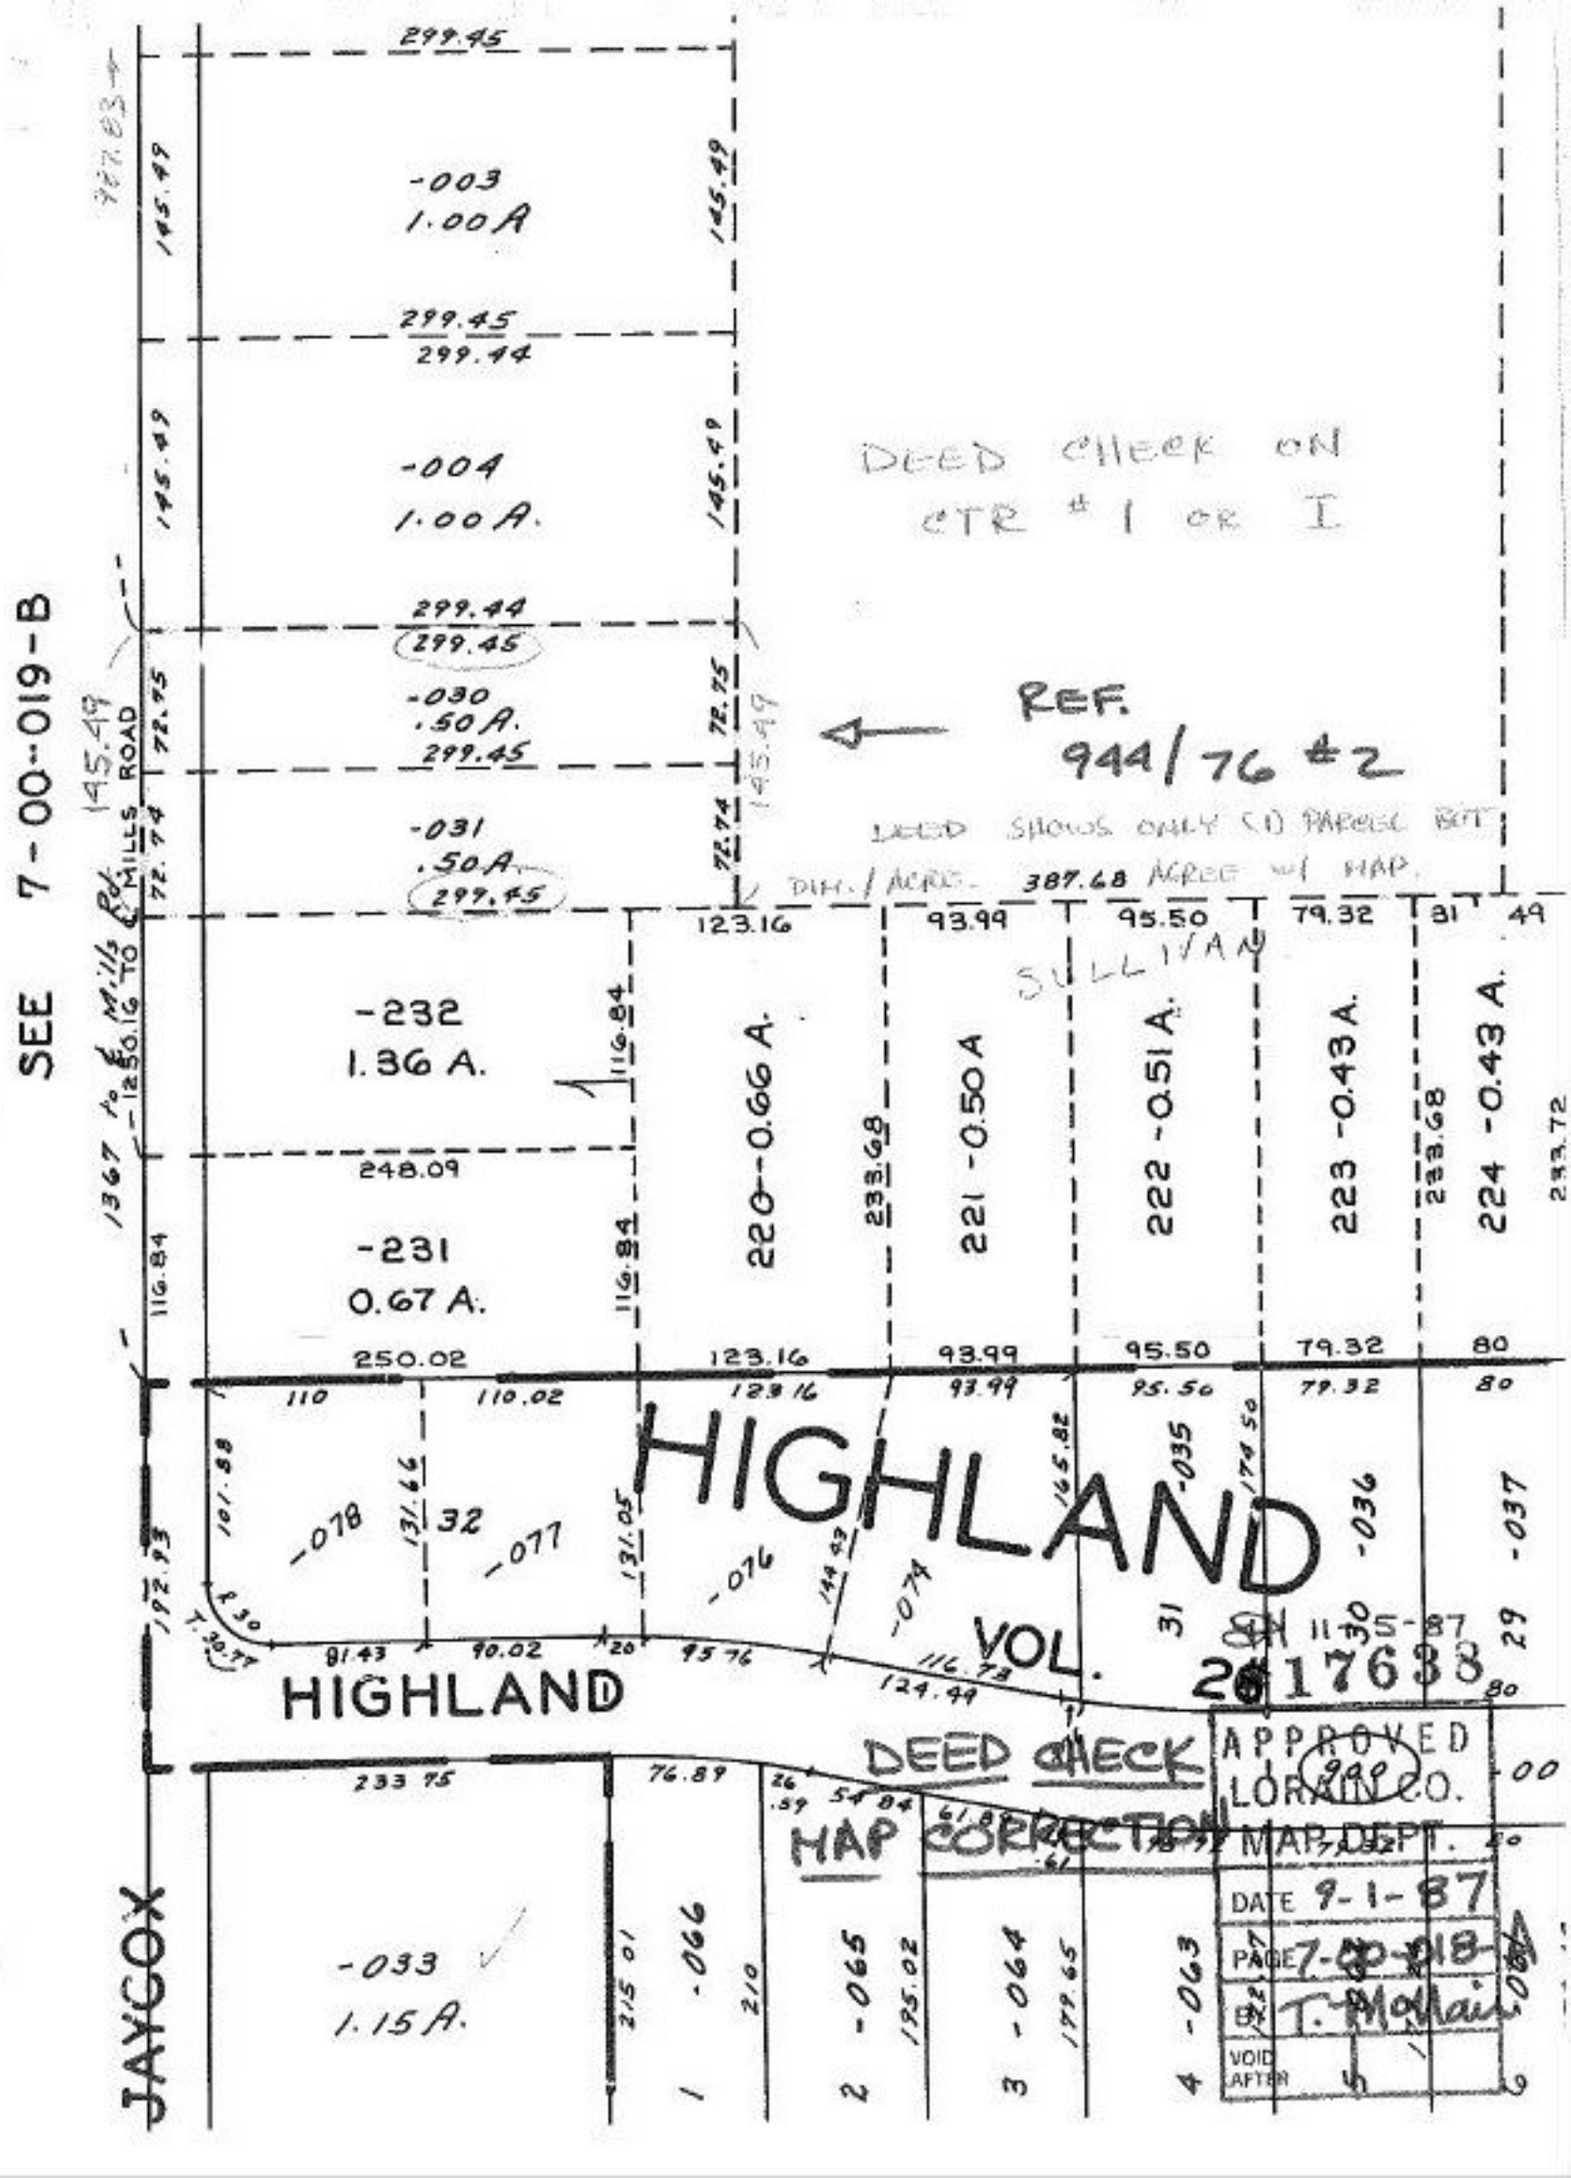

SEE 7-00-019-B
1367 to ℄ Mills Rd. 1250.16 TO ℄ MILLS ROAD
-003
1.00 A
-004
1.00 A.
-030
.50 A.
-031
.50 A.
DEED CHECK ON
CTR #1 OR I
REF.
944/76 #2
DEED SHOWS ONLY (1) PARCEL BUT
DIM./ACRE. 387.68 AGREE w/ MAP.
SULLIVAN
-232
1.36 A.
-231
0.67 A.
220-0.66 A.
221 -0.50 A
222 -0.51 A.
223 -0.43 A.
224 -0.43 A.
HIGHLAND
VOL. 2617638
HIGHLAND
DEED CHECK
MAP CORRECTION
APPROVED
LORAIN CO.
MAP DEPT.
DATE 9-1-87
PAGE 7-00-018-A
BY T. McNair
VOID AFTER
JAYCOX
-033
1.15 A.