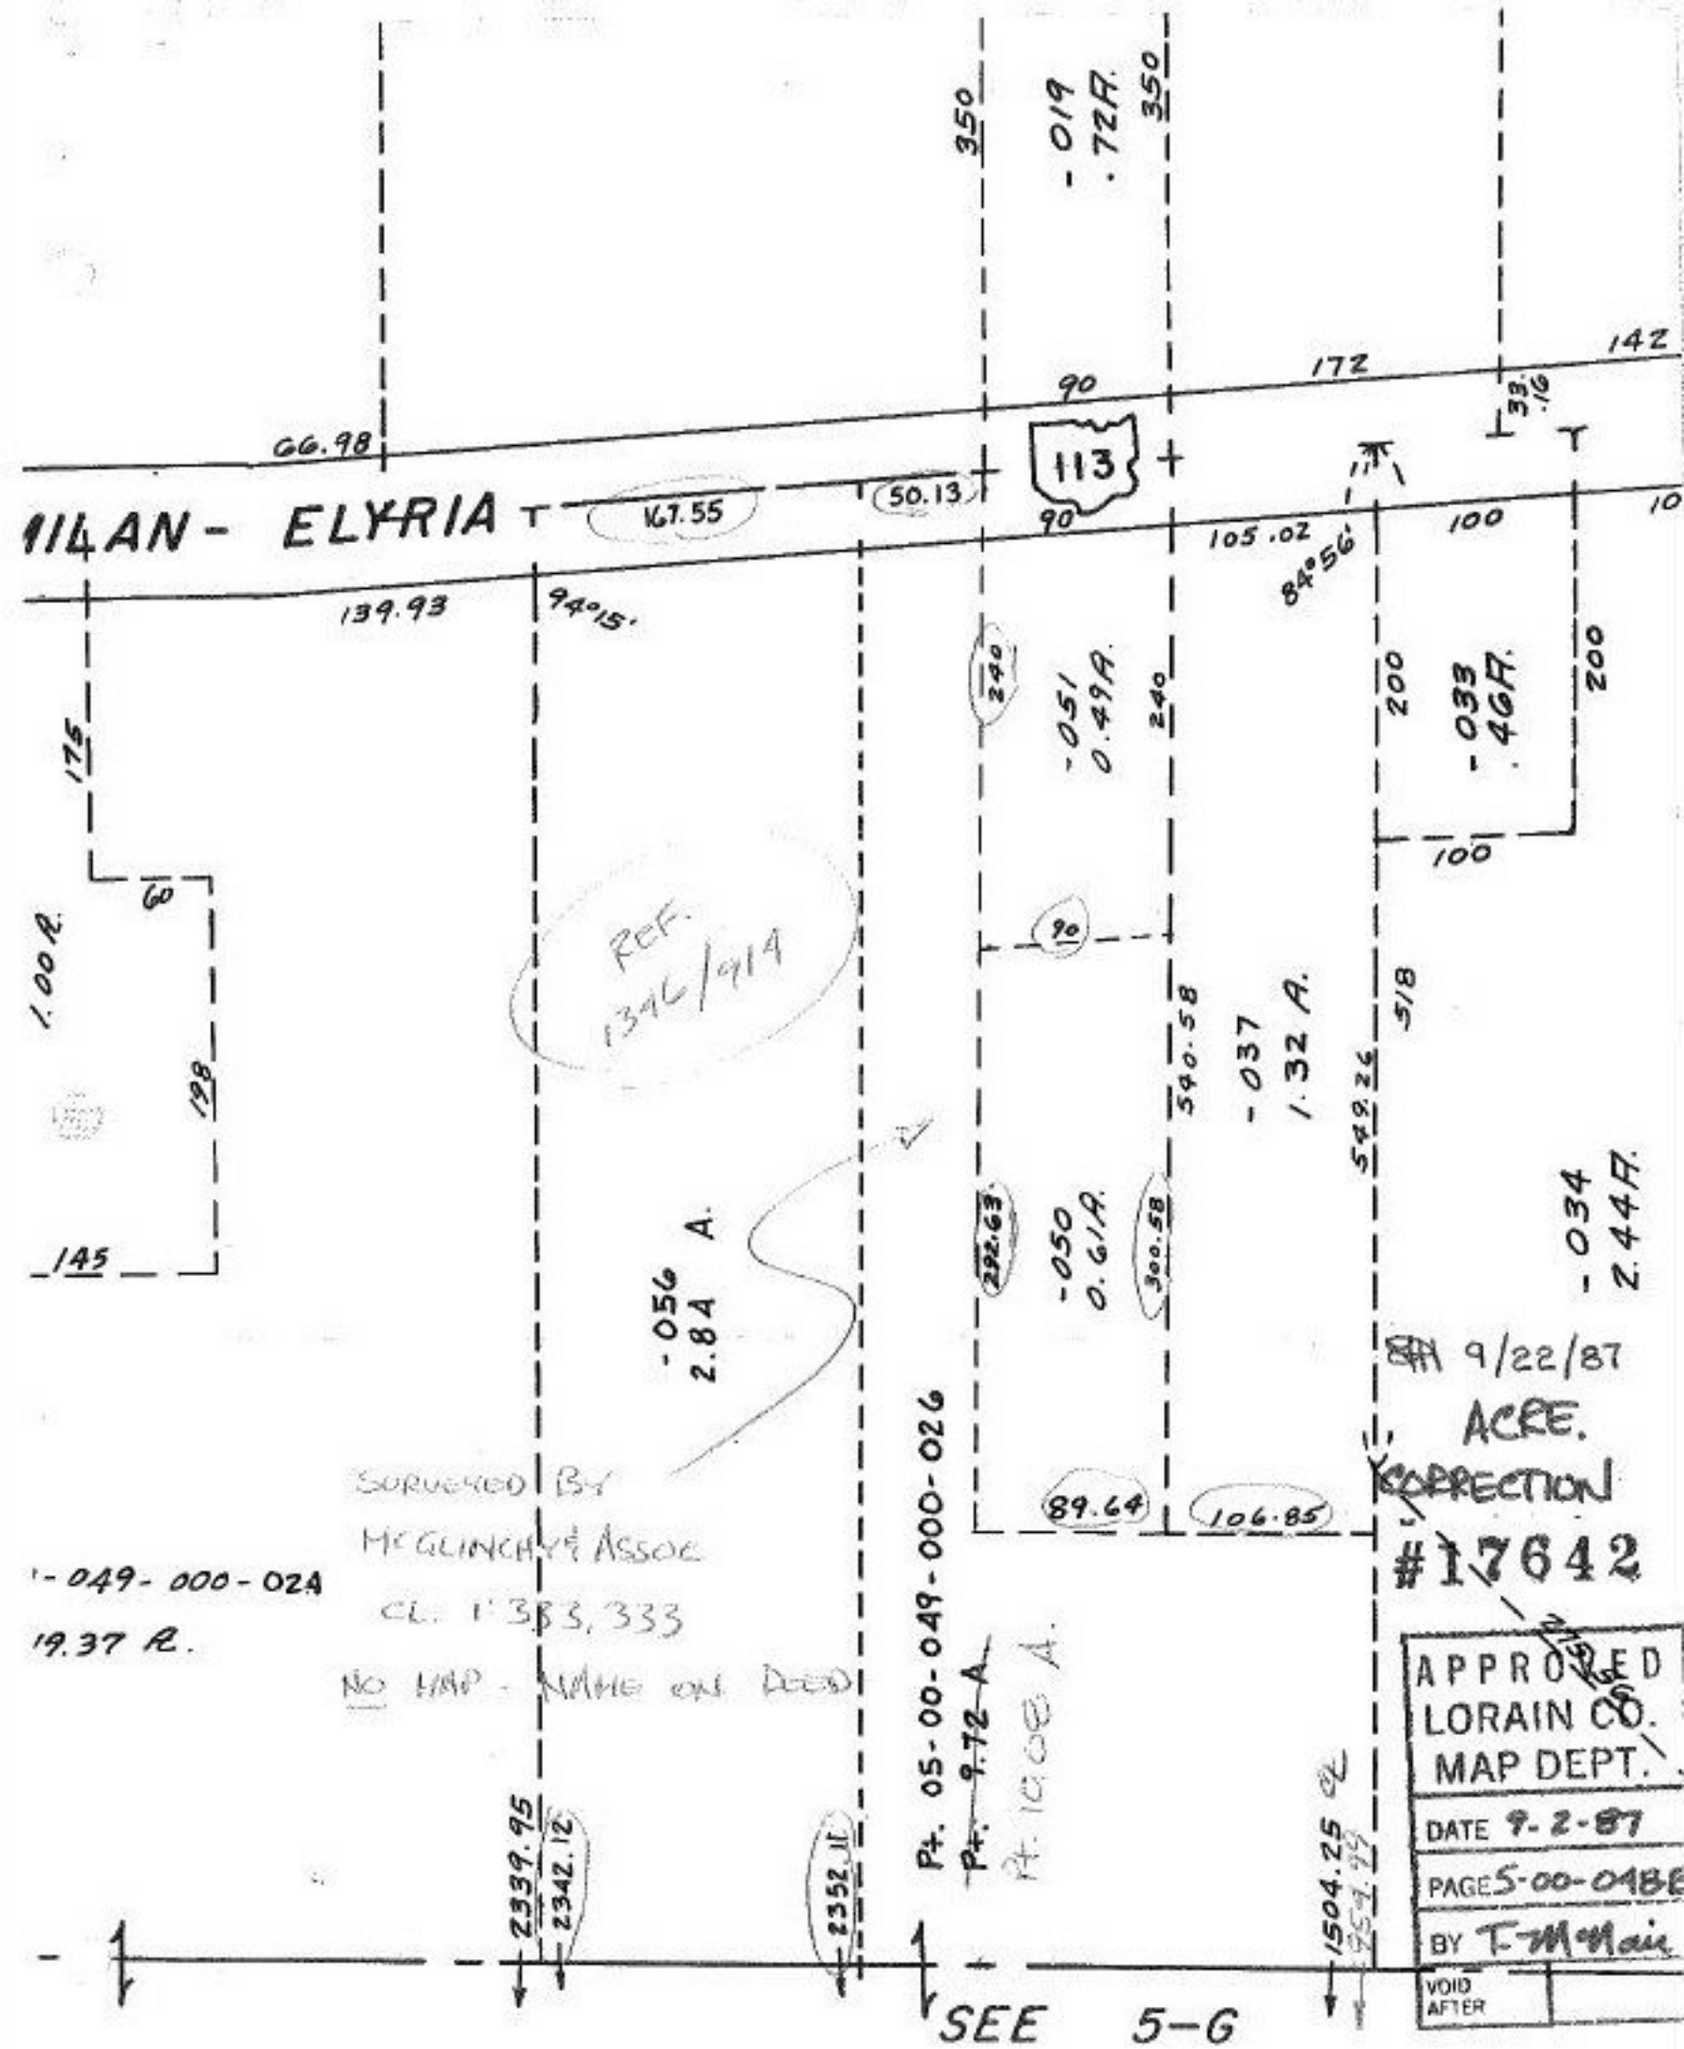

MILAN - ELYRIA
113
66.98
167.55
50.13
139.93
94°15'
105.02
84°56'
-019
.72A.
-051
0.49A.
-033
.46A.
-037
1.32 A.
-050
0.61A.
-034
2.44A.
-056
2.84 A.
REF. 1346/914
SURVEYED BY
McGLINCHY & ASSOC
CL. 1:333,333
NO MAP - NAME ON DEED
-049-000-024
19.37 A.
P+. 05-00-049-000-026
P+. 9.72 A.
P+. 10.08 A.
2339.95
2342.12
2352.11
1504.25
SEE 5-G
9/22/87
ACRE.
CORRECTION
#17642
APPROVED
LORAIN CO.
MAP DEPT.
DATE 9-2-87
PAGE 5-00-048
BY T. McNair
VOID AFTER