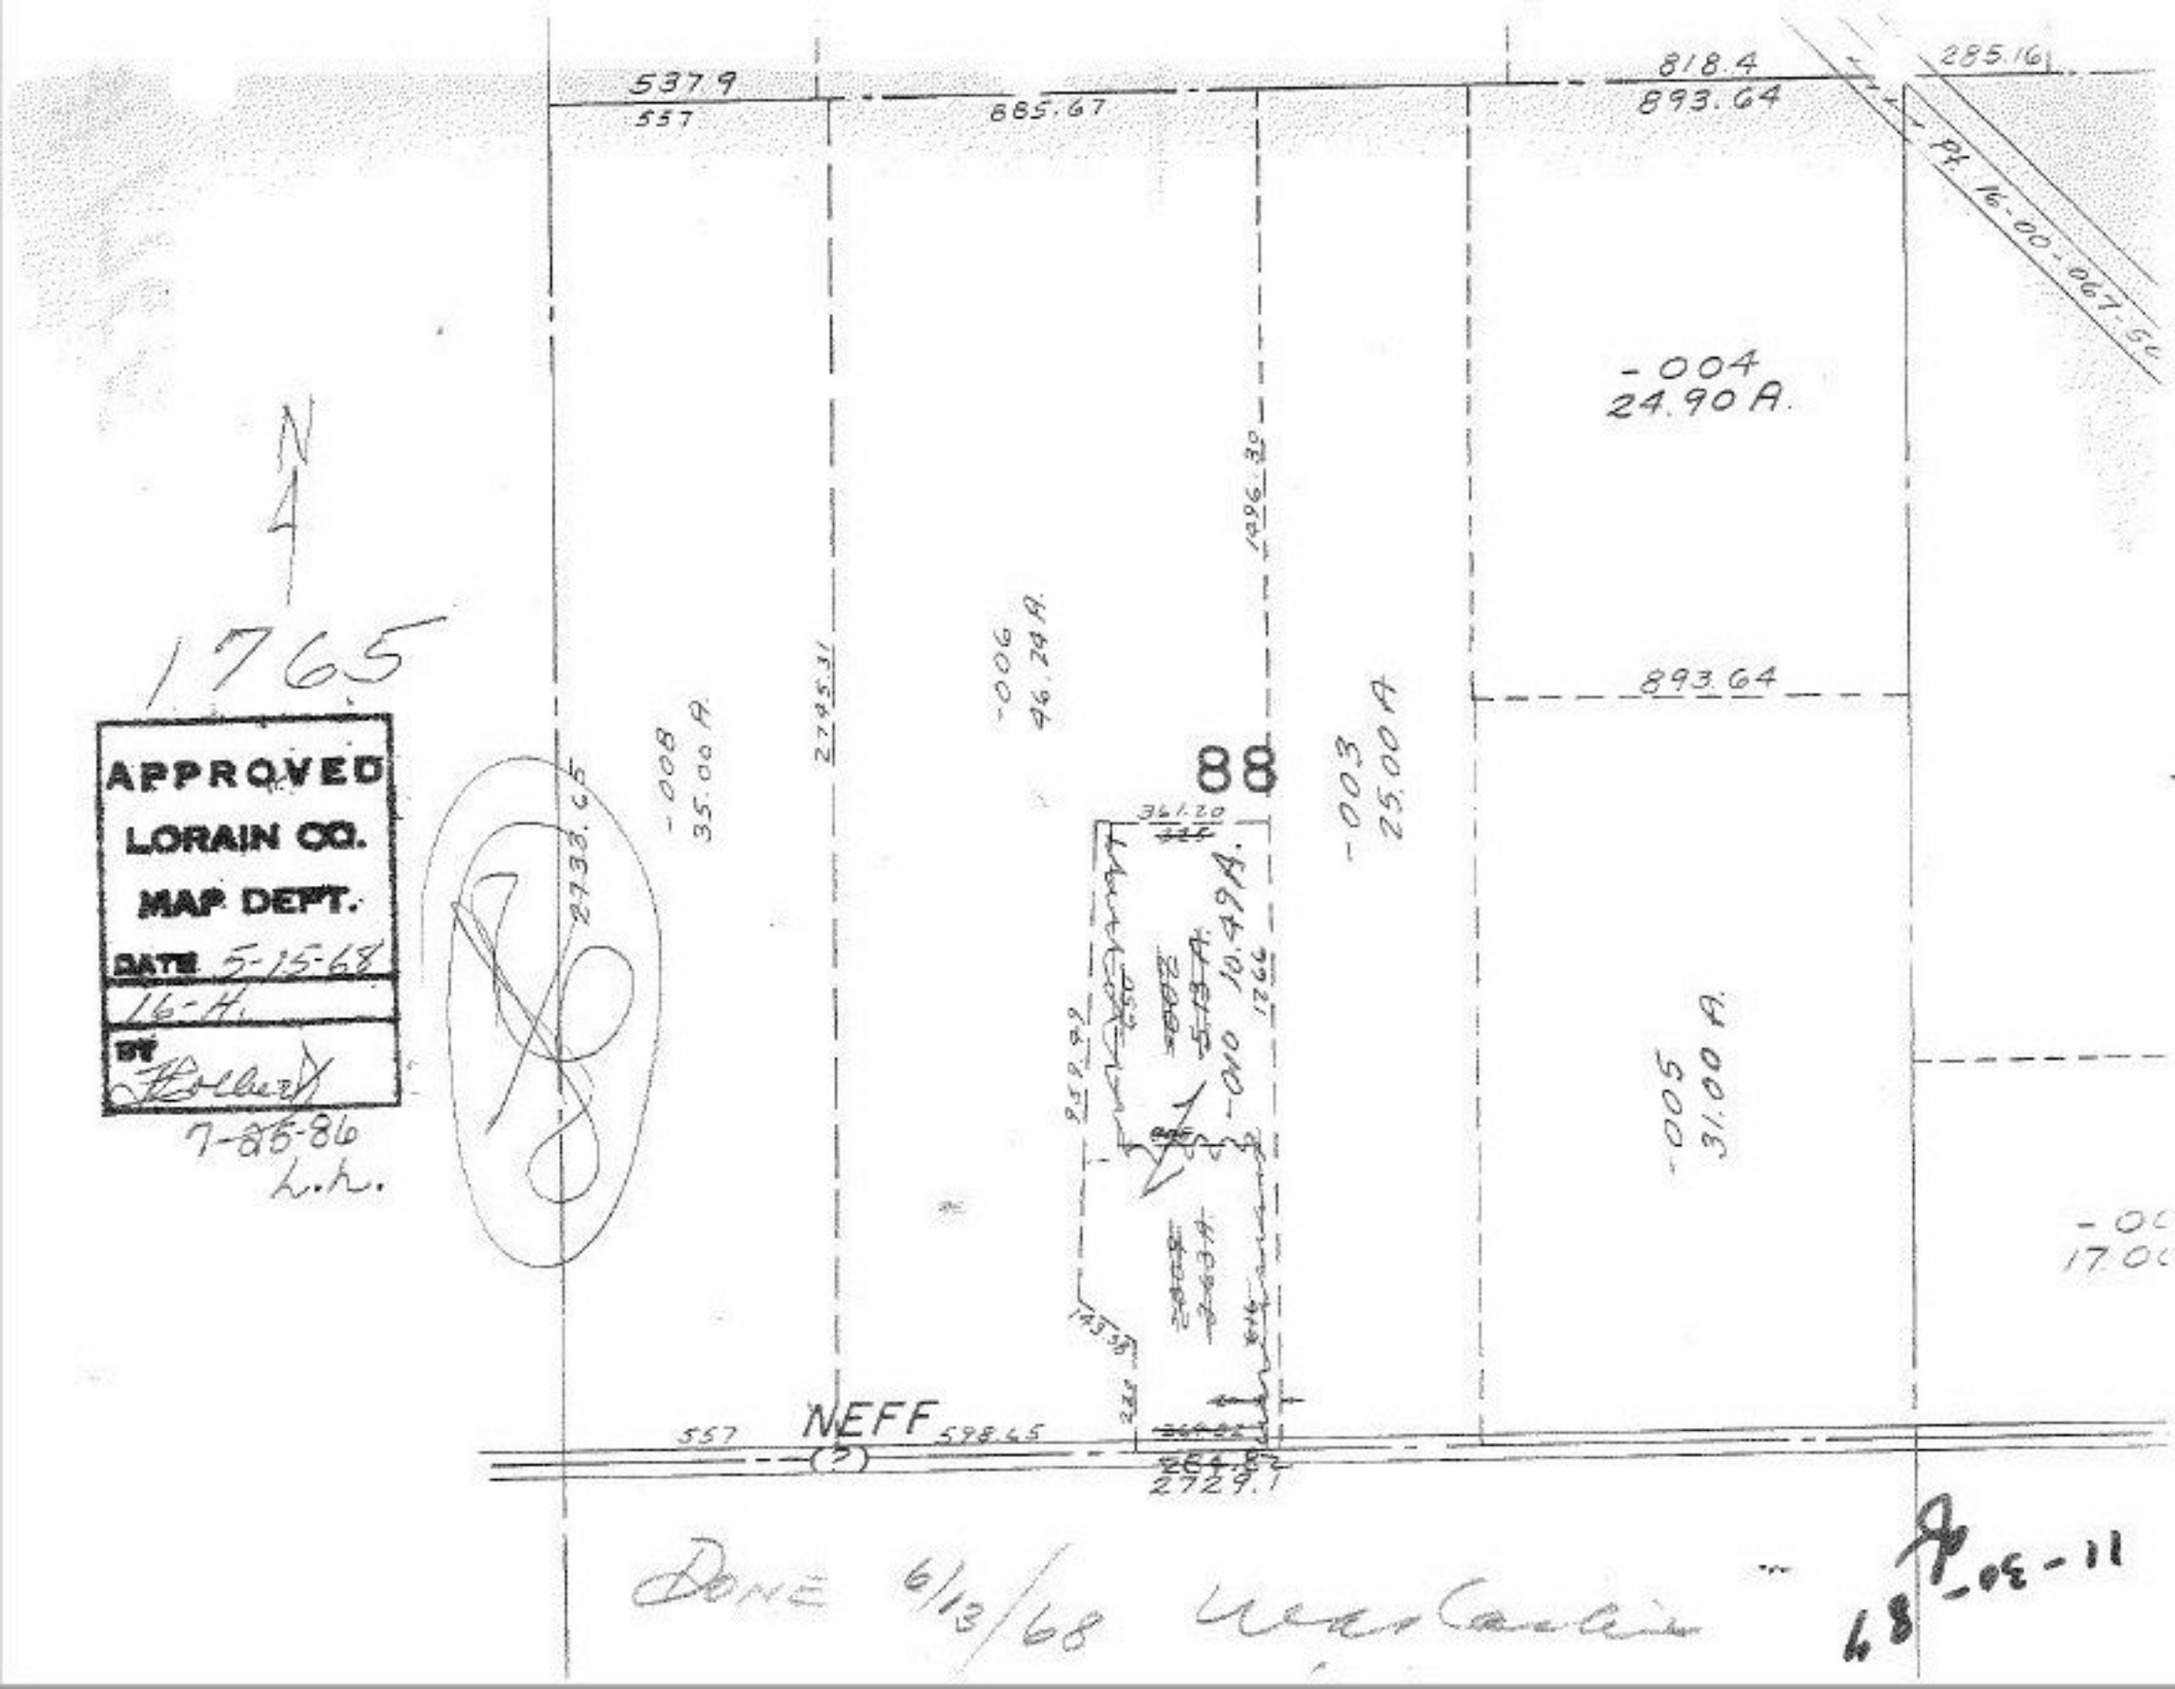
5379
557
885.67
818.4
893.64
285.16
Pt. 16-00-067.54
-004
24.90 A.
2795.31
-006
46.24 A.
1496.30
893.64
-008
35.00 A.
2738.65
88
-003
25.00 A.
-010
10.494 A.
-005
31.00 A.
557
NEFF
598.45
264.8
2729.1
APPROVED
LORAIN CO.
MAP DEPT.
DATE 5-15-68
16-H
BY
7-86-86
L.H.
1765
N
4
DONE 6/13/68
68-05-11