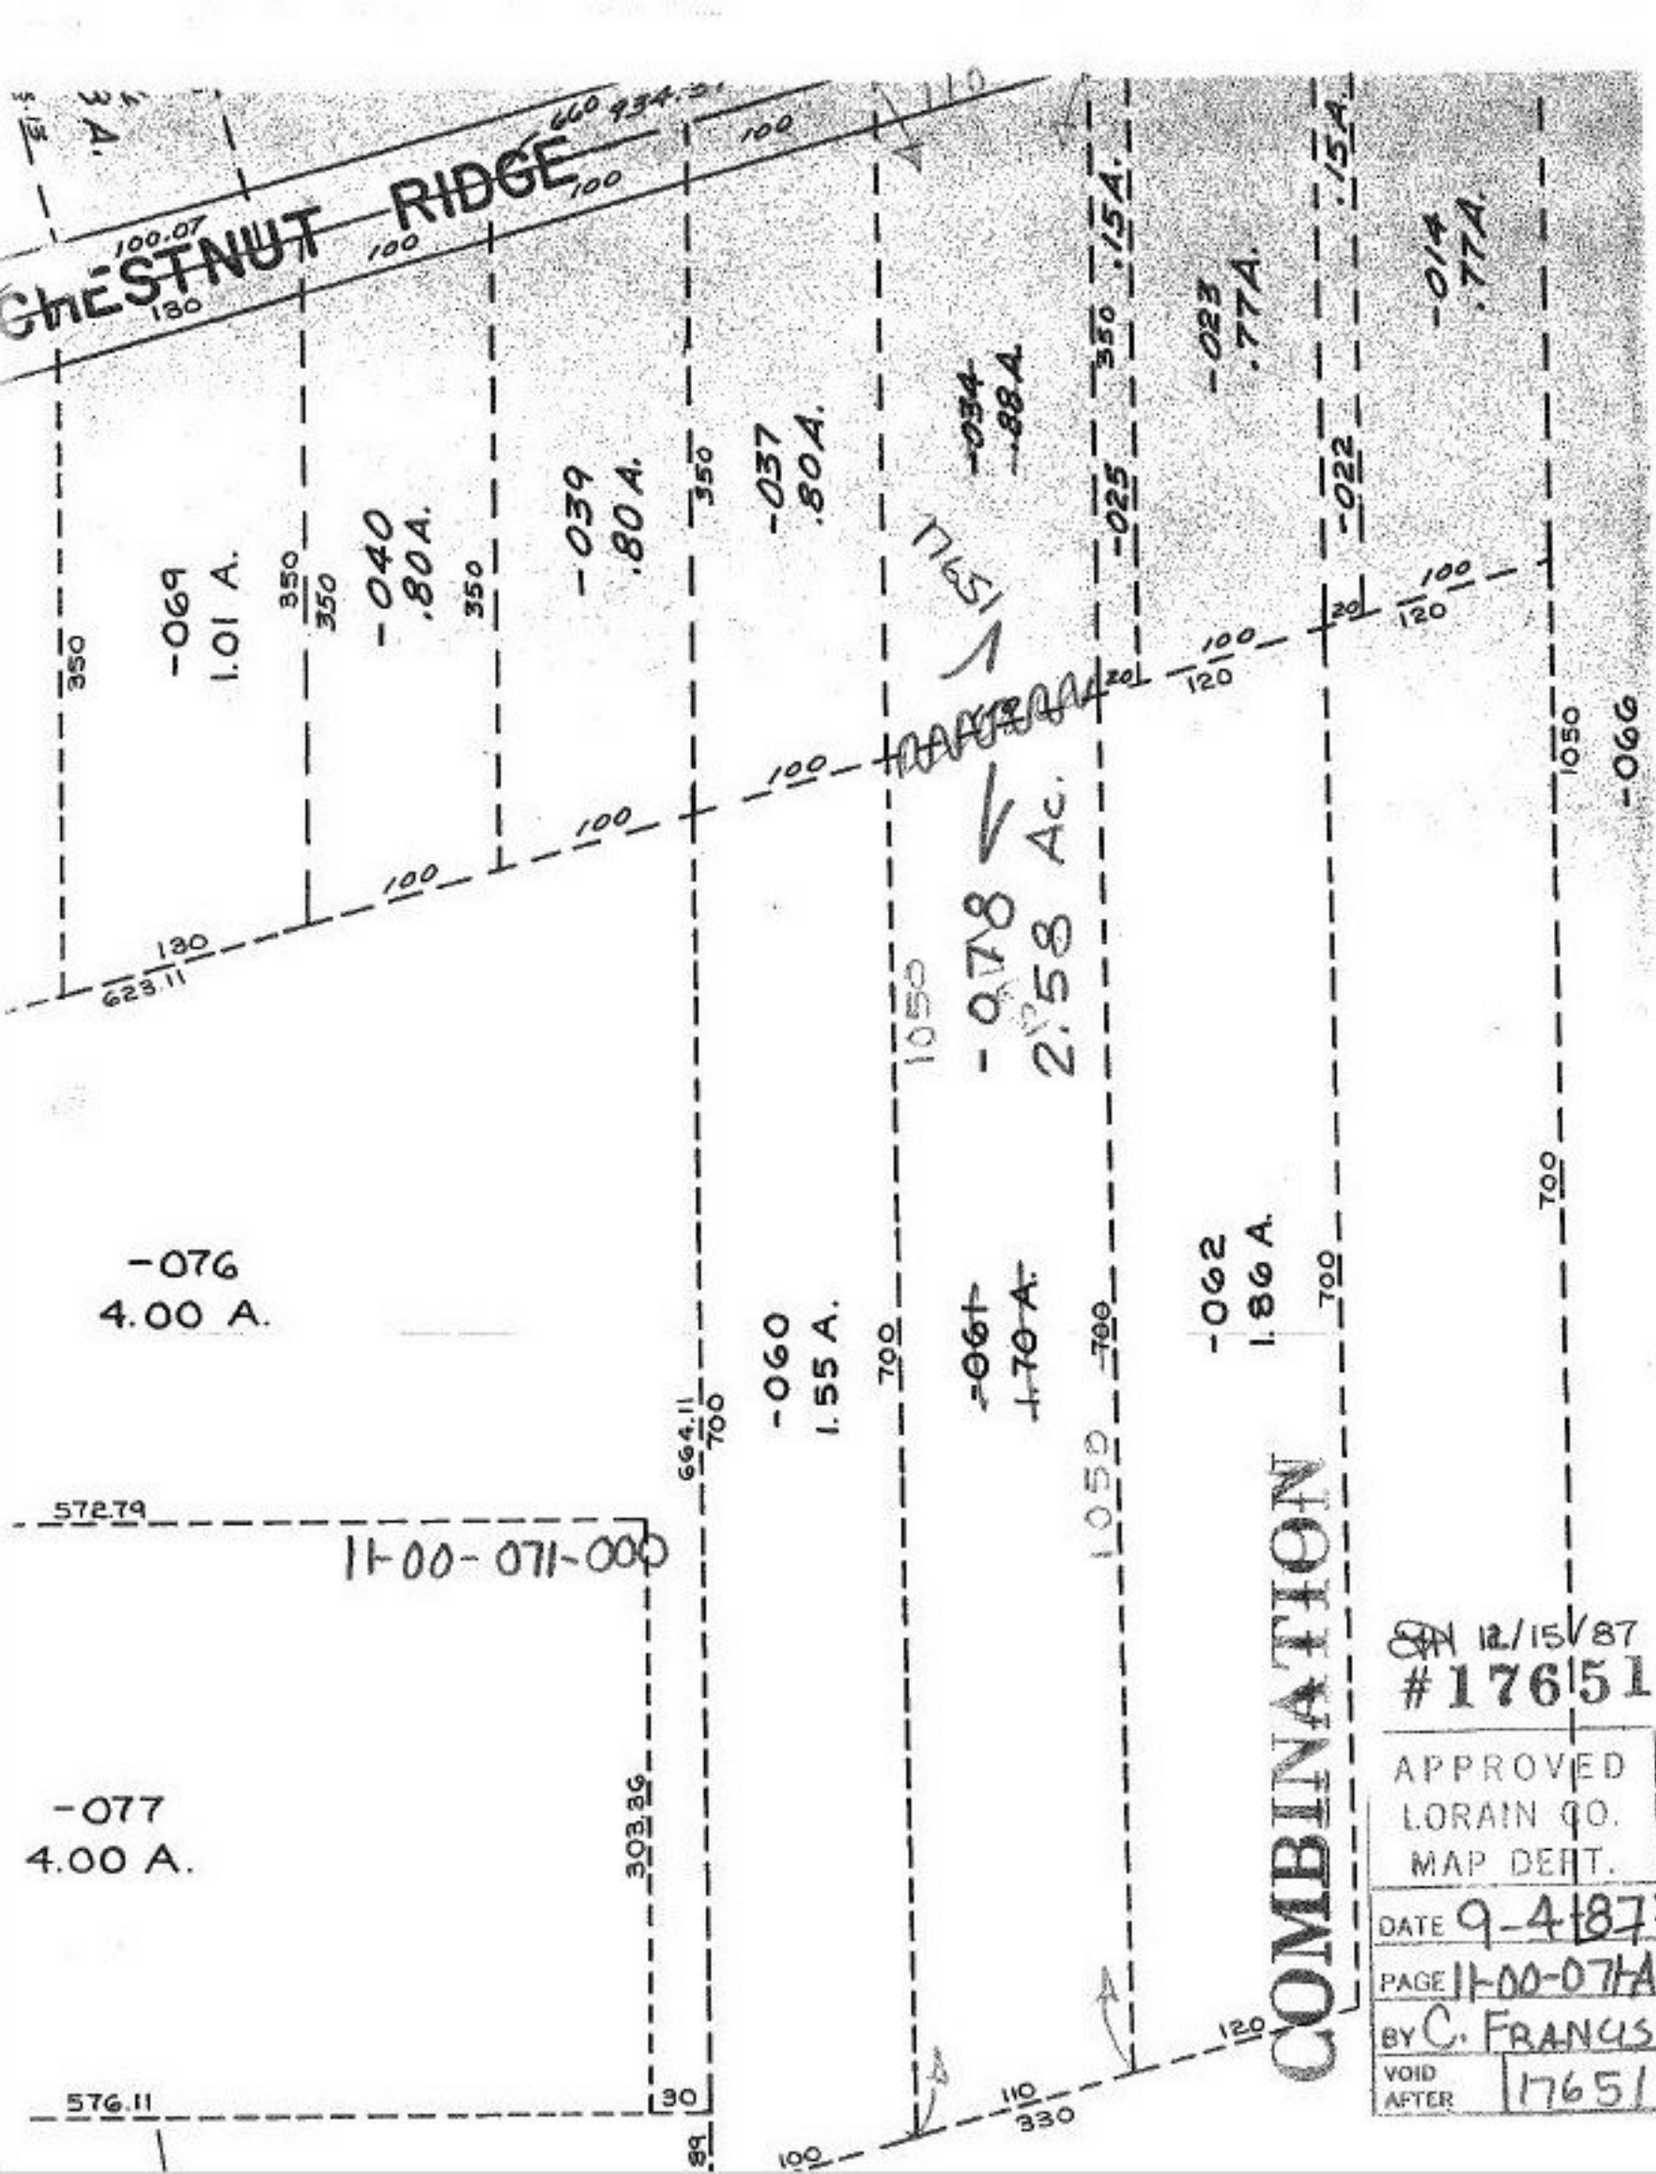
CHESTNUT RIDGE
-069
1.01 A.
-040
.80A.
-039
.80 A.
-037
.80A.
-034
.88A.
-025
-023
.77A.
-022
-014
.77A.
-066
-078
2.58 Ac.
17651
-076
4.00 A.
-060
1.55 A.
-061
.70 A.
-062
1.86 A.
-077
4.00 A.
11-00-071-000
COMBINATION
SN 12/15/87
#17651
APPROVED
LORAIN CO.
MAP DEPT.
DATE 9-4-87
PAGE 11-00-07HA
BY C. FRANCIS
VOID AFTER 17651