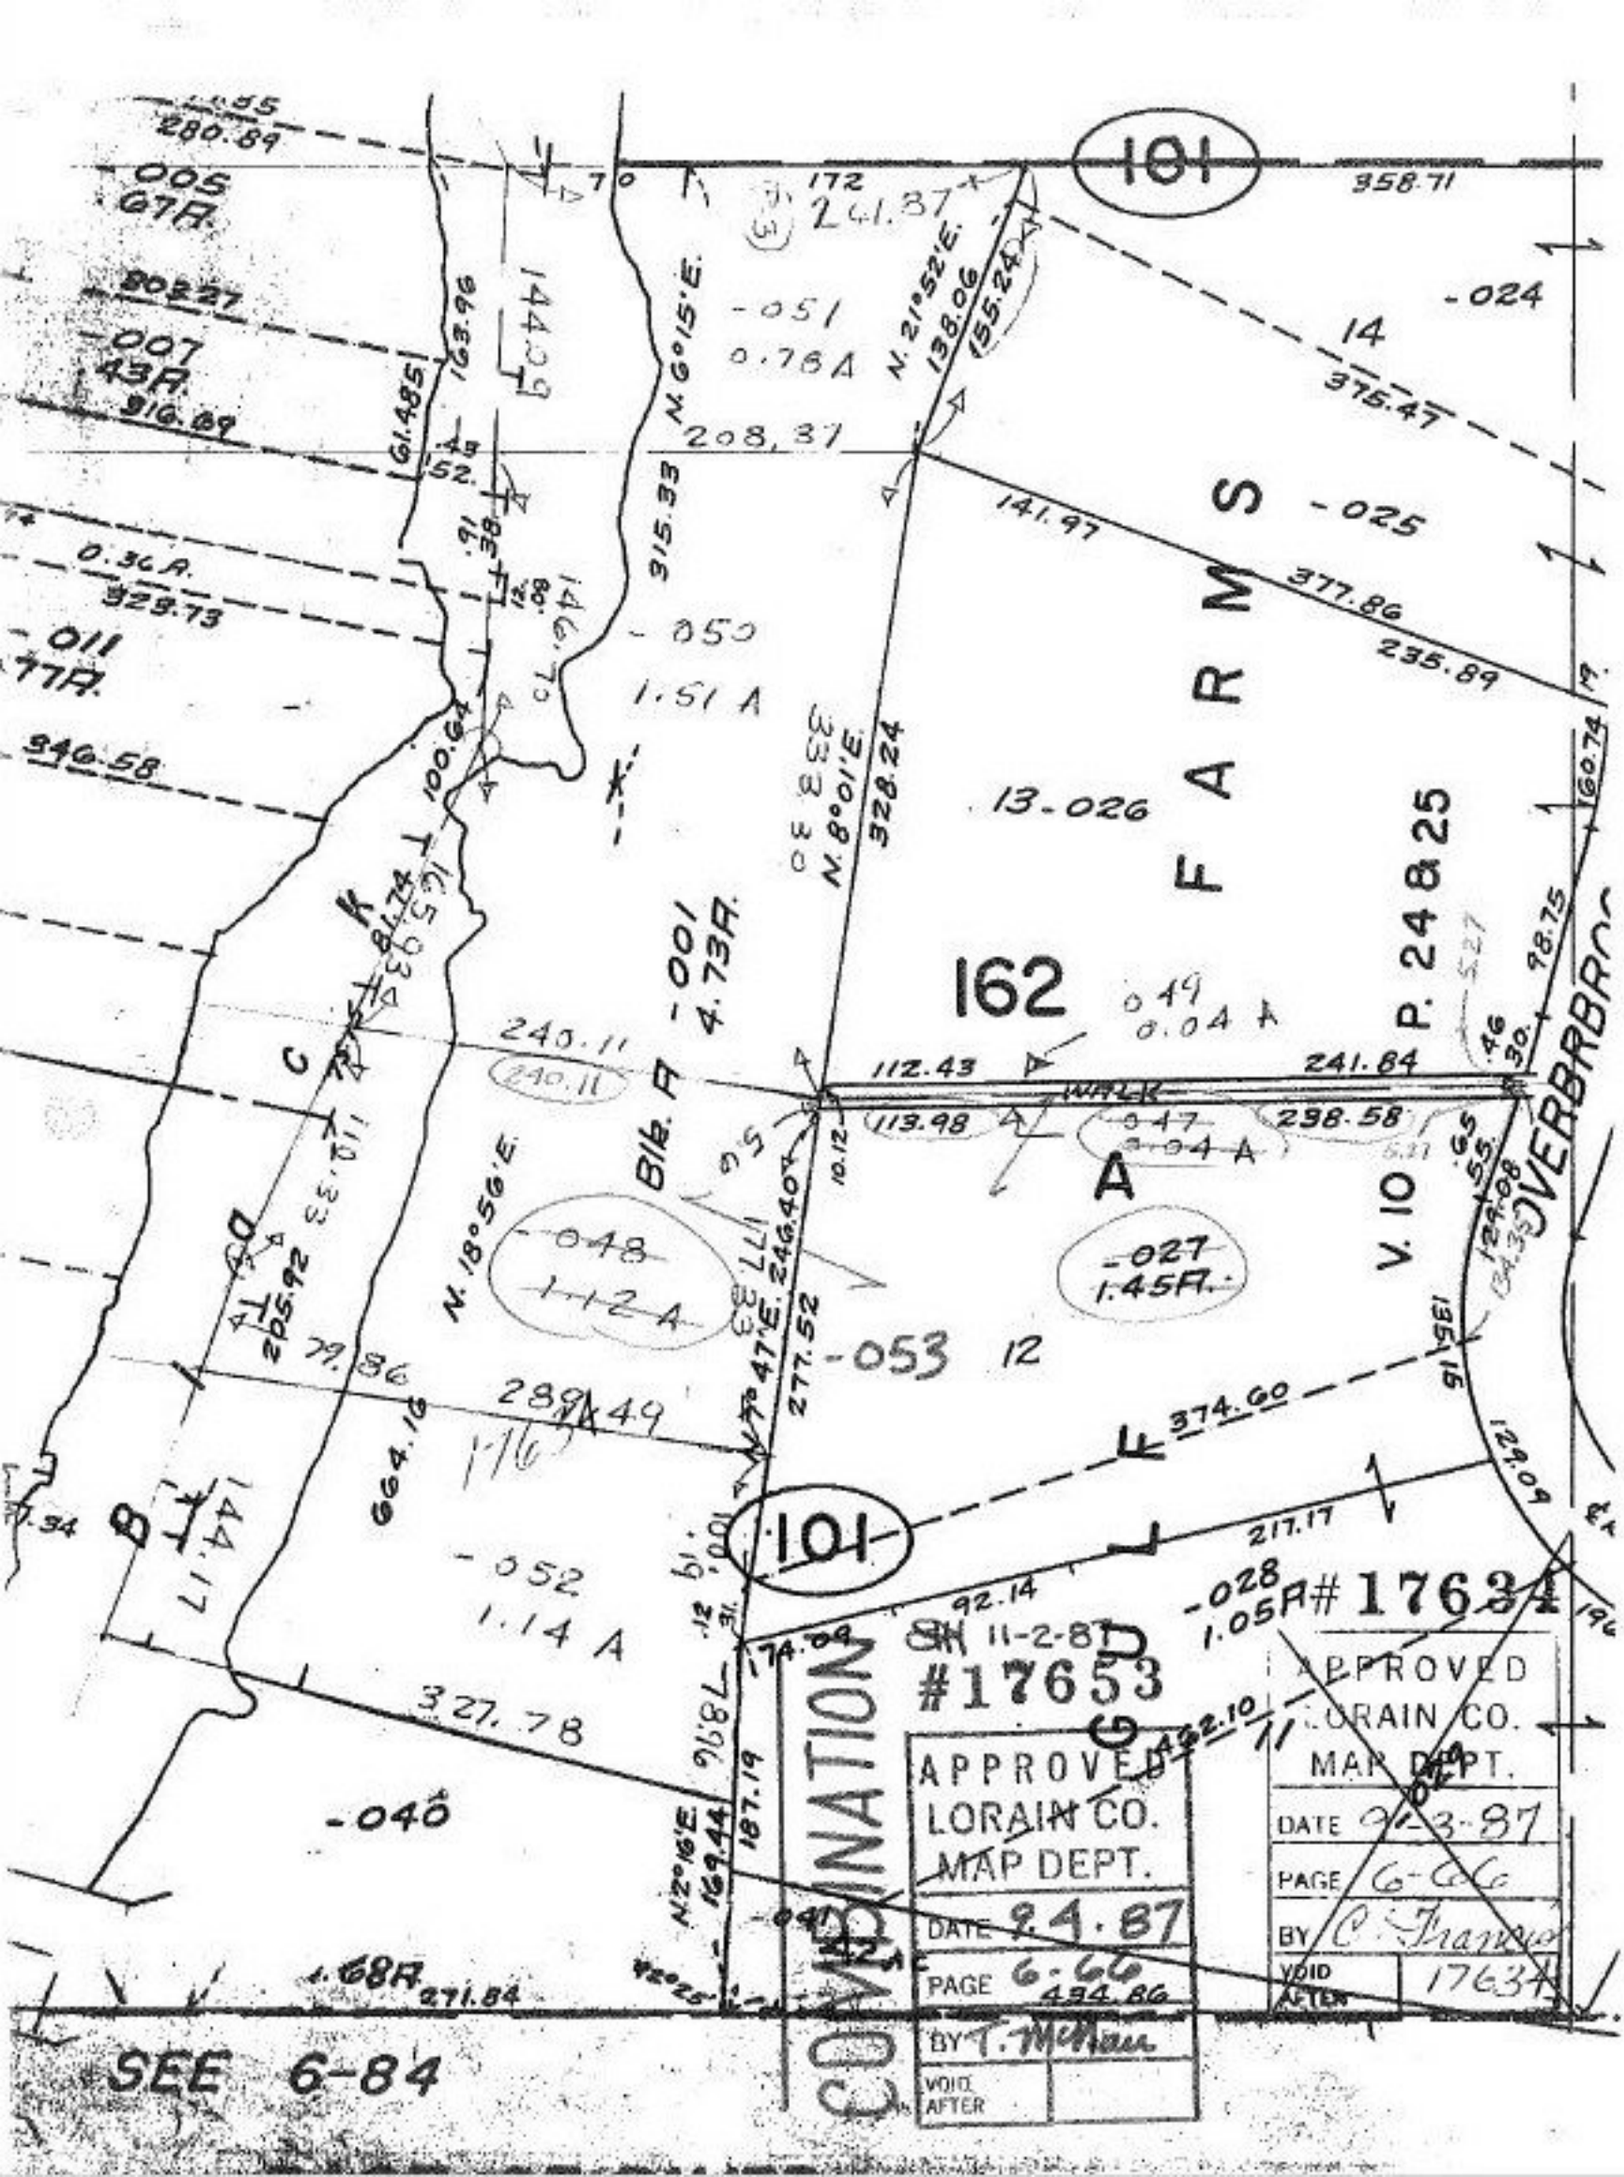
101
162
FARMS
P. 24 & 25
V. 10
OVERBRBROOK
GULF
COMBINATION
#17653
#17634
APPROVED
LORAIN CO.
MAP DEPT.
DATE 9-4-87
PAGE 6-66
BY T. McNair
VOID AFTER
APPROVED
LORAIN CO.
MAP DEPT.
DATE 9-3-87
PAGE 6-66
BY C. Francis
VOID AFTER 17634
SEE 6-84
-005
-007
-011
-024
-025
-050
-051
-052
-053
-027
-028
-040
-048
-049
-001
13-026
14
12
11
B
C
K
D
A
B
1.51 A
1.12 A
1.14 A
1.45A
1.05A
4.73A
1.68A
N. 6°15'E.
N. 21°52'E.
N. 8°01'E.
N. 18°56'E.
N. 2°16'E.
208.37
141.97
377.86
235.89
358.71
375.47
328.24
112.43
241.84
113.98
238.58
374.60
217.17
92.14
174.09
462.10
434.86
271.84
289.49
79.86
664.16
327.78
346.58
323.73
316.69
280.89
303.27
61.485
163.96
315.33
100.64
98.75
160.74
129.09