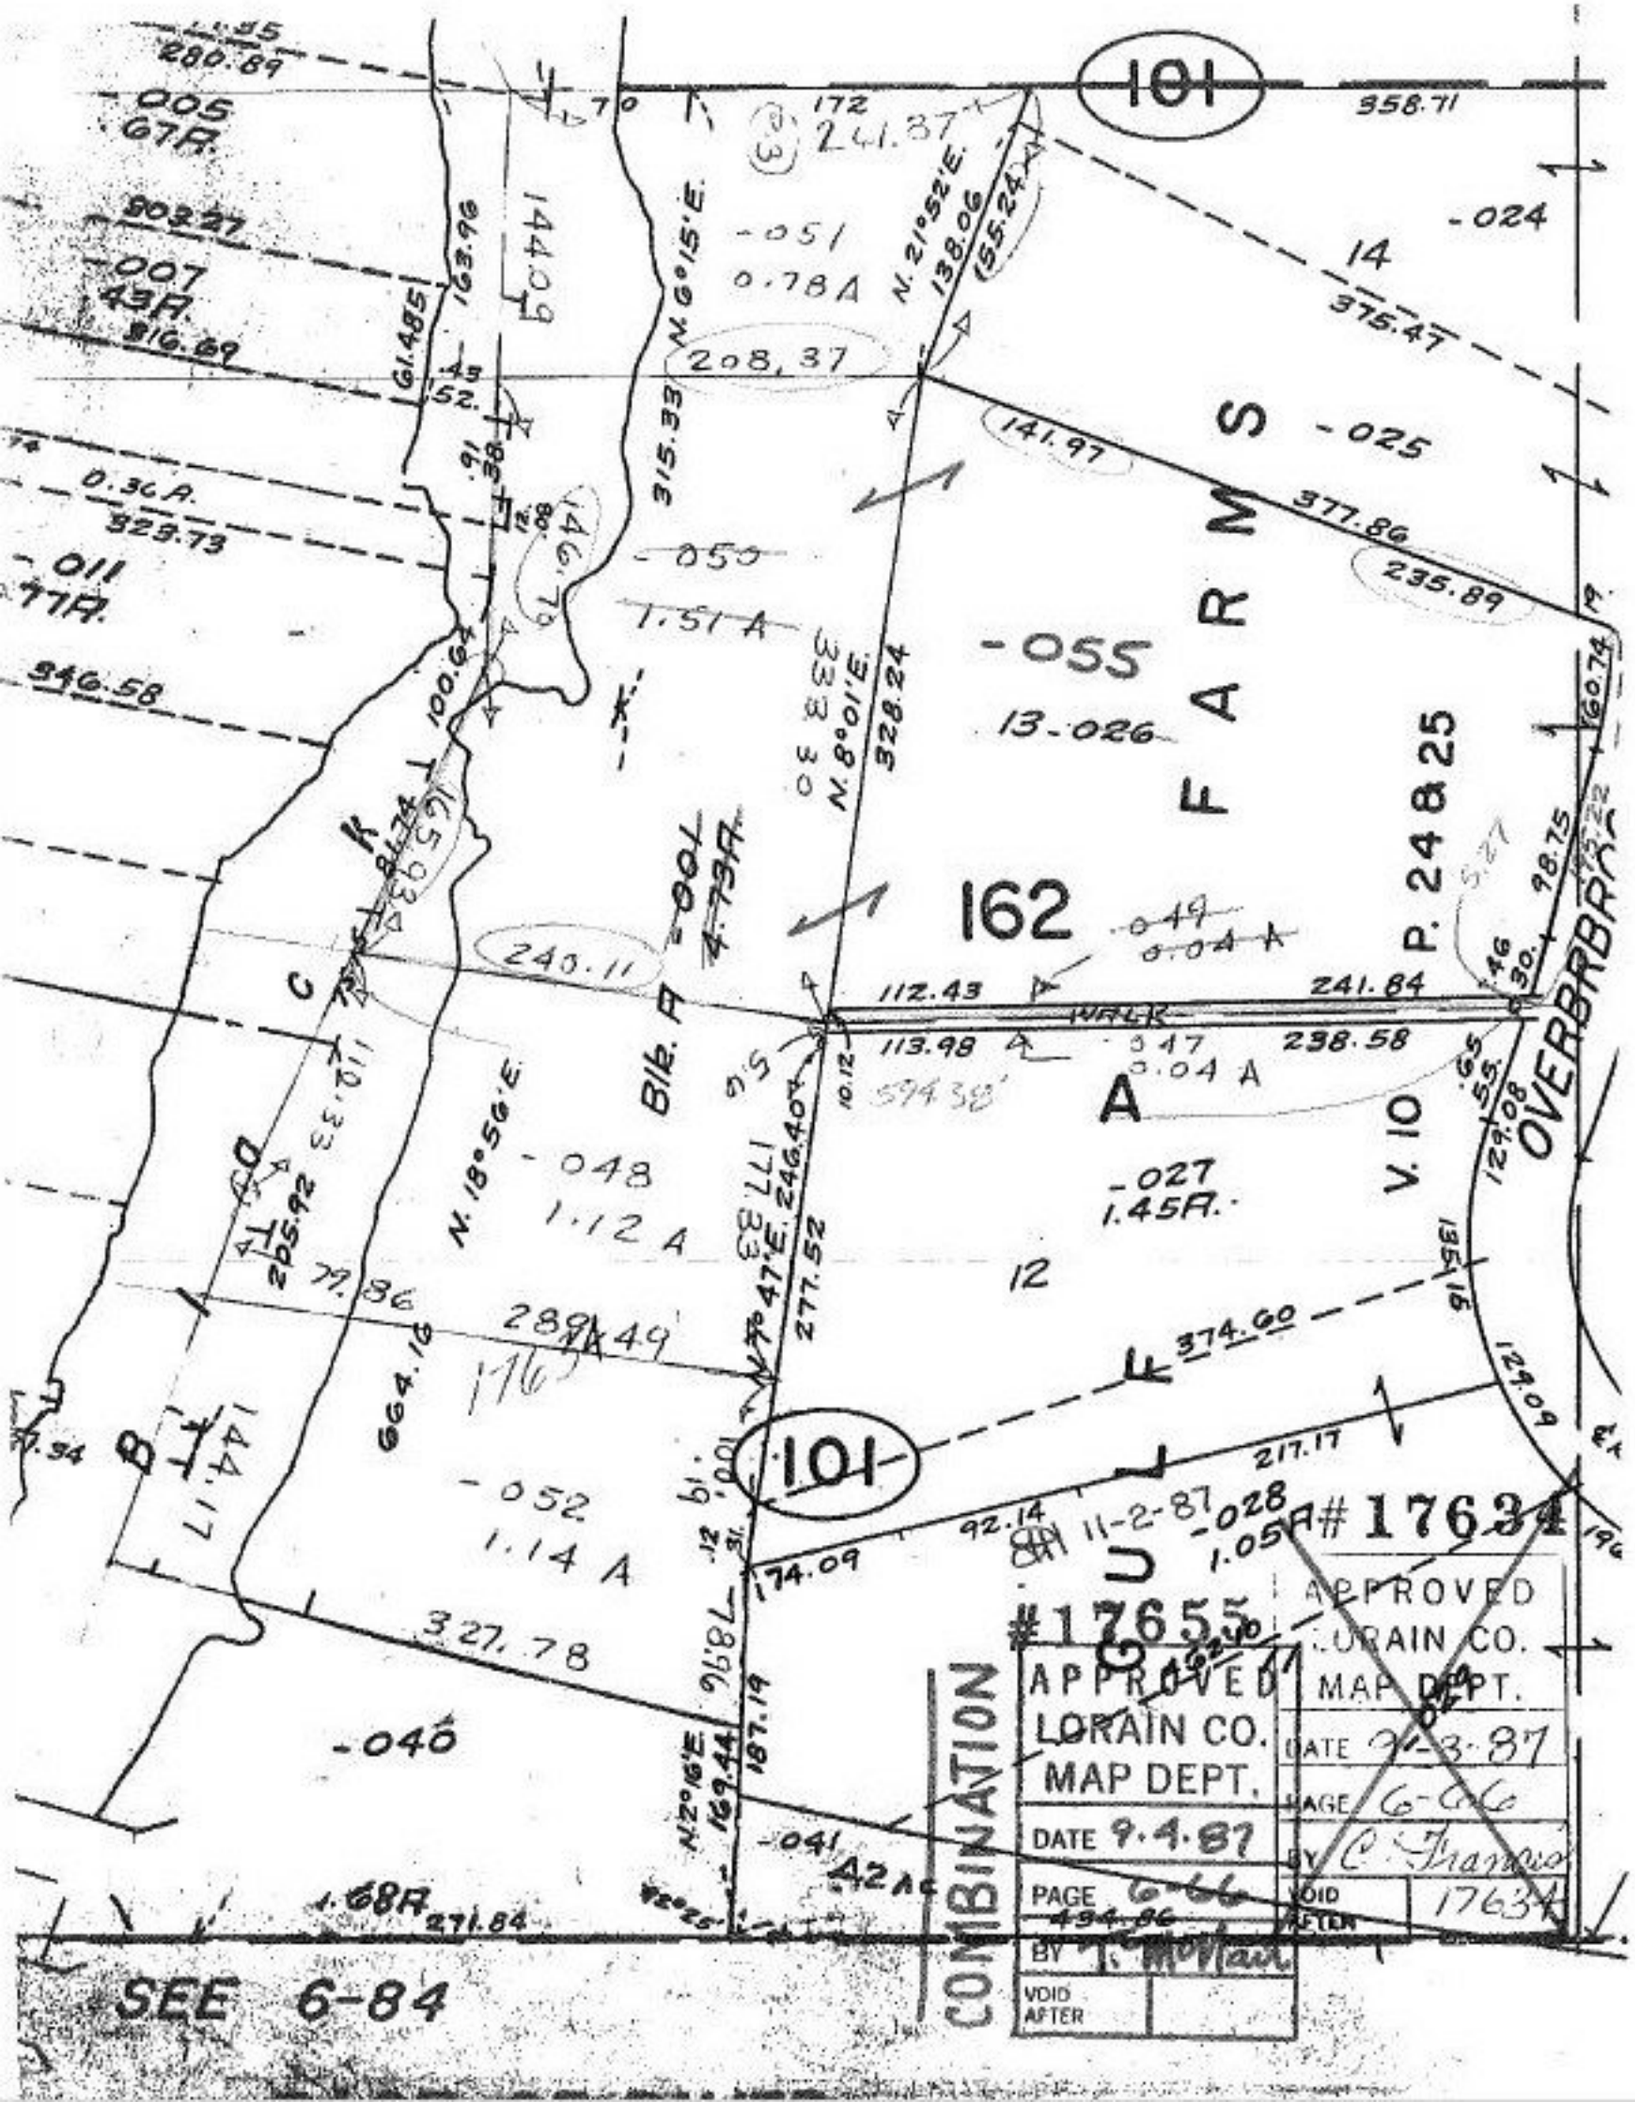
101
162
FARMS
GULF
OVERBRBROOK
P. 24 & 25
V. 10
A
12
14
-055
13-026
-027
1.45A.
-028
1.05A
-052
1.14 A
-048
1.12 A
-050
1.51 A
-051
0.78 A
-040
-041
-024
-025
-005
67A.
-007
43A.
-011
77A.
-001
4.73A.
Blk. A
N. 6°15'E.
N. 21°52'E.
N. 8°01'E.
N. 18°56'E.
N. 2°16'E.
208.37
141.97
235.89
240.11
112.43
113.98
241.84
238.58
374.60
217.17
174.09
327.78
289.49
664.16
144.09
144.17
144.17
358.71
375.47
377.86
328.24
277.52
246.40
169.44
187.19
271.84
434.86
SEE 6-84
COMBINATION
#17655
#17634
APPROVED
LORAIN CO.
MAP DEPT.
DATE 9-4-87
PAGE 6-66
BY
VOID AFTER
APPROVED
LORAIN CO.
MAP DEPT.
DATE 9-3-87
PAGE 6-66
BY C. Francis
VOID AFTER 17634