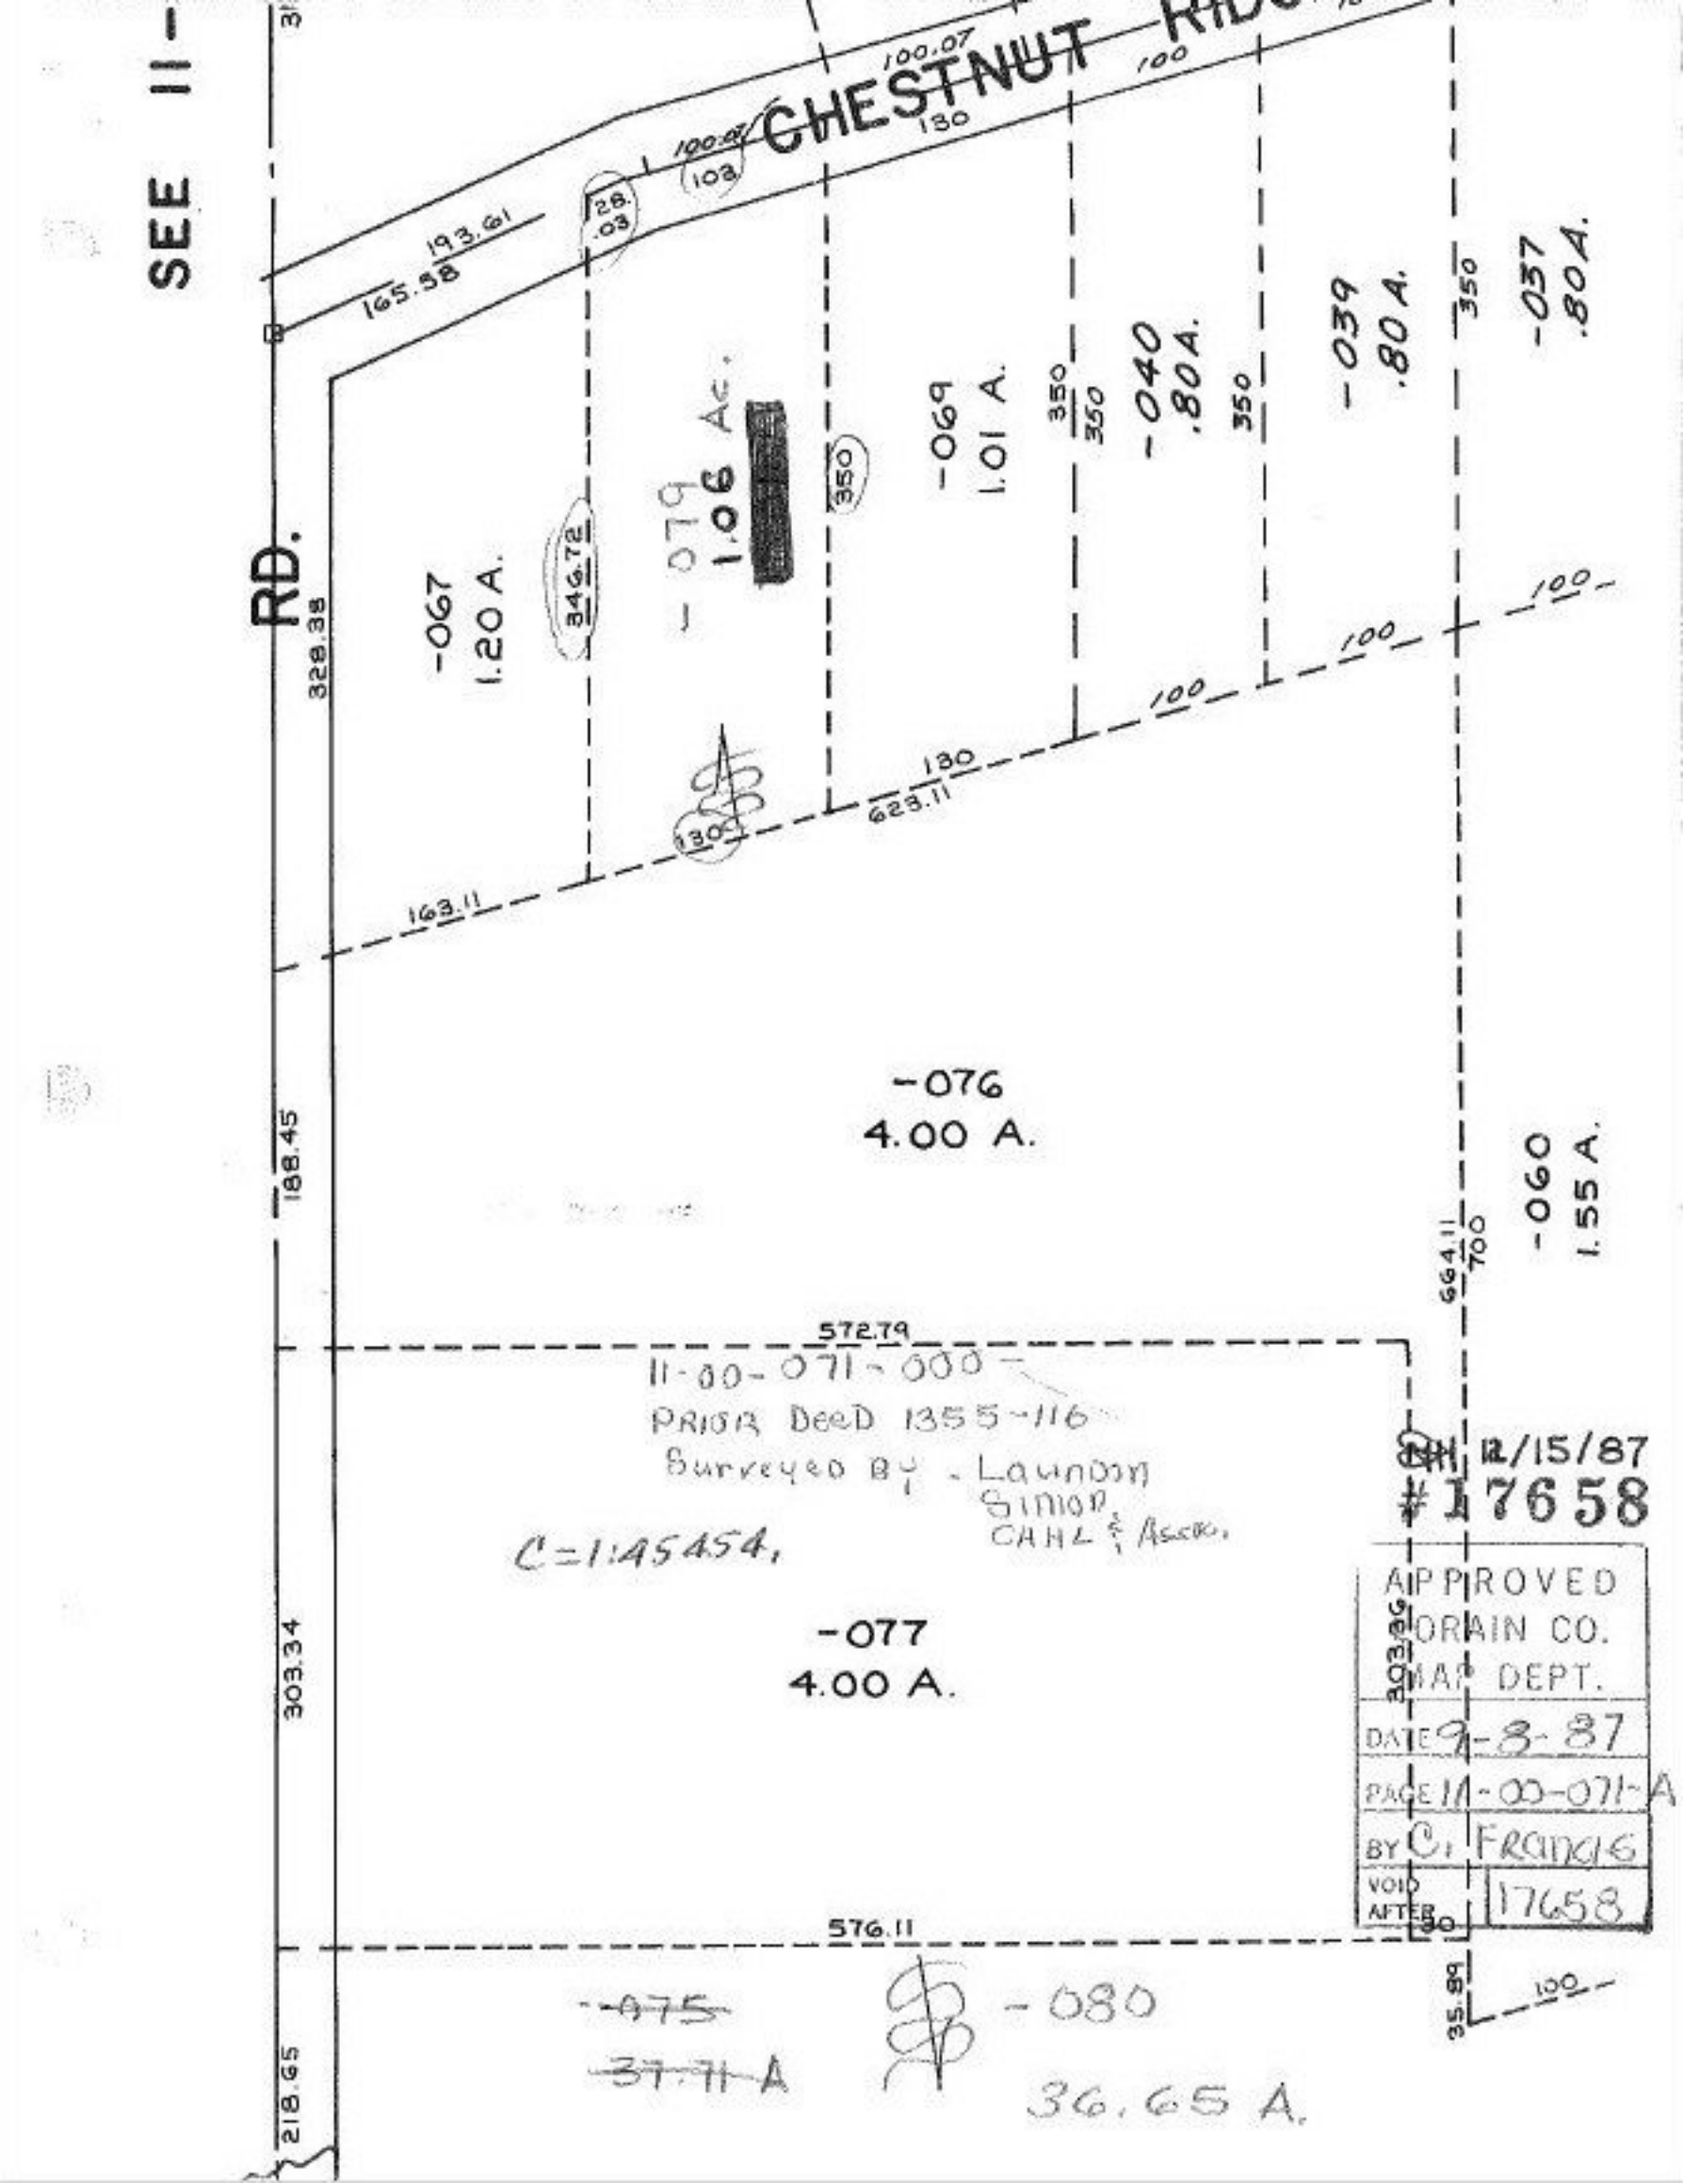
SEE 11-
CHESTNUT RIDGE
RD.
100.07
100
130
103
28.03
193.61
165.58
-067
1.20 A.
346.72
-079
1.06 Ac.
350
-069
1.01 A.
350
350
-040
.80 A.
350
-039
.80 A.
350
-037
.80 A.
328.38
100
100
100
100
130
623.11
130
163.11
-076
4.00 A.
188.45
-060
1.55 A.
664.11
700
572.79
11-00-071-000
PRIOR DEED 1355-116
Surveyed By - Launoon
Simon
CAHL & Assoc.
C=1:45454,
12/15/87
#17658
APPROVED
ORAIN CO.
MAP DEPT.
DATE 9-8-87
PAGE 11-00-071-A
BY C. Francis
VOID AFTER 17658
303.34
-077
4.00 A.
303.36
576.11
35.89
100
~~-075~~
~~37.71 A~~
-080
36.65 A.
218.65