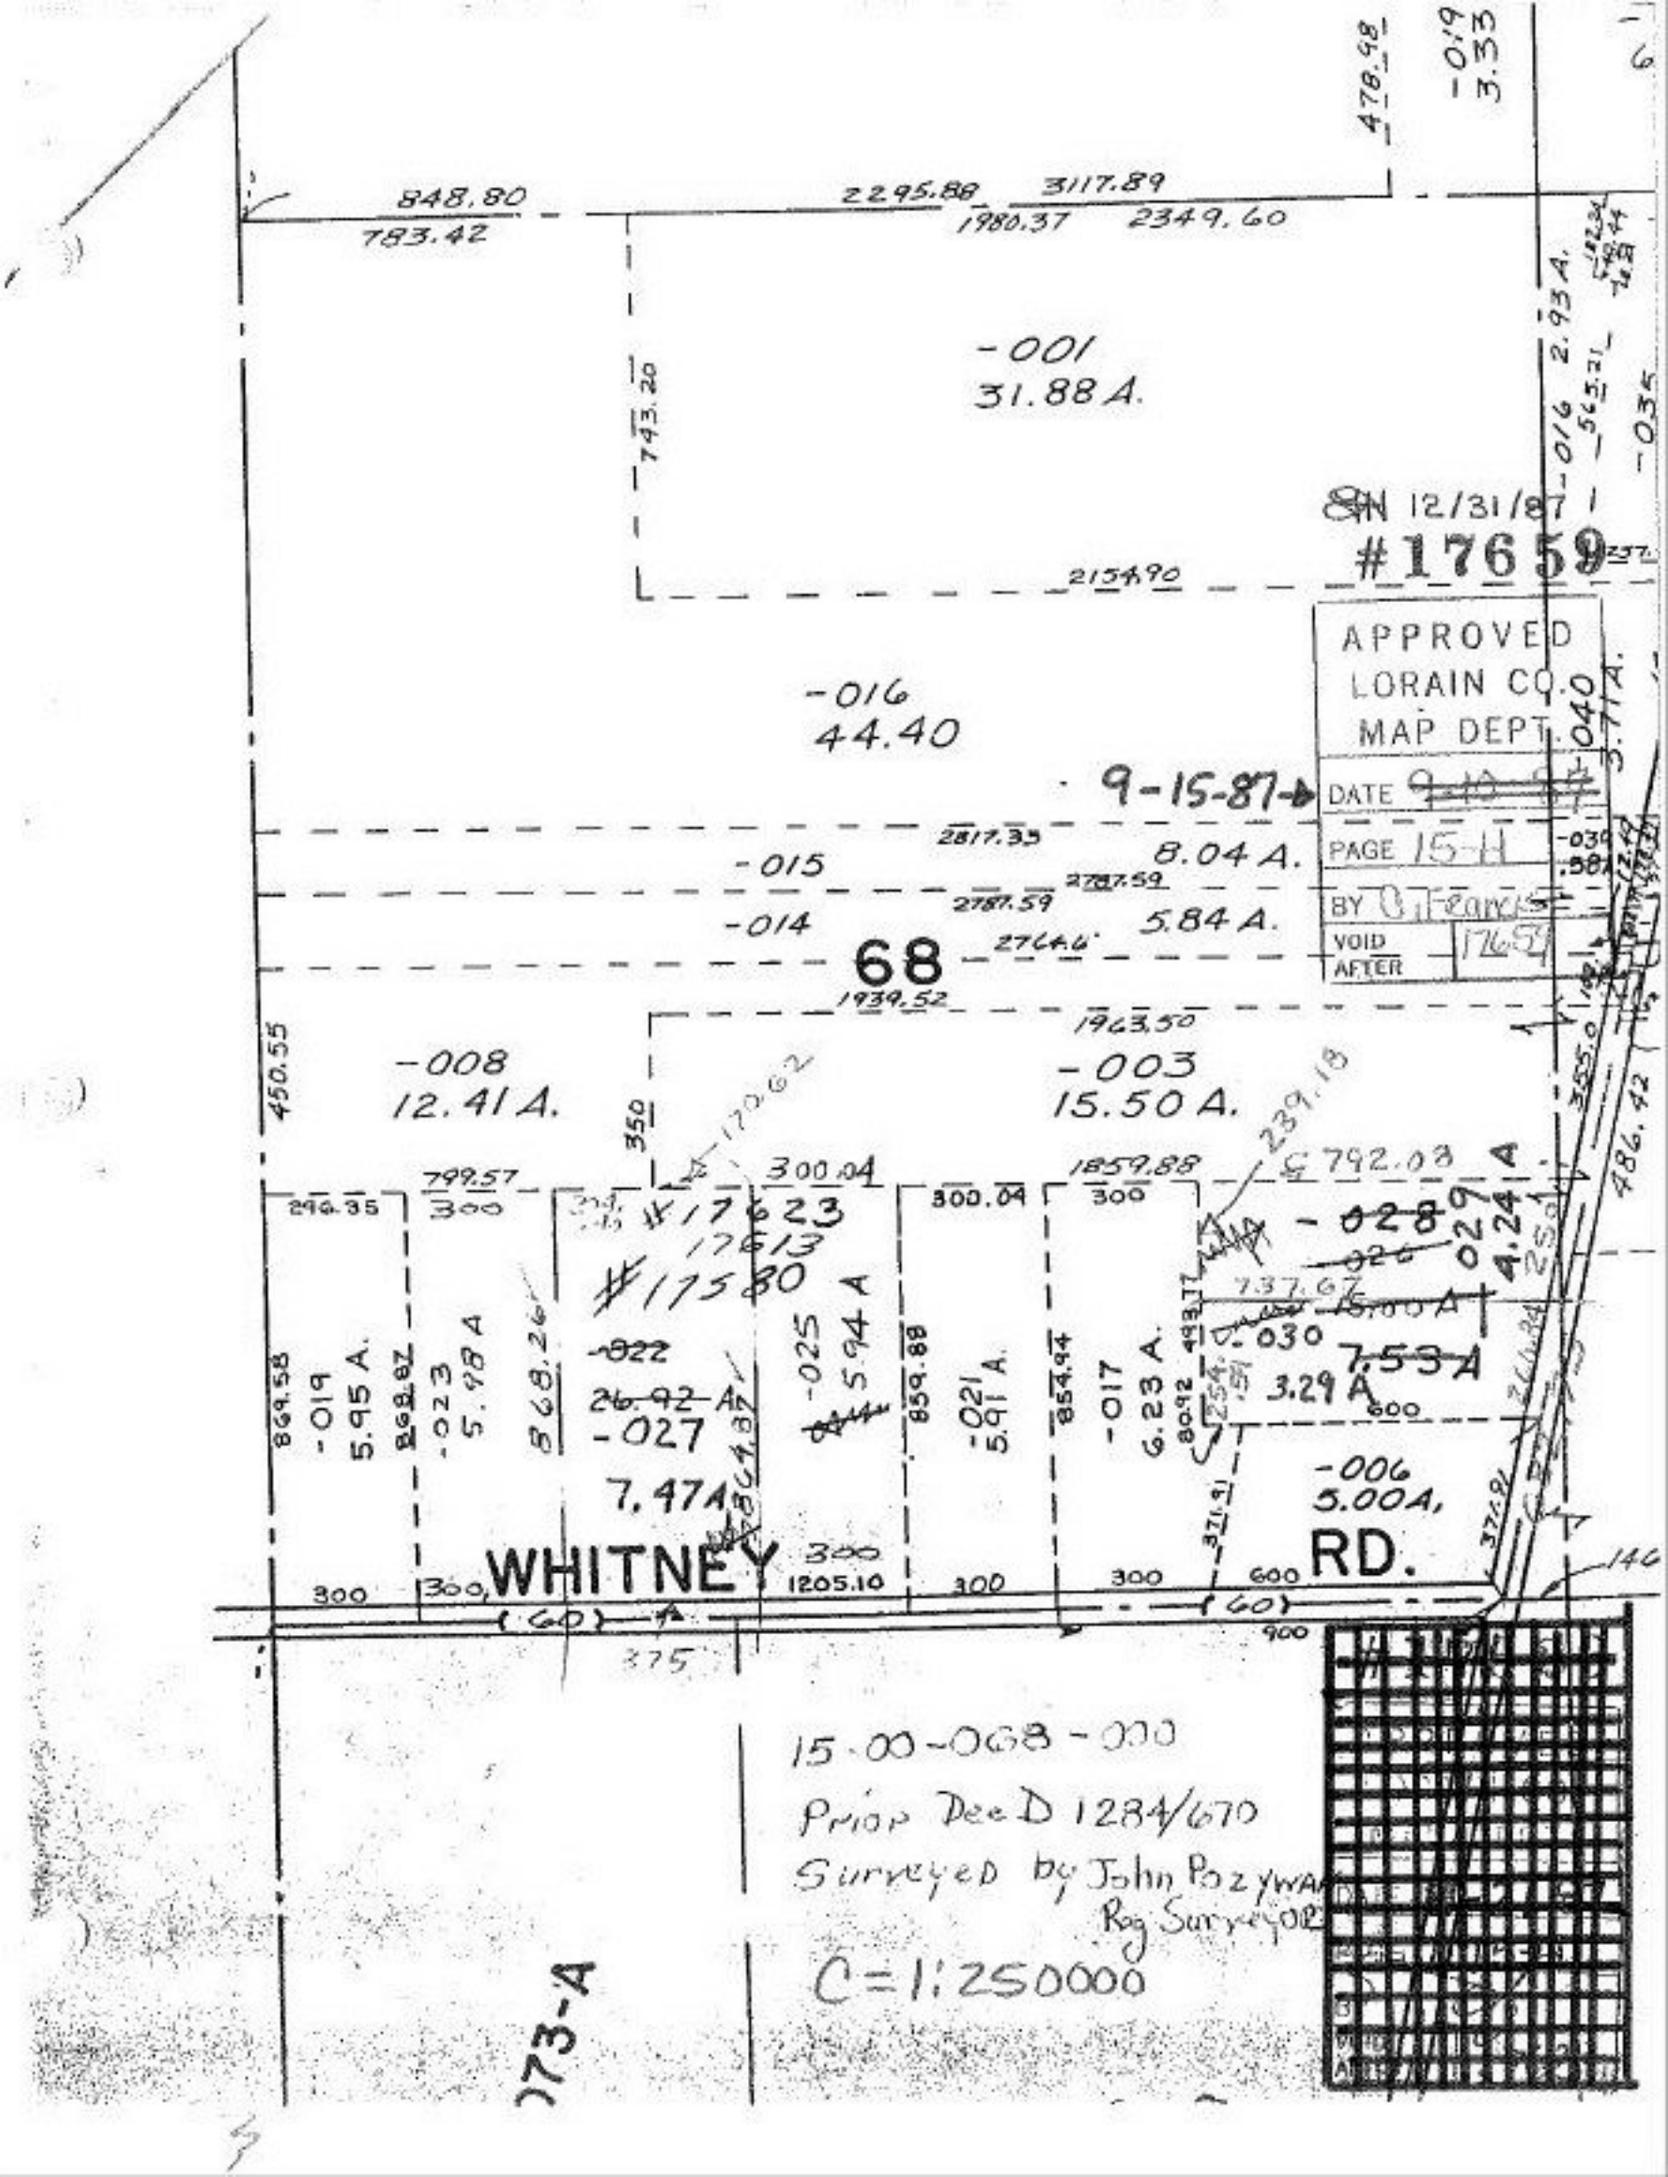

848.80
783.42
2295.88
3117.89
1980.37
2349.60
478.98
-019
3.33
-001
31.88 A.
743.20
2154.90
-016
44.40
9-15-87
2817.33
8.04 A.
-015
2787.59
-014
5.84 A.
68
1939.52
1963.50
-008
12.41 A.
-003
15.50 A.
450.55
350
799.57
300.04
1859.88
792.08
296.35
300
#17623
17613
#17580
-028
029
4.24 A
737.67
-030
7.53 A
3.29 A
869.58
-019
5.95 A.
868.87
-023
5.98 A
868.26
-022
26.92 A
-027
7.47 A
-025
5.94 A
859.88
-021
5.91 A.
854.94
-017
6.23 A.
-006
5.00 A.
WHITNEY
RD.
1205.10
300
600
(60)
375
900
15-00-068-000
Prior Dee D 1284/670
Surveyed by John Pozywa
Reg Surveyor
C=1:250000
073-A
APPROVED
LORAIN CO.
MAP DEPT.
DATE
PAGE 15-H
BY
VOID AFTER
17659
12/31/87
#17659