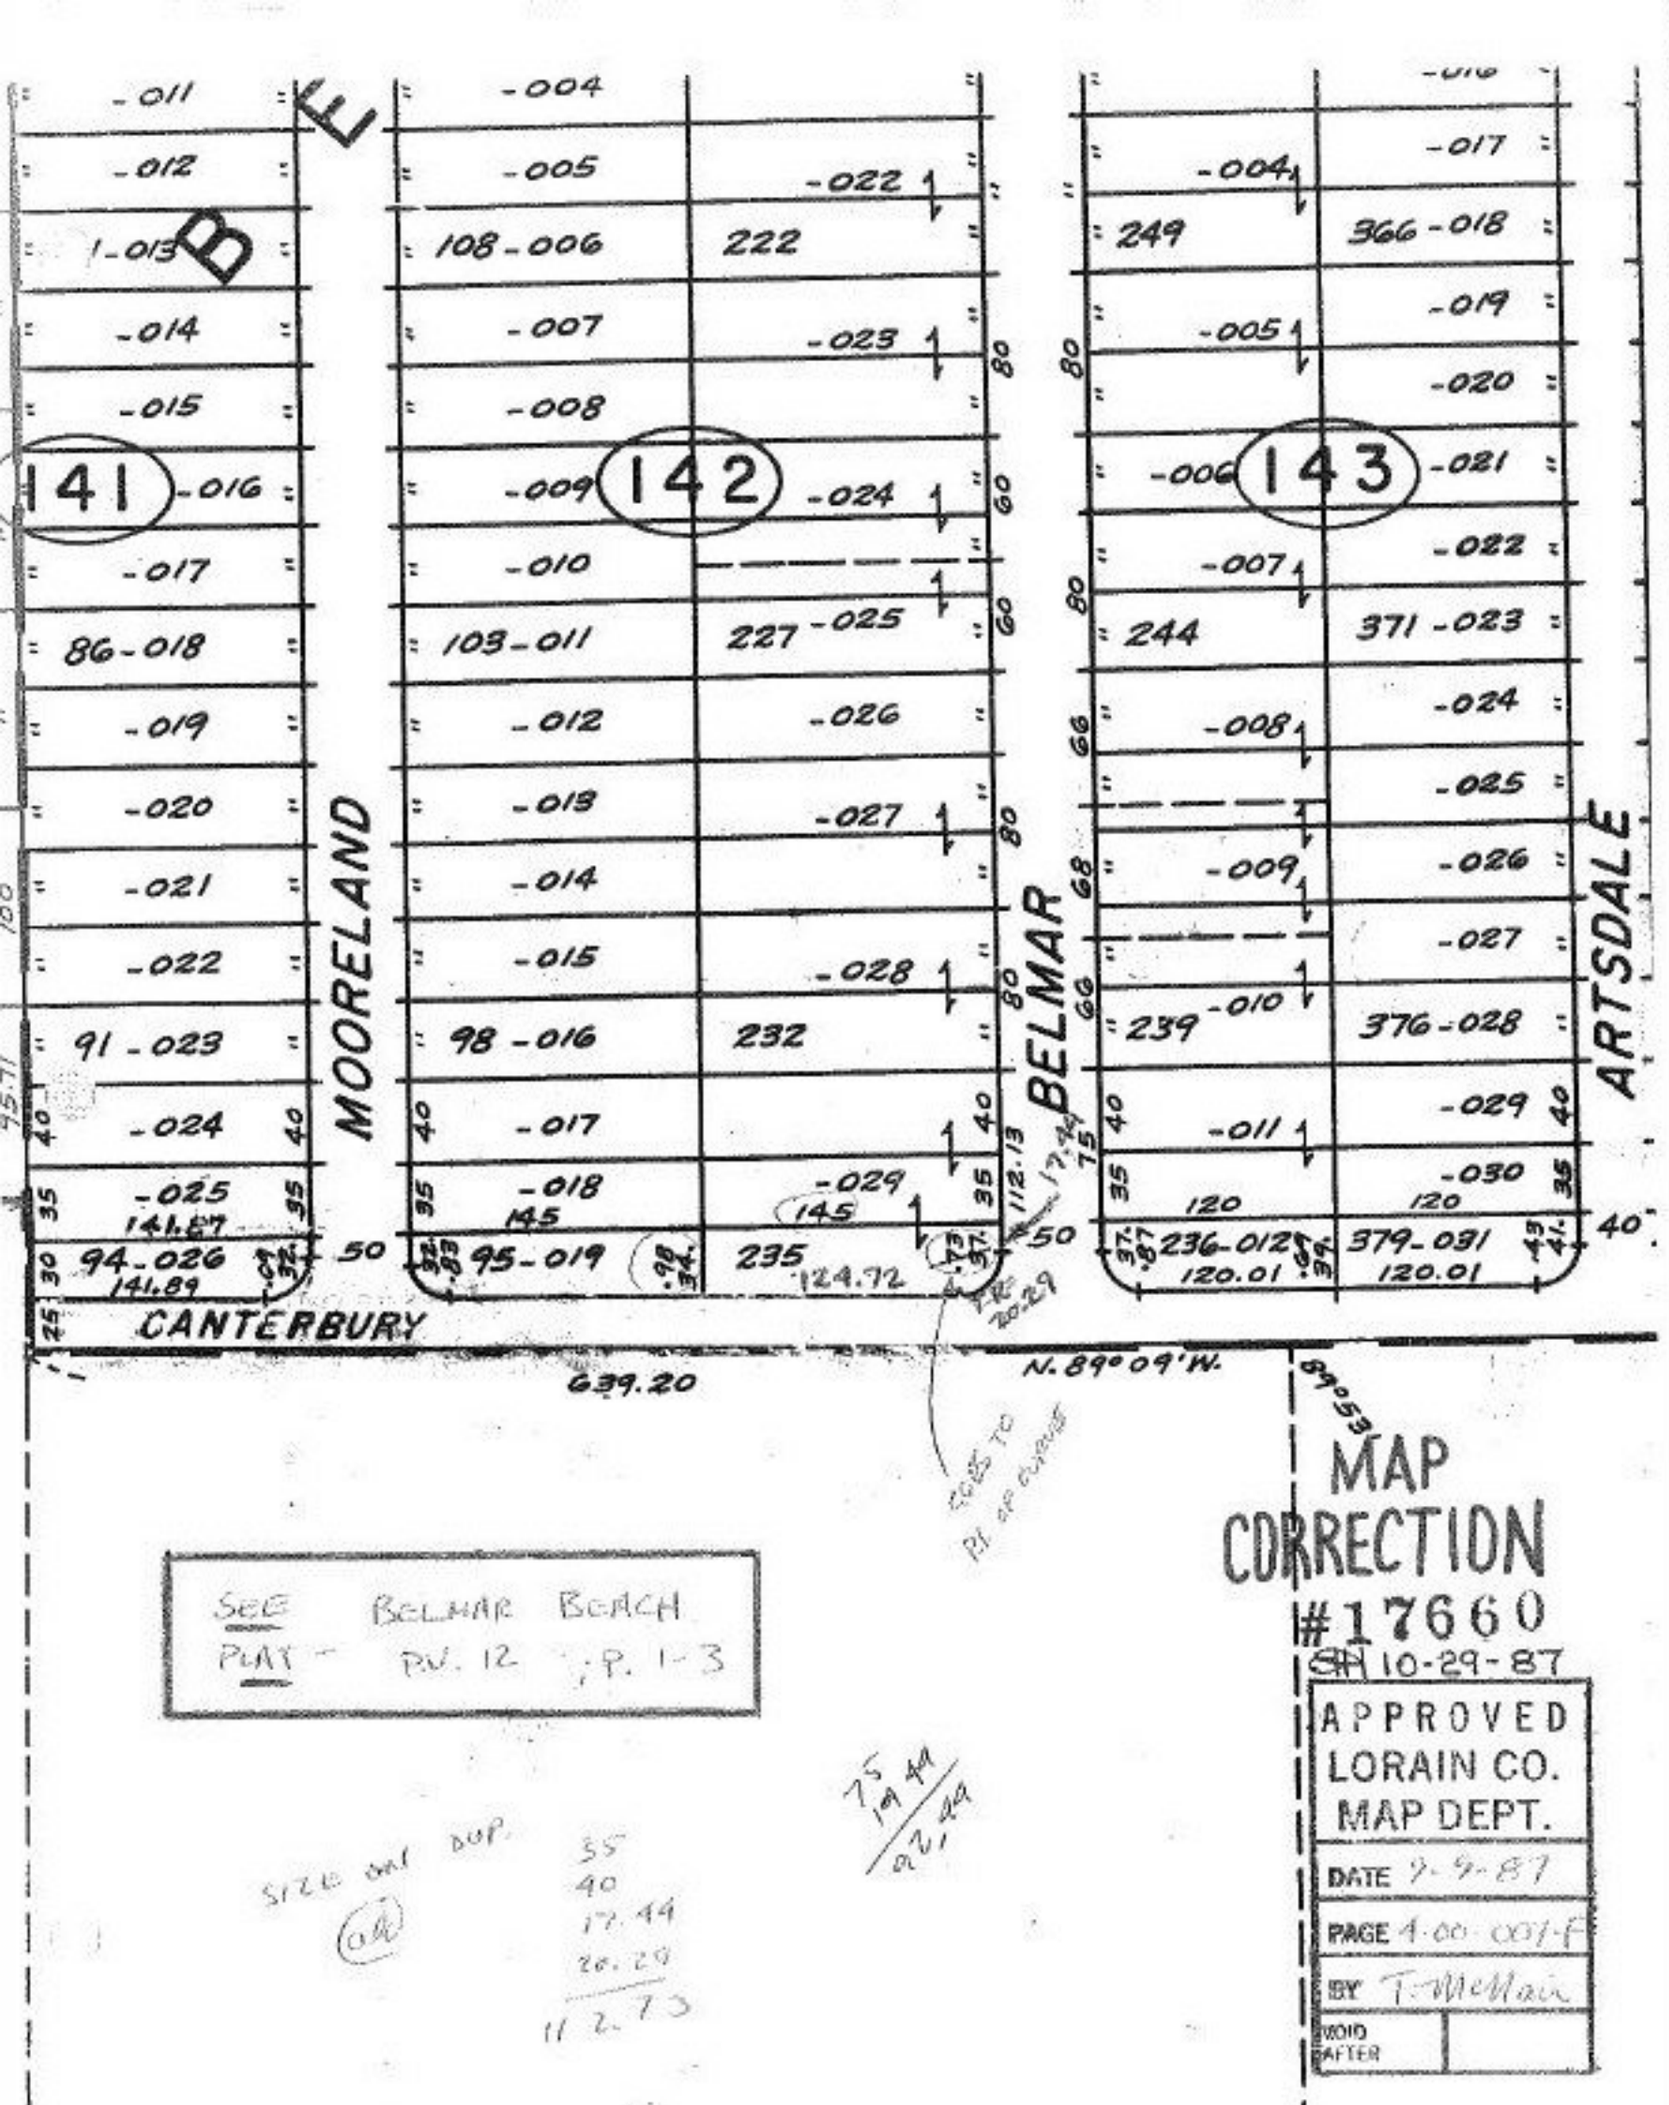
-011
-012
1-013
-014
-015
141
-016
-017
86-018
-019
-020
-021
-022
91-023
-024
-025
141.67
94-026
141.89
MOORELAND
-004
-005
108-006
-007
-008
142
-009
-010
103-011
-012
-013
-014
-015
98-016
-017
-018
145
95-019
-022
222
-023
-024
227-025
-026
-027
-028
232
-029
145
235
124.72
BELMAR
-004
249
-005
-006
143
-007
244
-008
-009
239-010
-011
120
236-012
120.01
-017
366-018
-019
-020
-021
-022
371-023
-024
-025
-026
-027
376-028
-029
-030
120
379-031
120.01
ARTSDALE
CANTERBURY
639.20
N. 89° 09' W.
CURVE TO PT OF CURVE
MAP CORRECTION #17660
10-29-87
APPROVED LORAIN CO. MAP DEPT.
DATE 2-9-87
PAGE 4.00-001-F
BY T. McMain
VOID AFTER
SEE PLAT - BELMAR BEACH PV. 12 ; P. 1-3
SIZE OK! DUP.
35
40
17.44
20.29
11 2.73
7.5
19.44
0.21