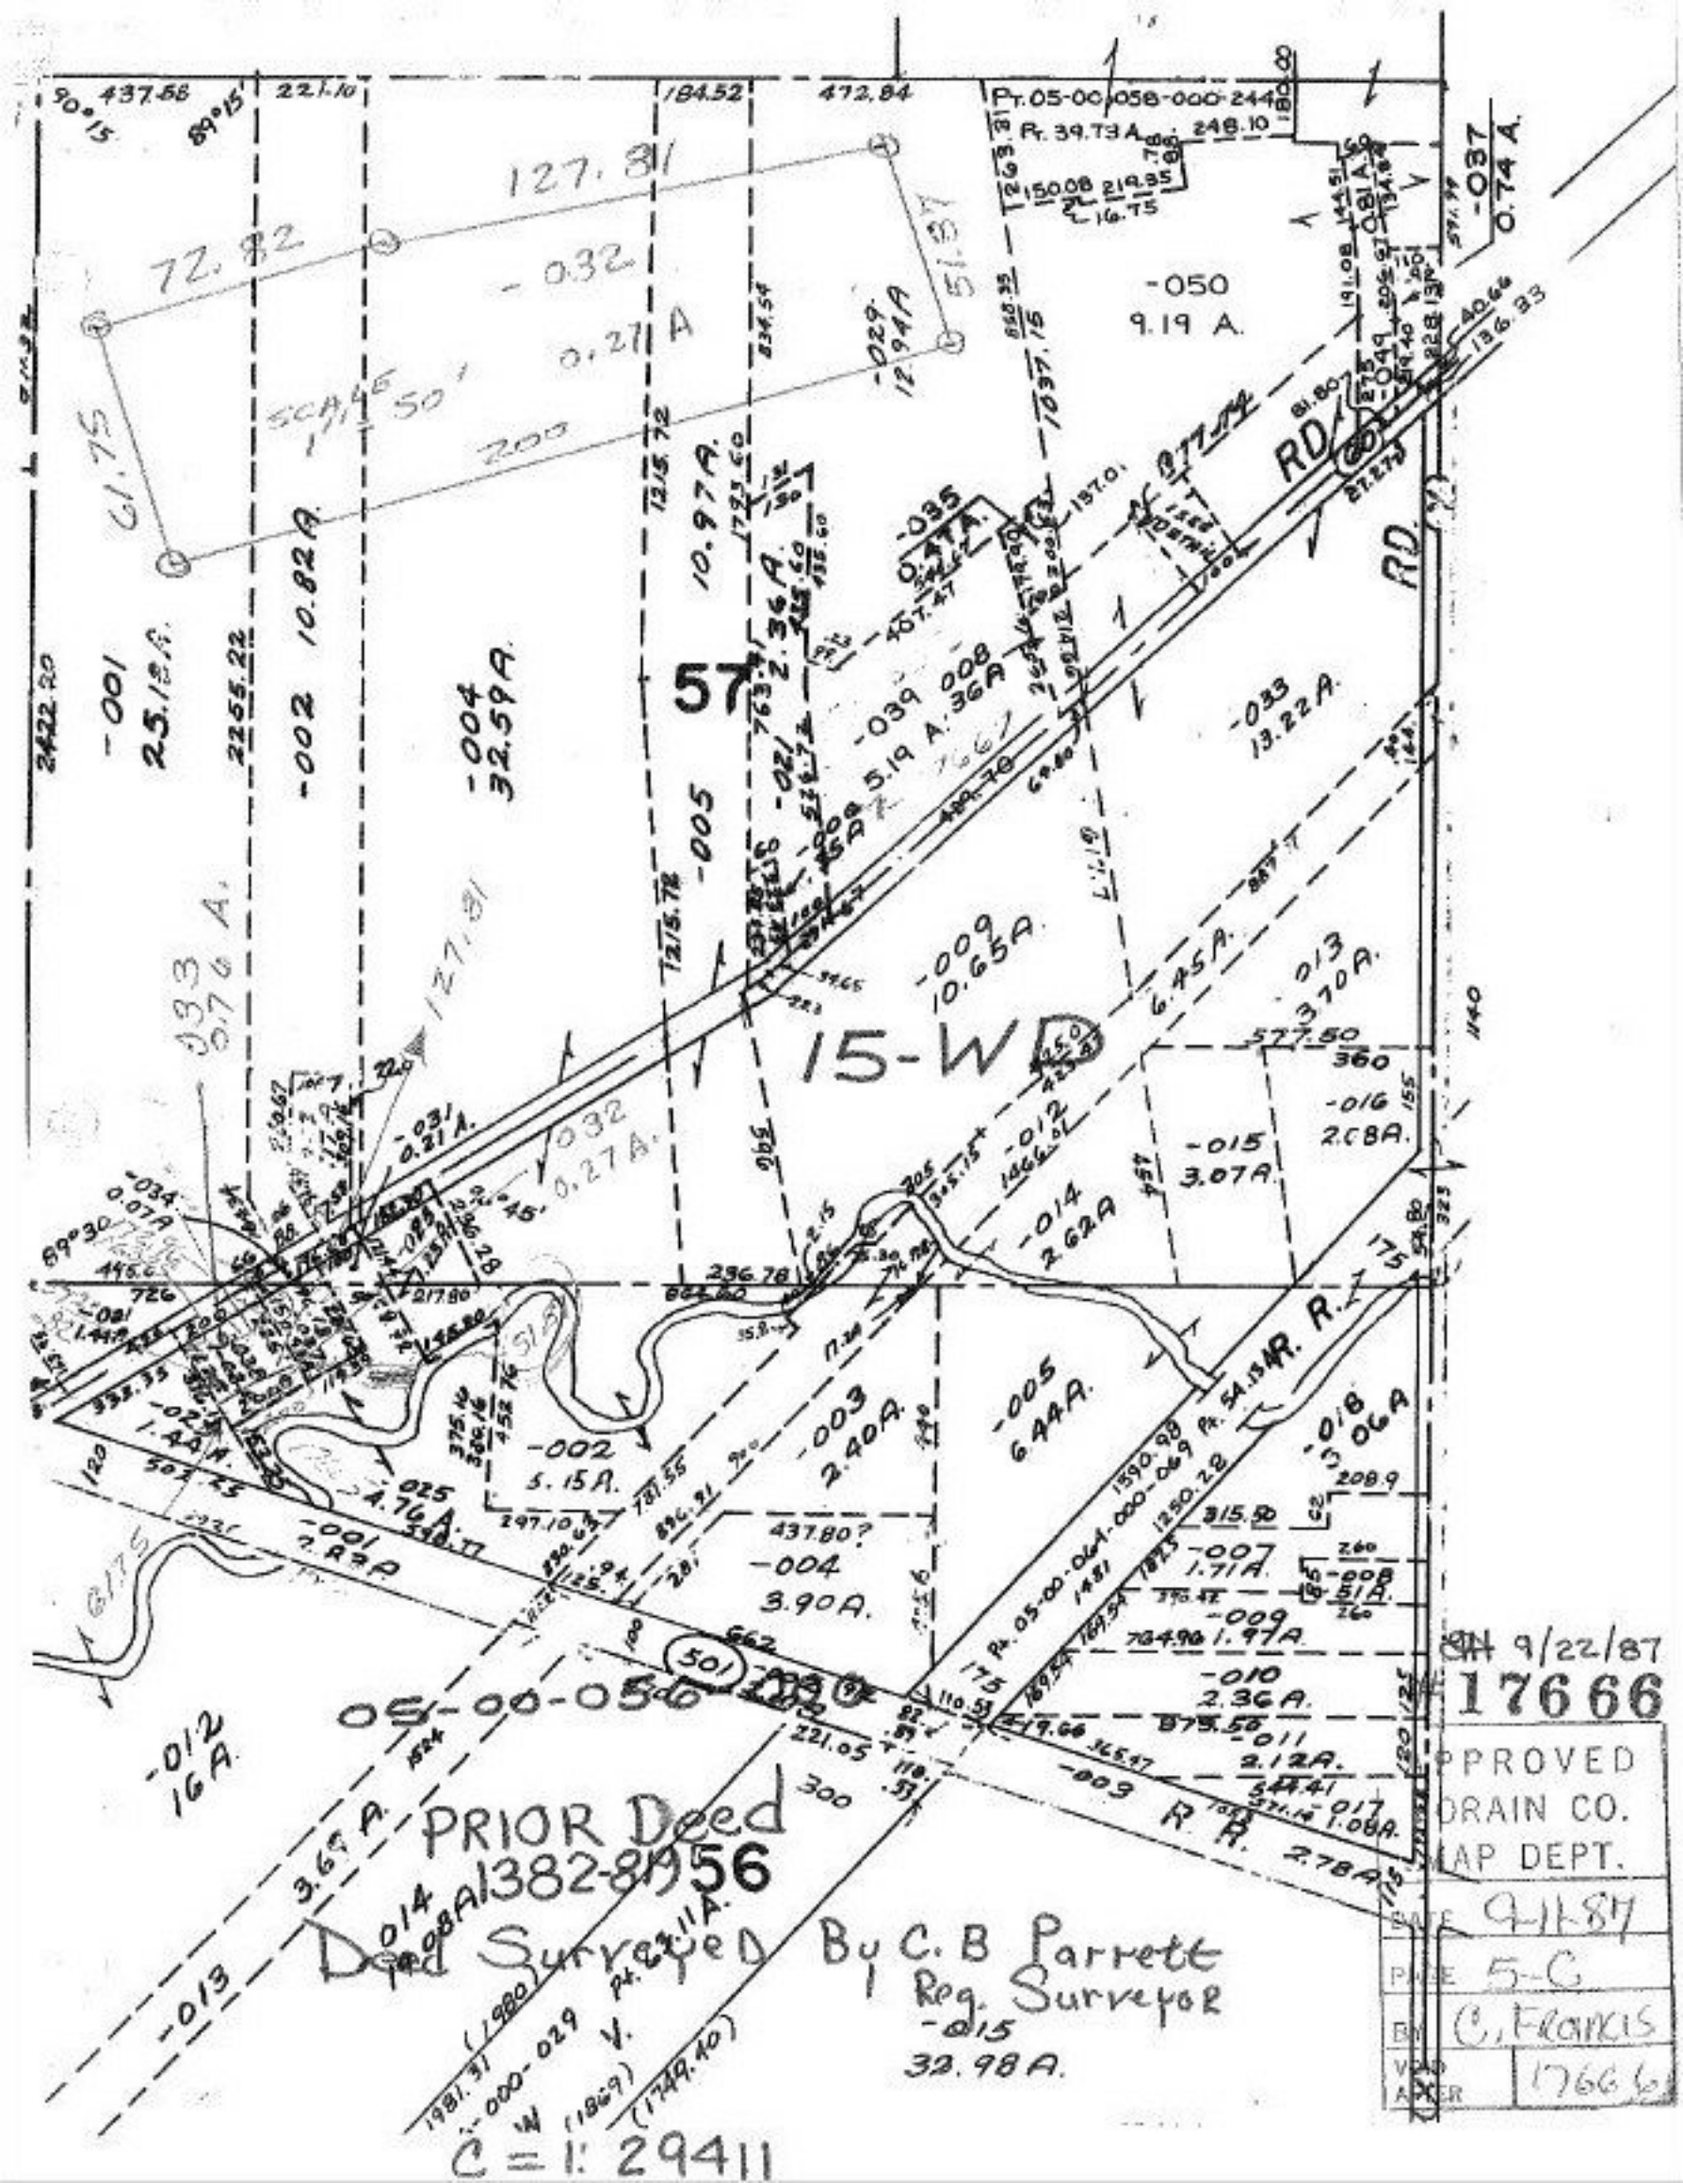

9/22/87
#17666

APPROVED
DRAIN CO.
MAP DEPT.

DATE	9-11-87
PAGE	5-C
BY	C. Francis
VOID AFTER	17666