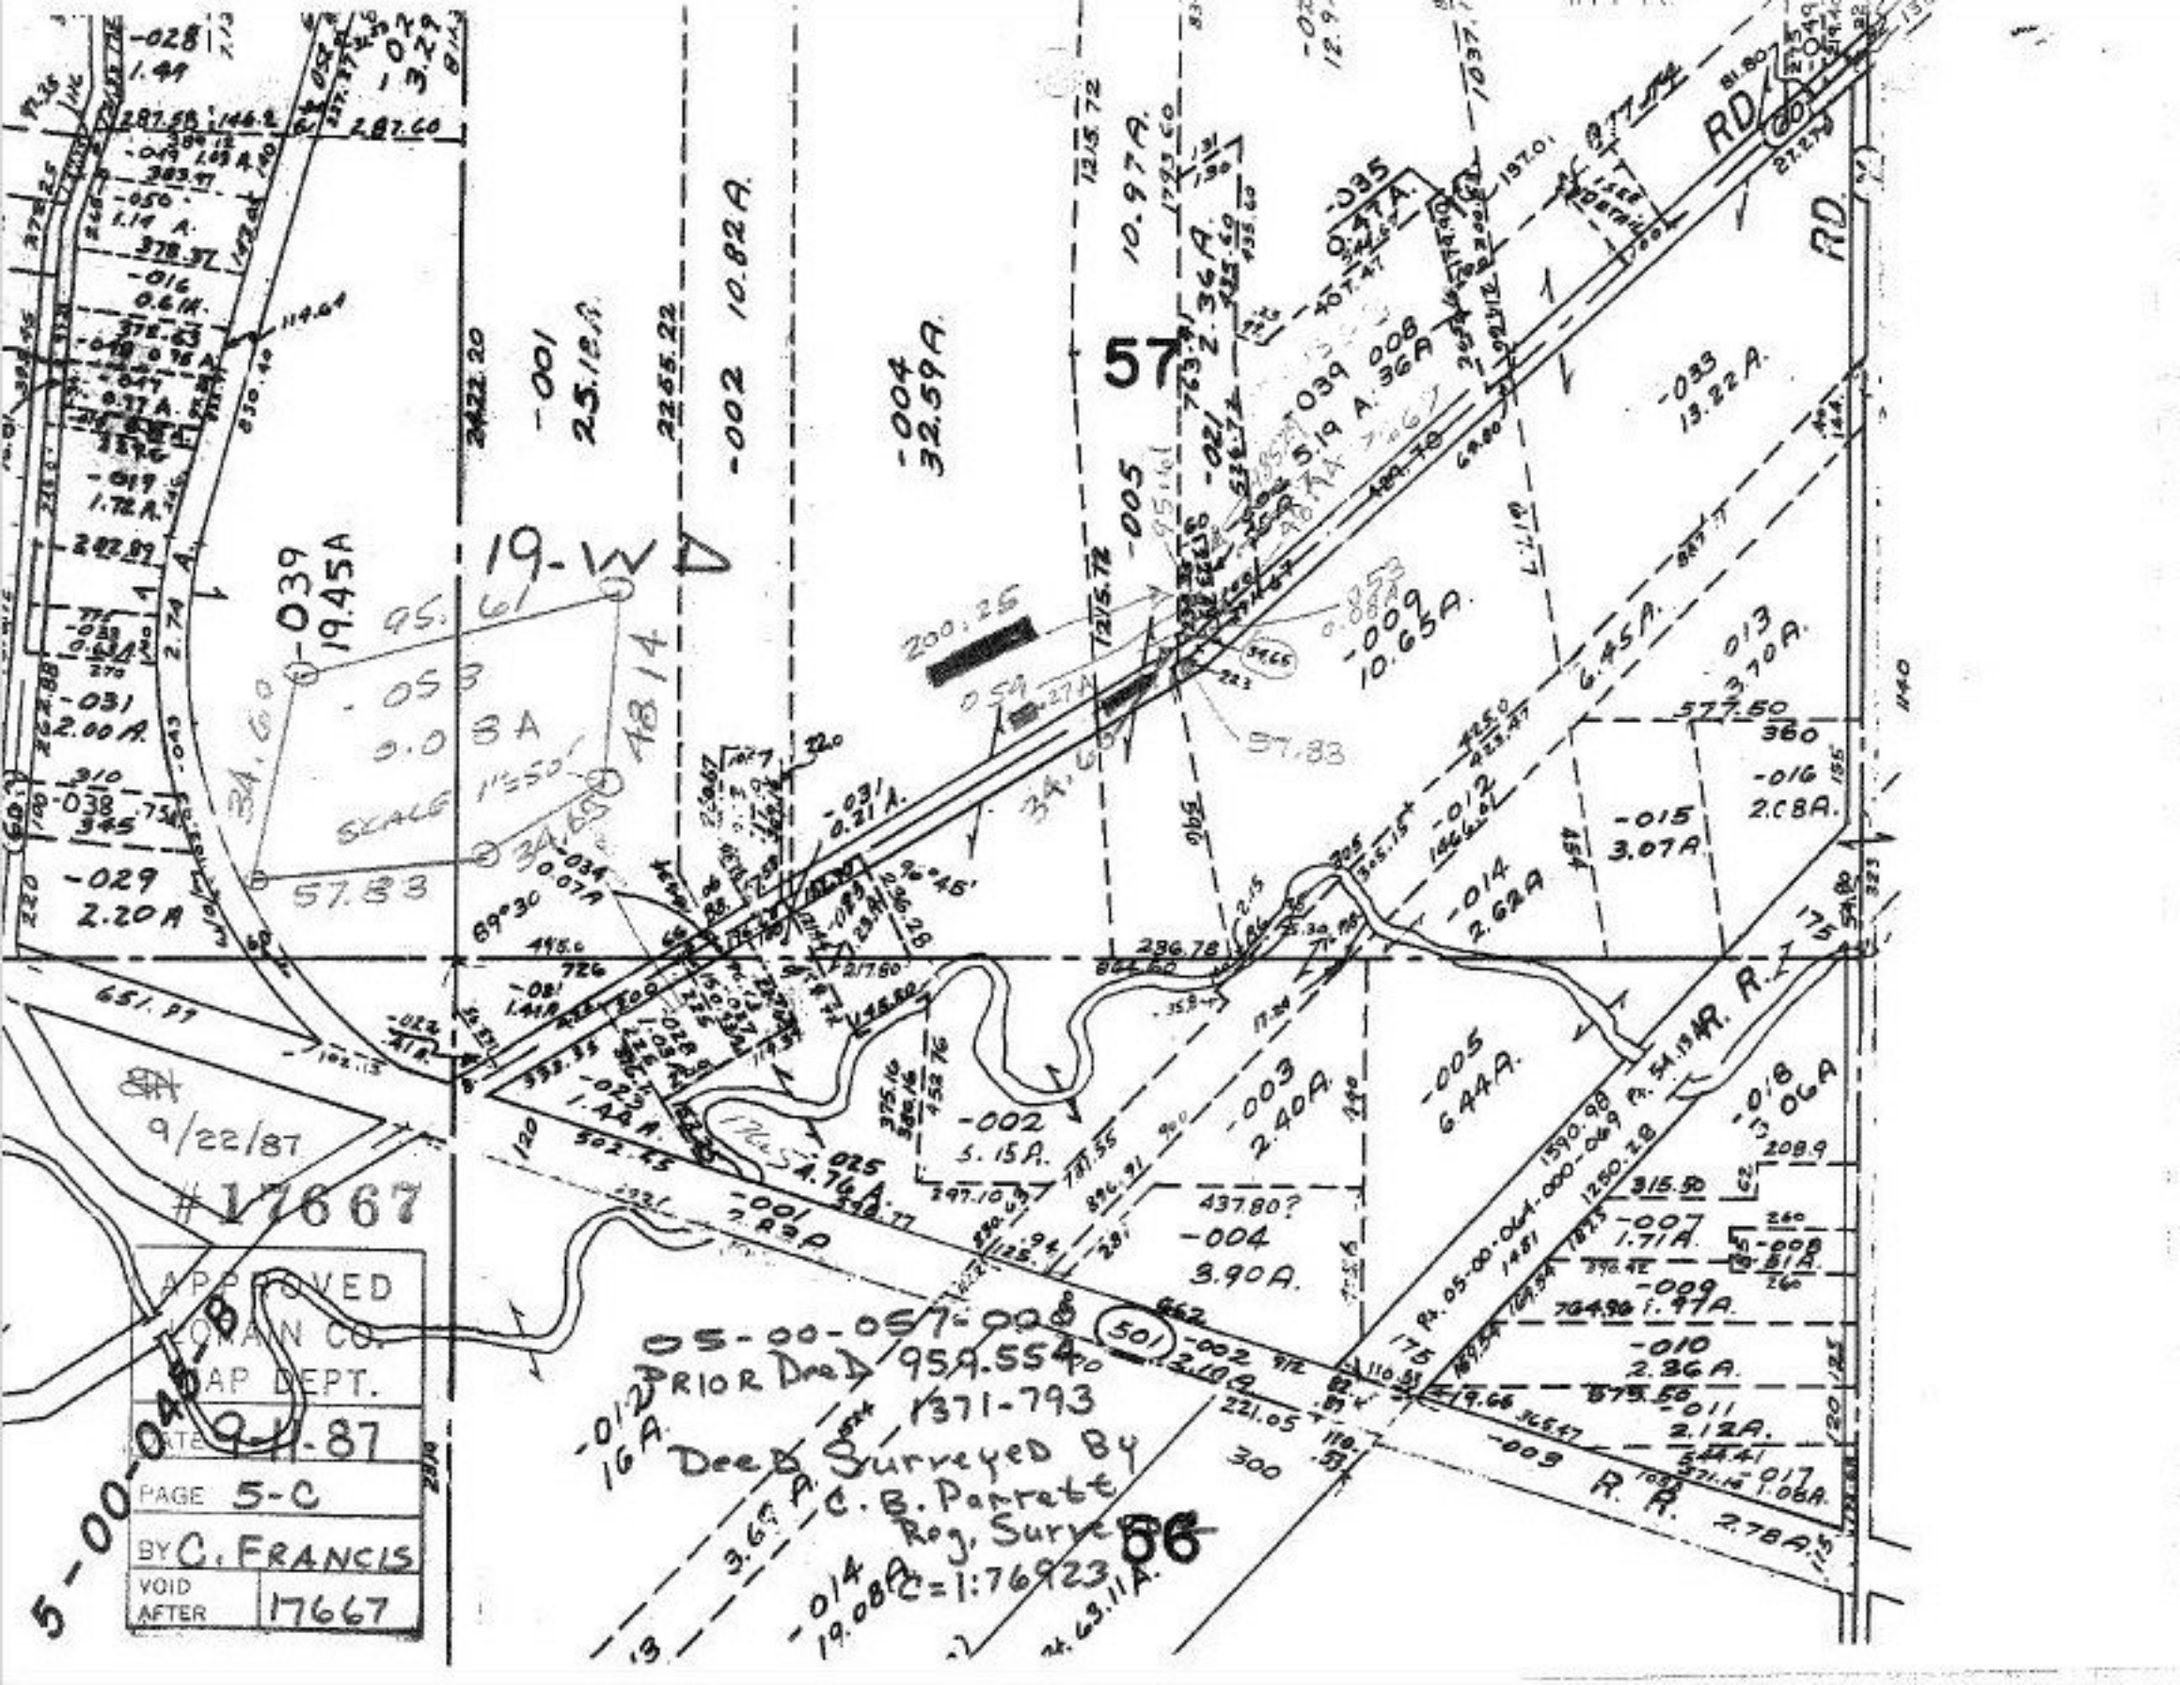
RD
R. R.
SCALE 1"=50'
9/22/87
#17667
APPROVED
MAP DEPT.
DATE 9-11-87
PAGE 5-C
BY C. FRANCIS
VOID AFTER 17667
5-00-045-8
05-00-057-008
PRIOR DesA 959.554
1371-793
Deed Surveyed By
C. B. Parratt
Reg. Surveyor
C=1:76923
18 14
57
86
501
-039 19.45A
-058 9.0 BA
-029 2.20A
-031 2.00A.
-001 25.12A.
-002 10.82A.
-004 32.59A.
-005 10.97A.
-009 10.65A.
-033 13.22A.
-035 0.47A.
-003 2.40A.
-005 6.44A.
-004 3.90A.
-010 2.36A.
-011 2.12A.
-009 2.78A.
-007 1.71A.
-008 1.81A.
-009 1.97A.
-017 1.06A.
-018 1.06A.
-016 2.08A.
-015 3.07A.
-014 2.62A.
-012 16A.
-002 5.15A.
-001 2.89A.
-013 3.70A.
-014 19.08A.
-063 11A.
-025 1.74A.
-022 1.44A.
-021 0.21A.
-034 0.07A.
-027 0.54A.
-028 1.49
-050 1.14 A.
-016 0.61A.
-048 0.76A.
-047 0.77A.
-019 1.72A.
-038 2.74 A.
-043 0.85A.
-010 1.44A.
-012 1.66A.
-024 0.41A.
-026 1.44A.
-023 1.44A.
-022 1.44A.
-021 0.21A.
-034 0.07A.
-027 0.54A.
-035 0.47A.
