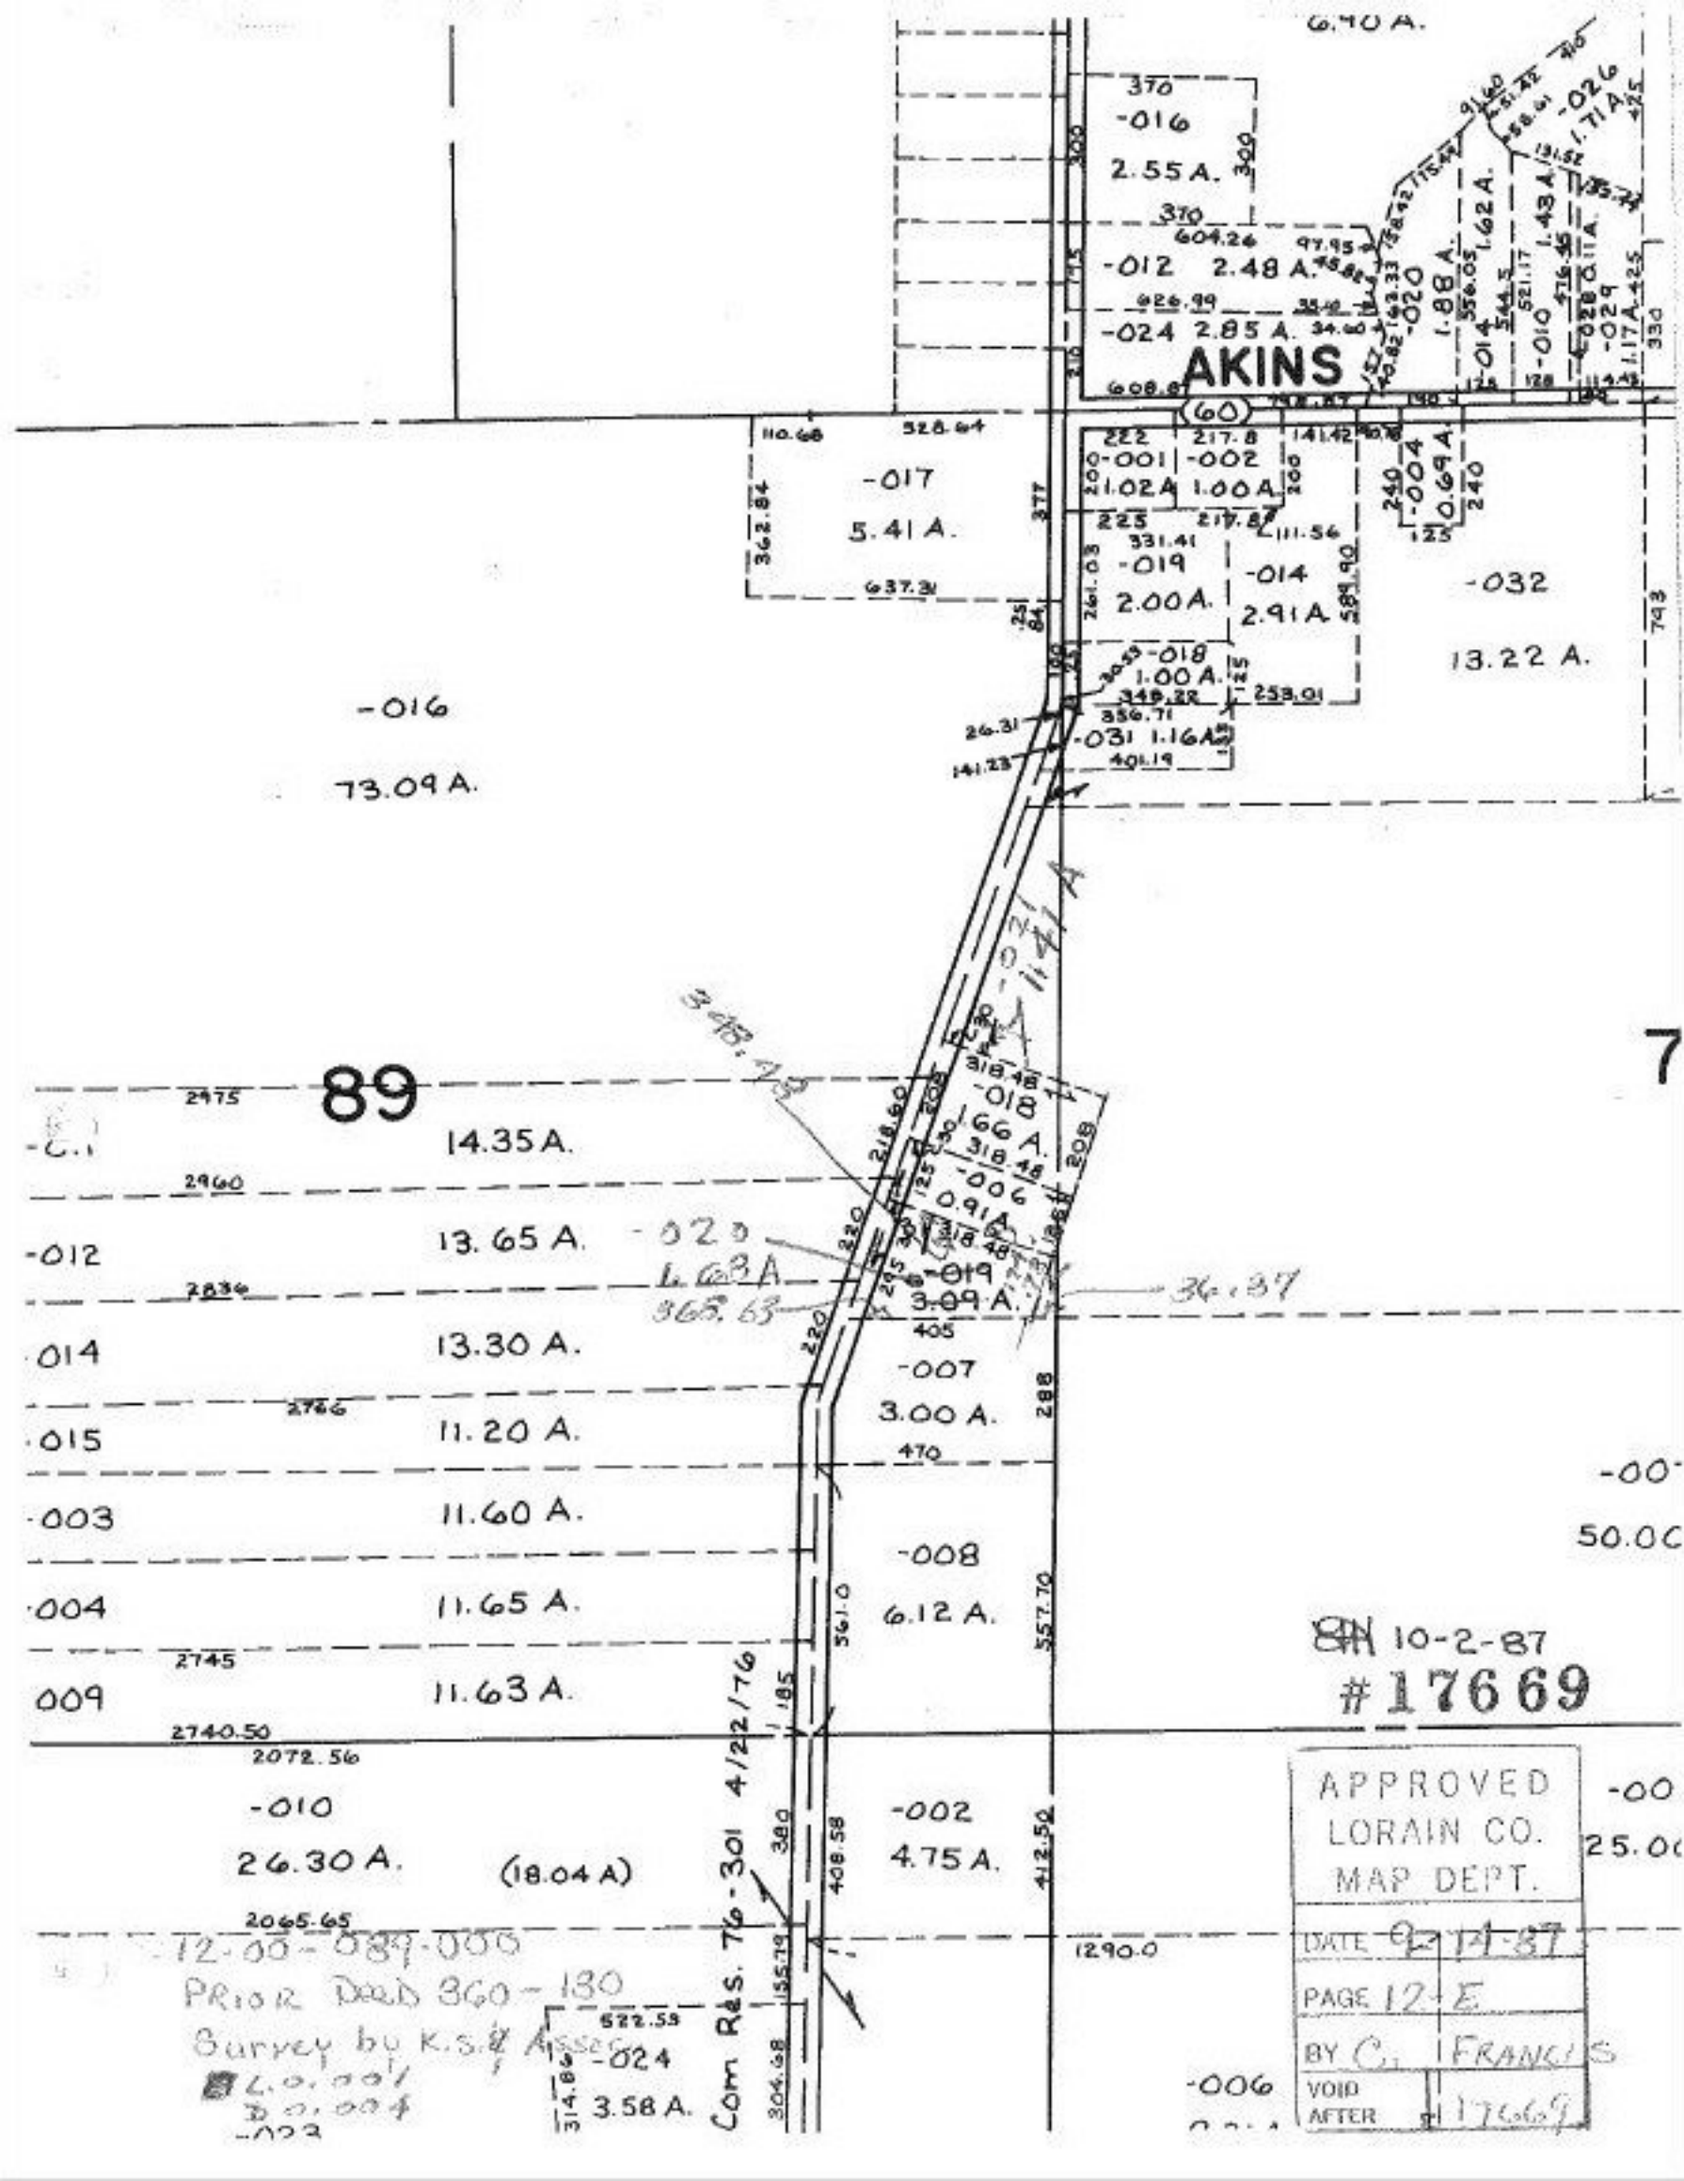
AKINS
89
-016
73.09 A.
-017
5.41 A.
-019
2.00A.
-014
2.91A.
-032
13.22 A.
-018
1.00A.
-031 1.16A
-001
21.02A
-002
1.00A
-004
0.69A
-026
1.71A
-027
1.43A
-028
0.11A
-029
1.17A
-020
1.88A.
-012 2.48 A.
-024 2.85 A.
-016
2.55 A.
14.35A.
13.65 A.
13.30 A.
11.20 A.
11.60 A.
11.65 A.
11.63 A.
-010
26.30 A.
(18.04 A)
-007
3.00 A.
-008
6.12 A.
-002
4.75 A.
-006
0.91A
-021
1.41A
-022
1.66A
-019
3.09 A.
-024
3.58 A.
6.90 A.
Com R&S. 76-301 4/22/76
10-2-87
#17669
APPROVED
LORAIN CO.
MAP DEPT.
DATE 9-11-87
PAGE 12-E
BY C. FRANCIS
VOID AFTER 17669
12-00-089.000
PRIOR Deed 360-130
Survey by K.S. & Assoc.
L.O. 001
D.O. 004
-023