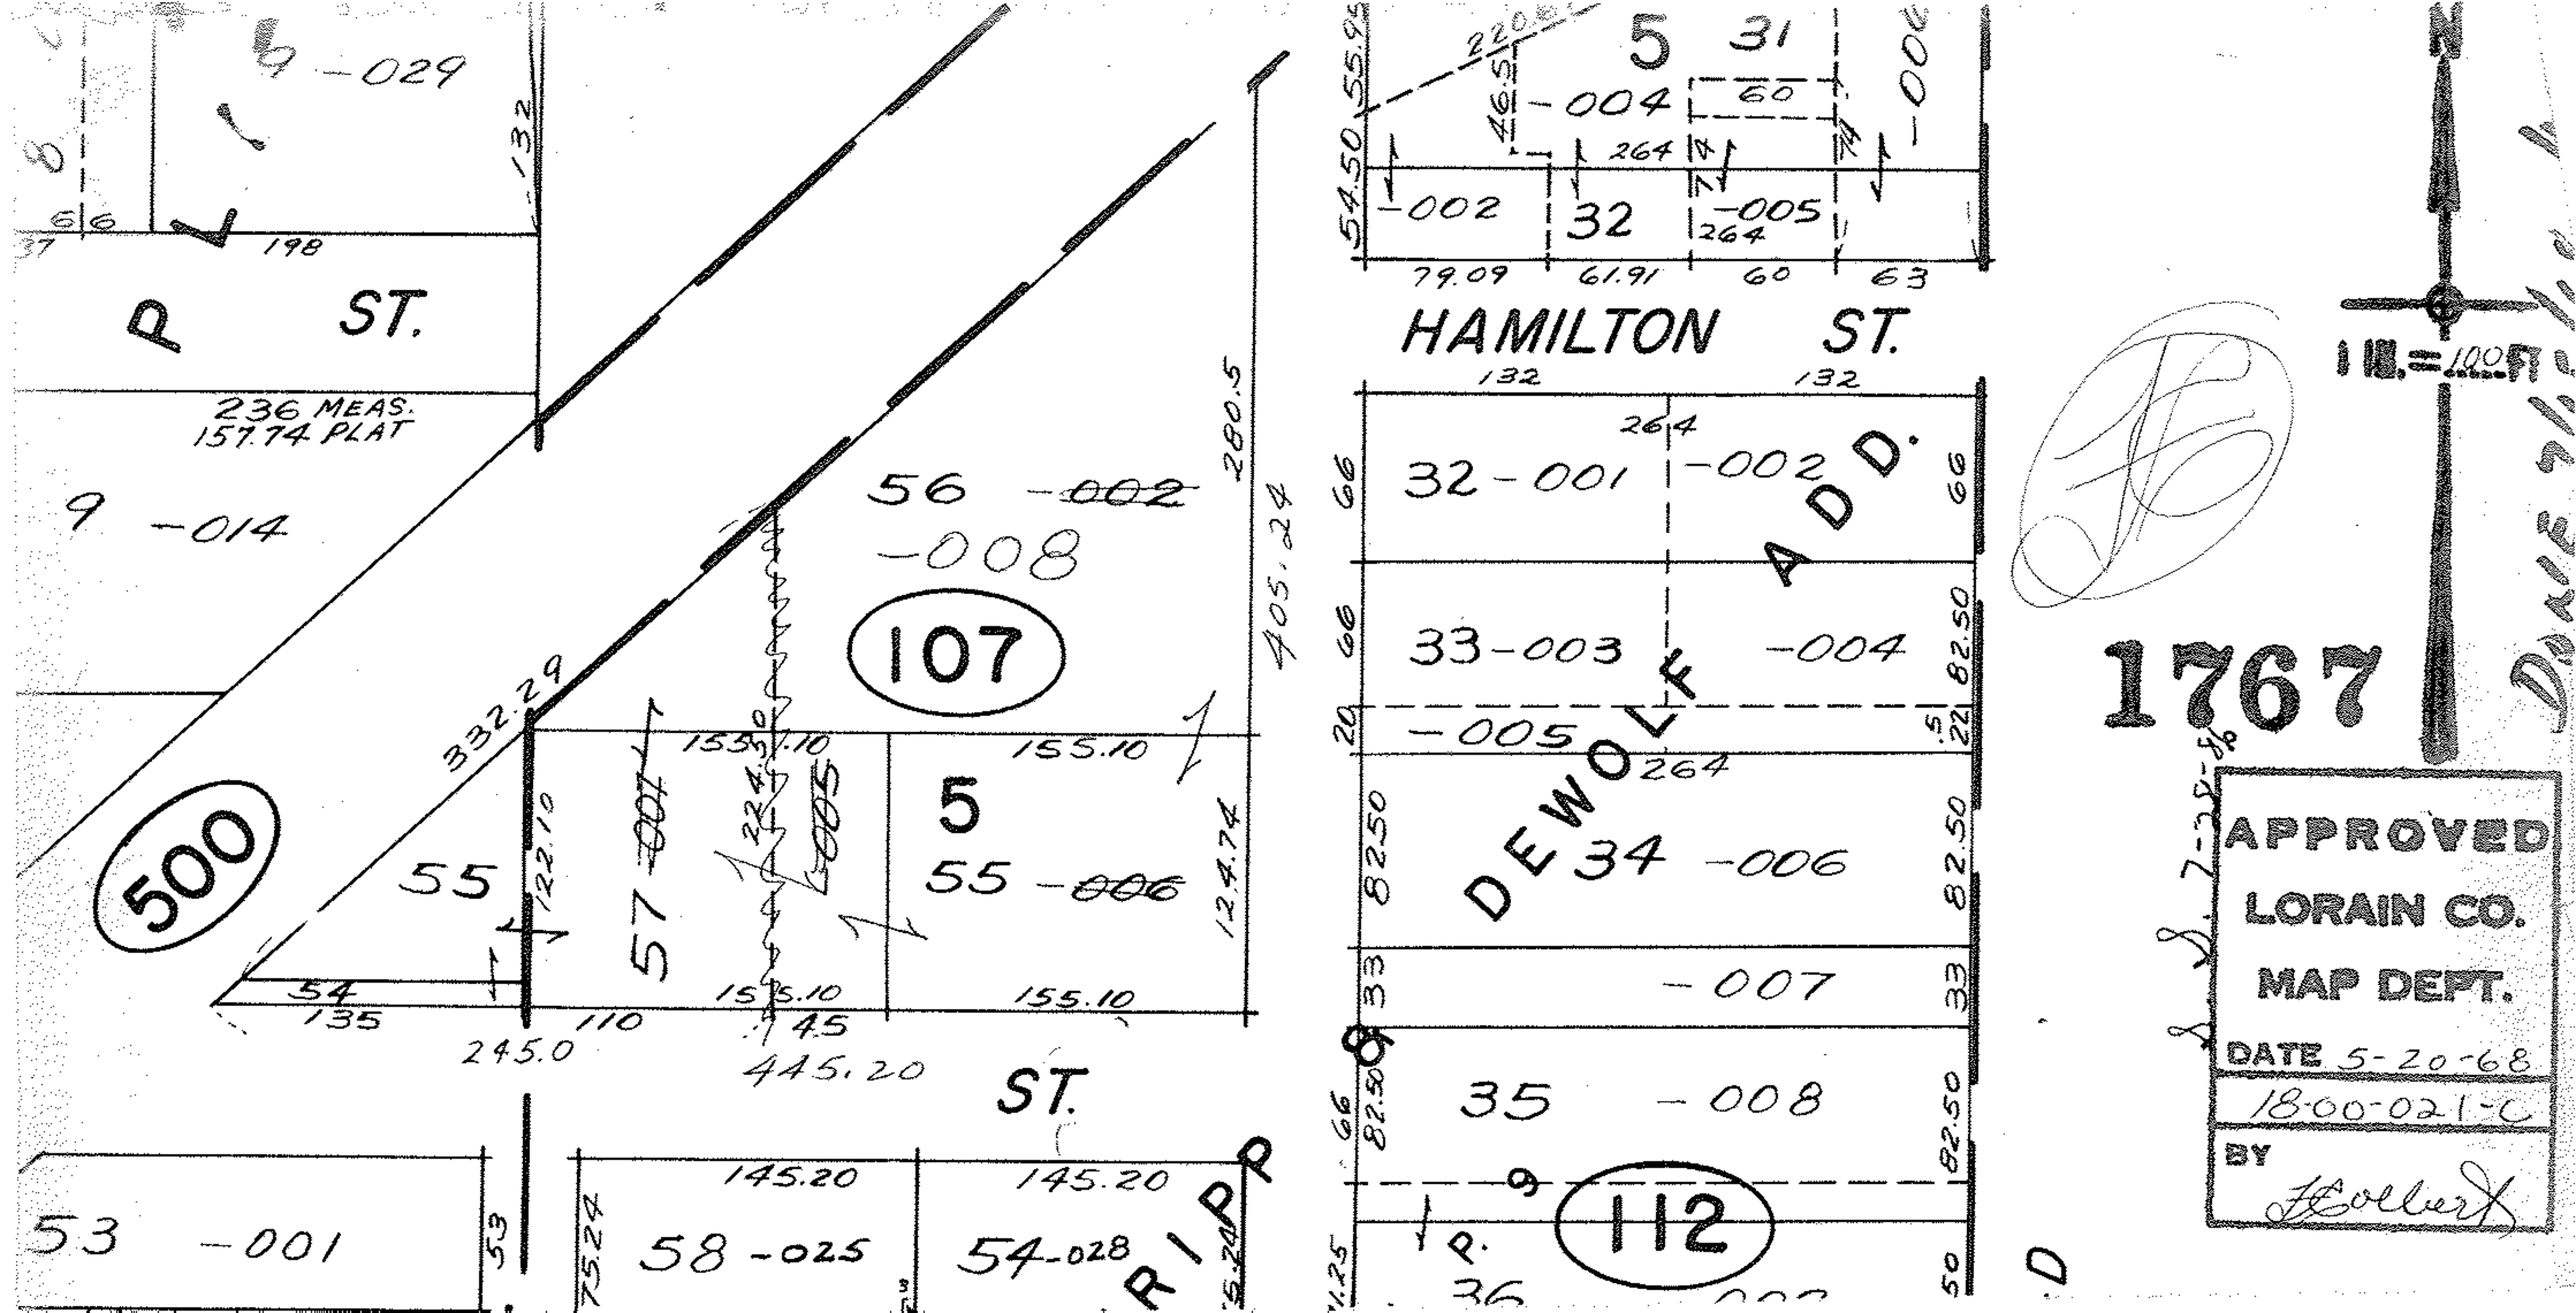
-029
132
198
P ST.
236 MEAS.
157.74 PLAT
9 -014
500
332.29
280.5
405.24
56 -002
-008
107
155.10
5
55 -006
124.74
55
122.10
57 -001
-005
54
135
110
245.0
155.10
45
445.20
ST.
53 -001
145.20
58 -025
54-028
RIPP
5 31
-004
60
-006
264
-002
32
-005
79.09
61.91
60
63
HAMILTON ST.
132
264
32-001
-002
33-003
-004
-005
34 -006
-007
35 -008
DEWOLF ADD.
112
36
1 IN.=100 FT
1767
APPROVED
LORAIN CO.
MAP DEPT.
DATE 5-20-68
18-00-021-C
BY