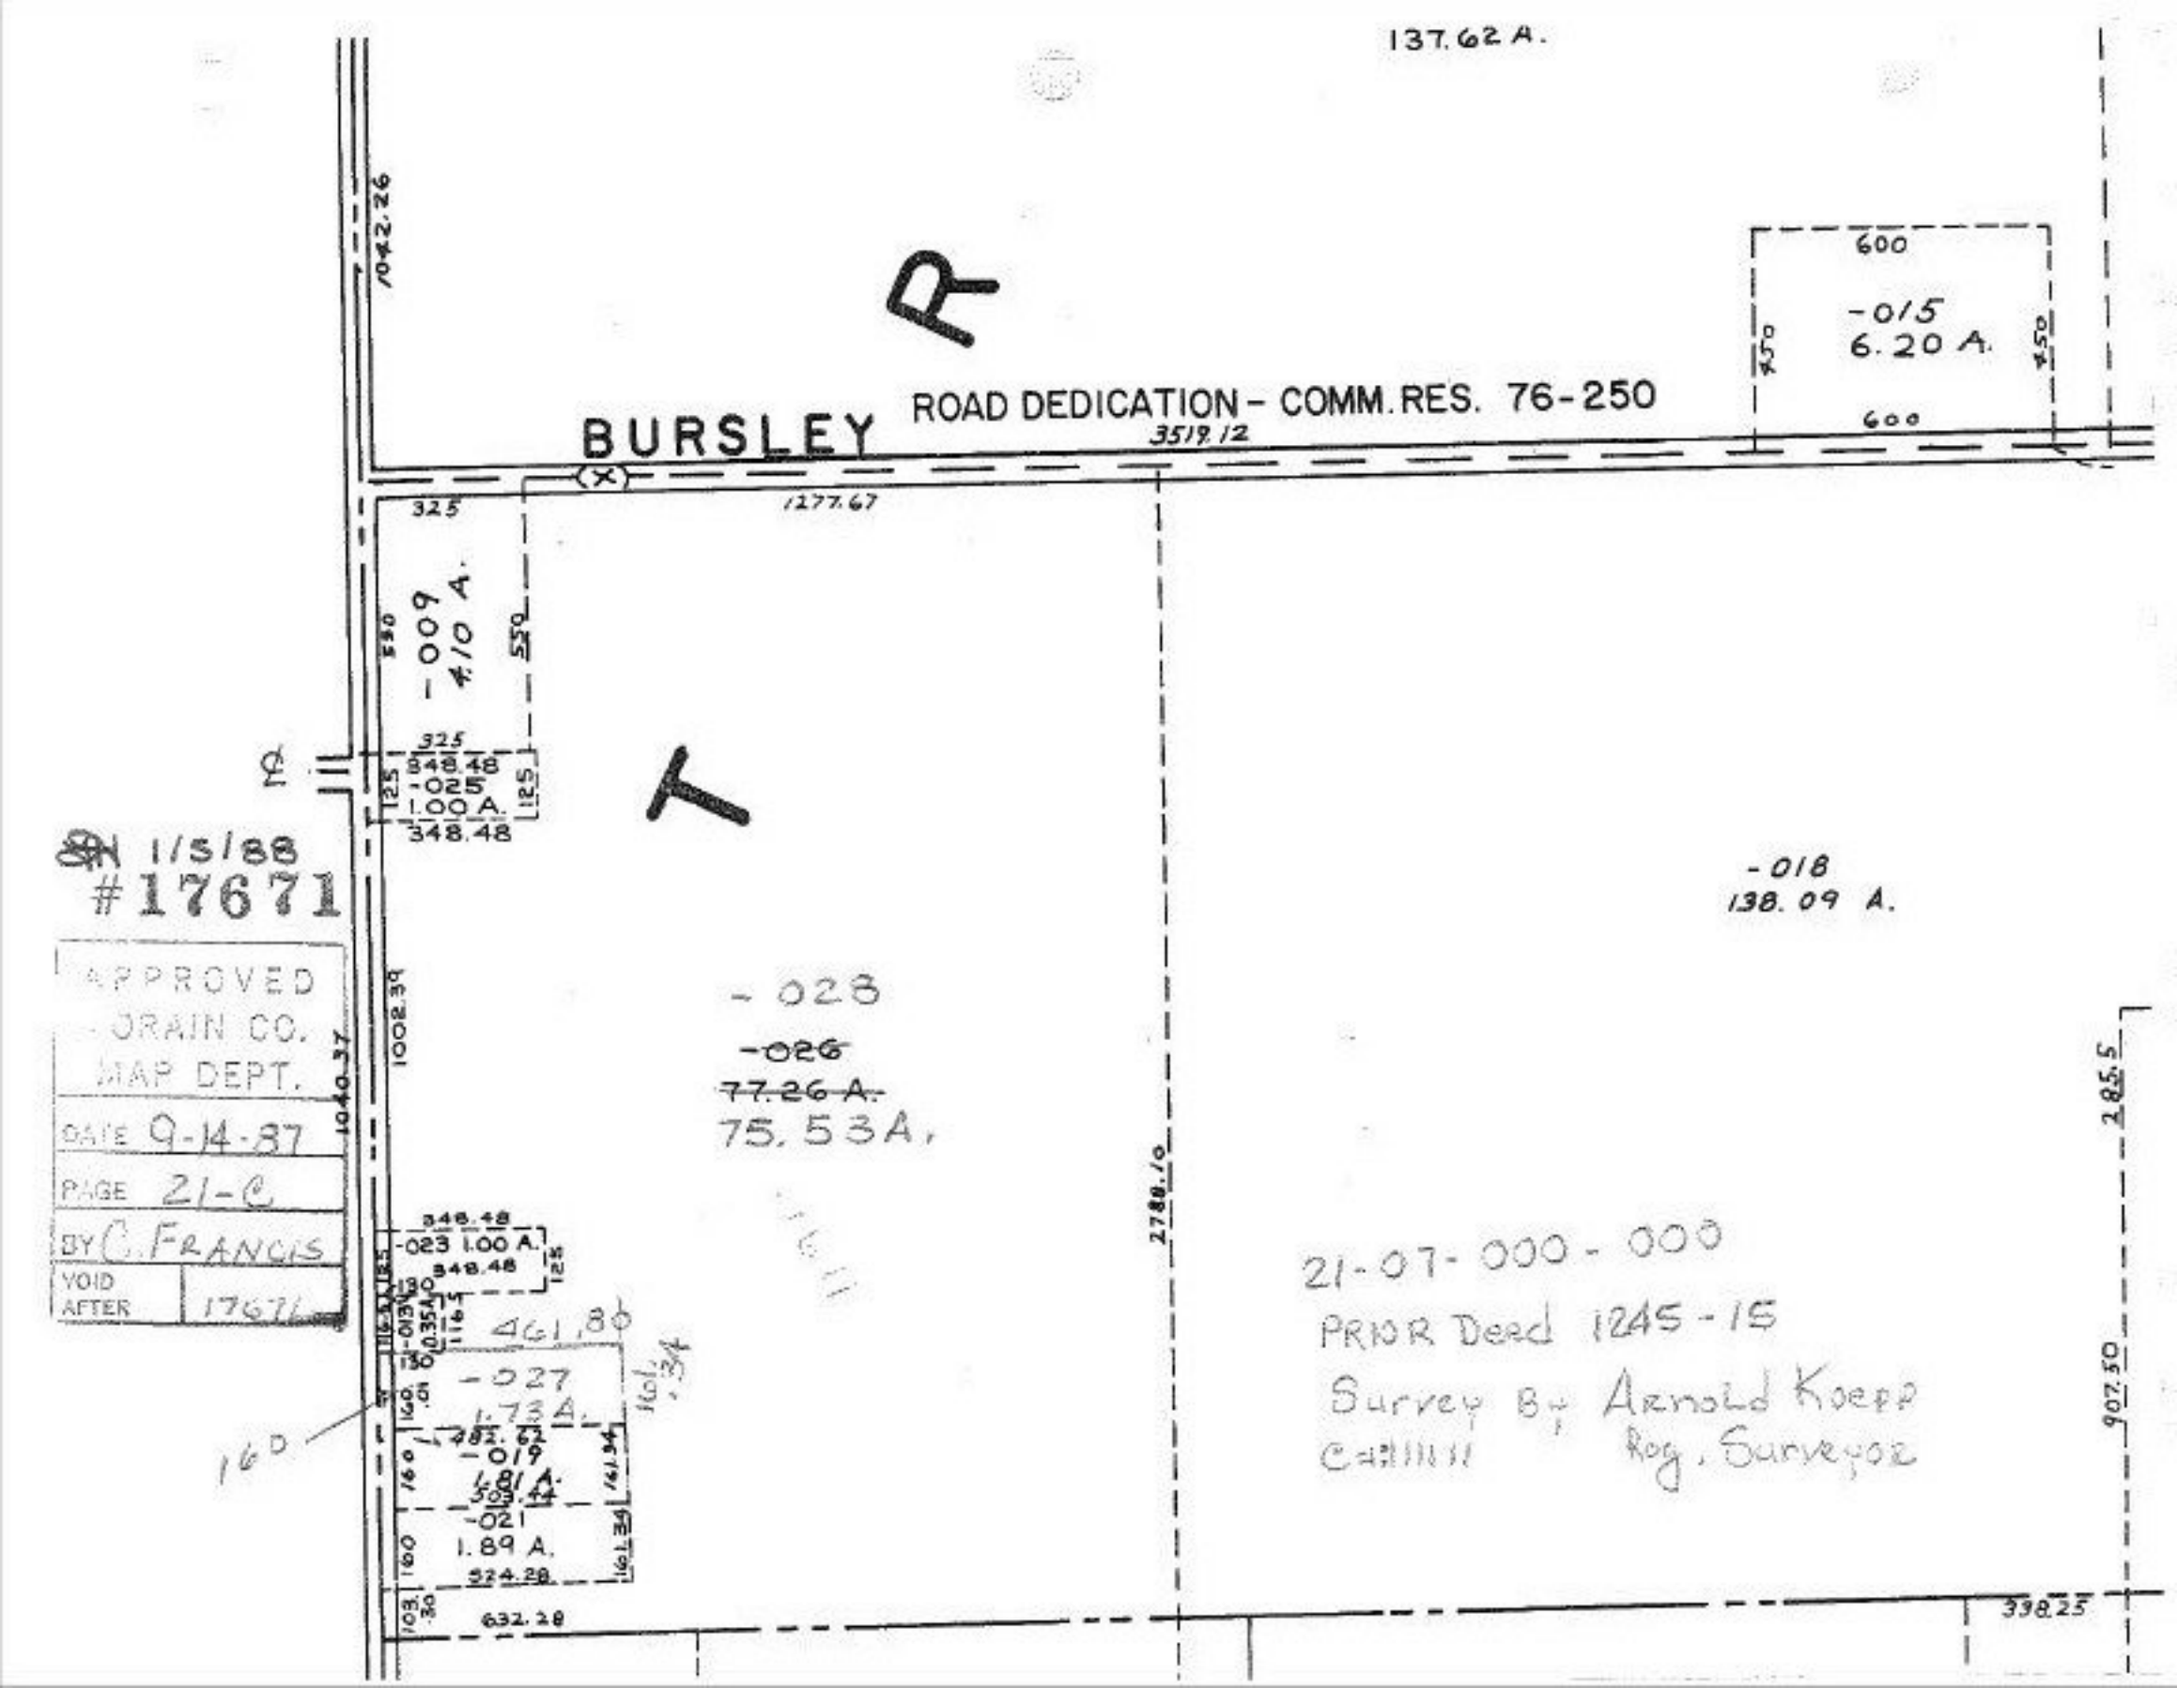
137.62 A.
1042.26
R
BURSLEY
ROAD DEDICATION - COMM. RES. 76-250
3519.12
600
-015
6.20 A.
450
600
325
1277.67
-009
4.10 A.
550
330
325
348.48
-025
1.00 A.
348.48
125
125
T
11/5/88
#17671
APPROVED
DRAIN CO.
MAP DEPT.
DATE 9-14-87
PAGE 21-C
BY C. FRANCIS
VOID AFTER 1767L
-018
138.09 A.
1040.37
1002.39
-028
-026
77.26 A.
75.53A.
2788.10
348.48
-023 1.00 A.
348.48
125
130
461.80
-027
1.73A.
160.01
-019
1.81 A.
-021
1.89 A.
524.28
160
161.34
160.34
16D
632.28
103.30
285.5
907.50
398.25
21-07-000-000
PRIOR Deed 1245-15
Survey By Arnold Koepp
Reg. Surveyor