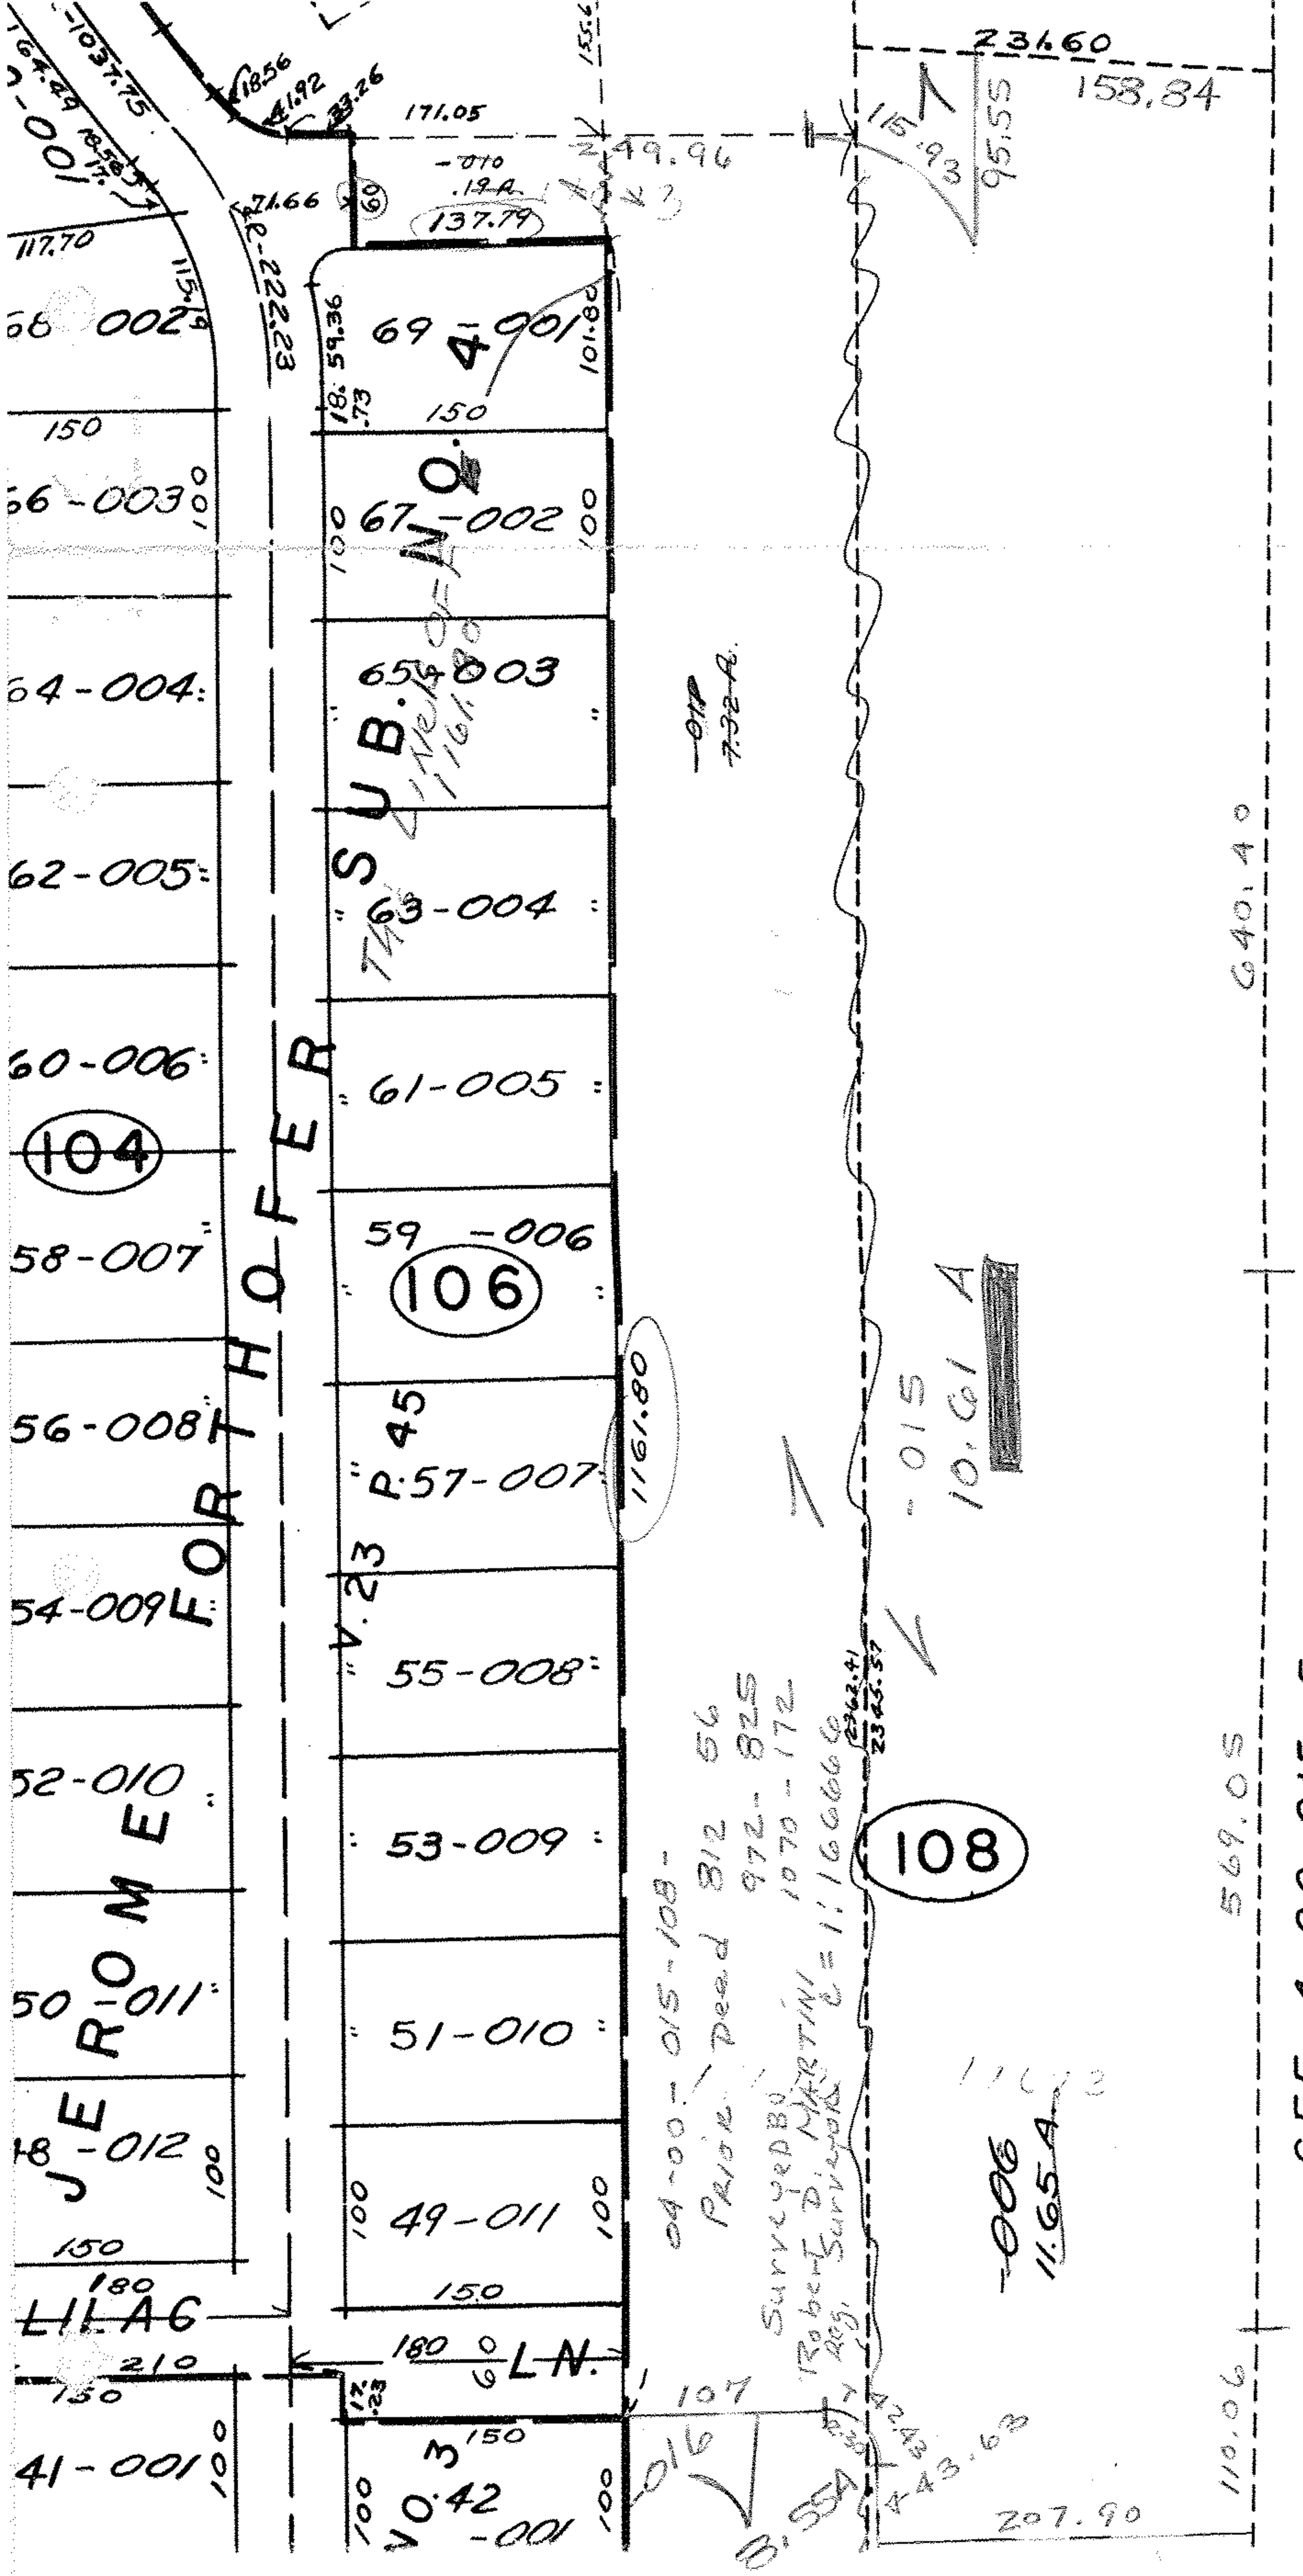

10-29-87
#17673
APPROVED
LORAIN CO.
MAP DEPT.
DATE 9-15-87
PAGE 4-00-015E
BY C. Francis
VOID AFTER 17673