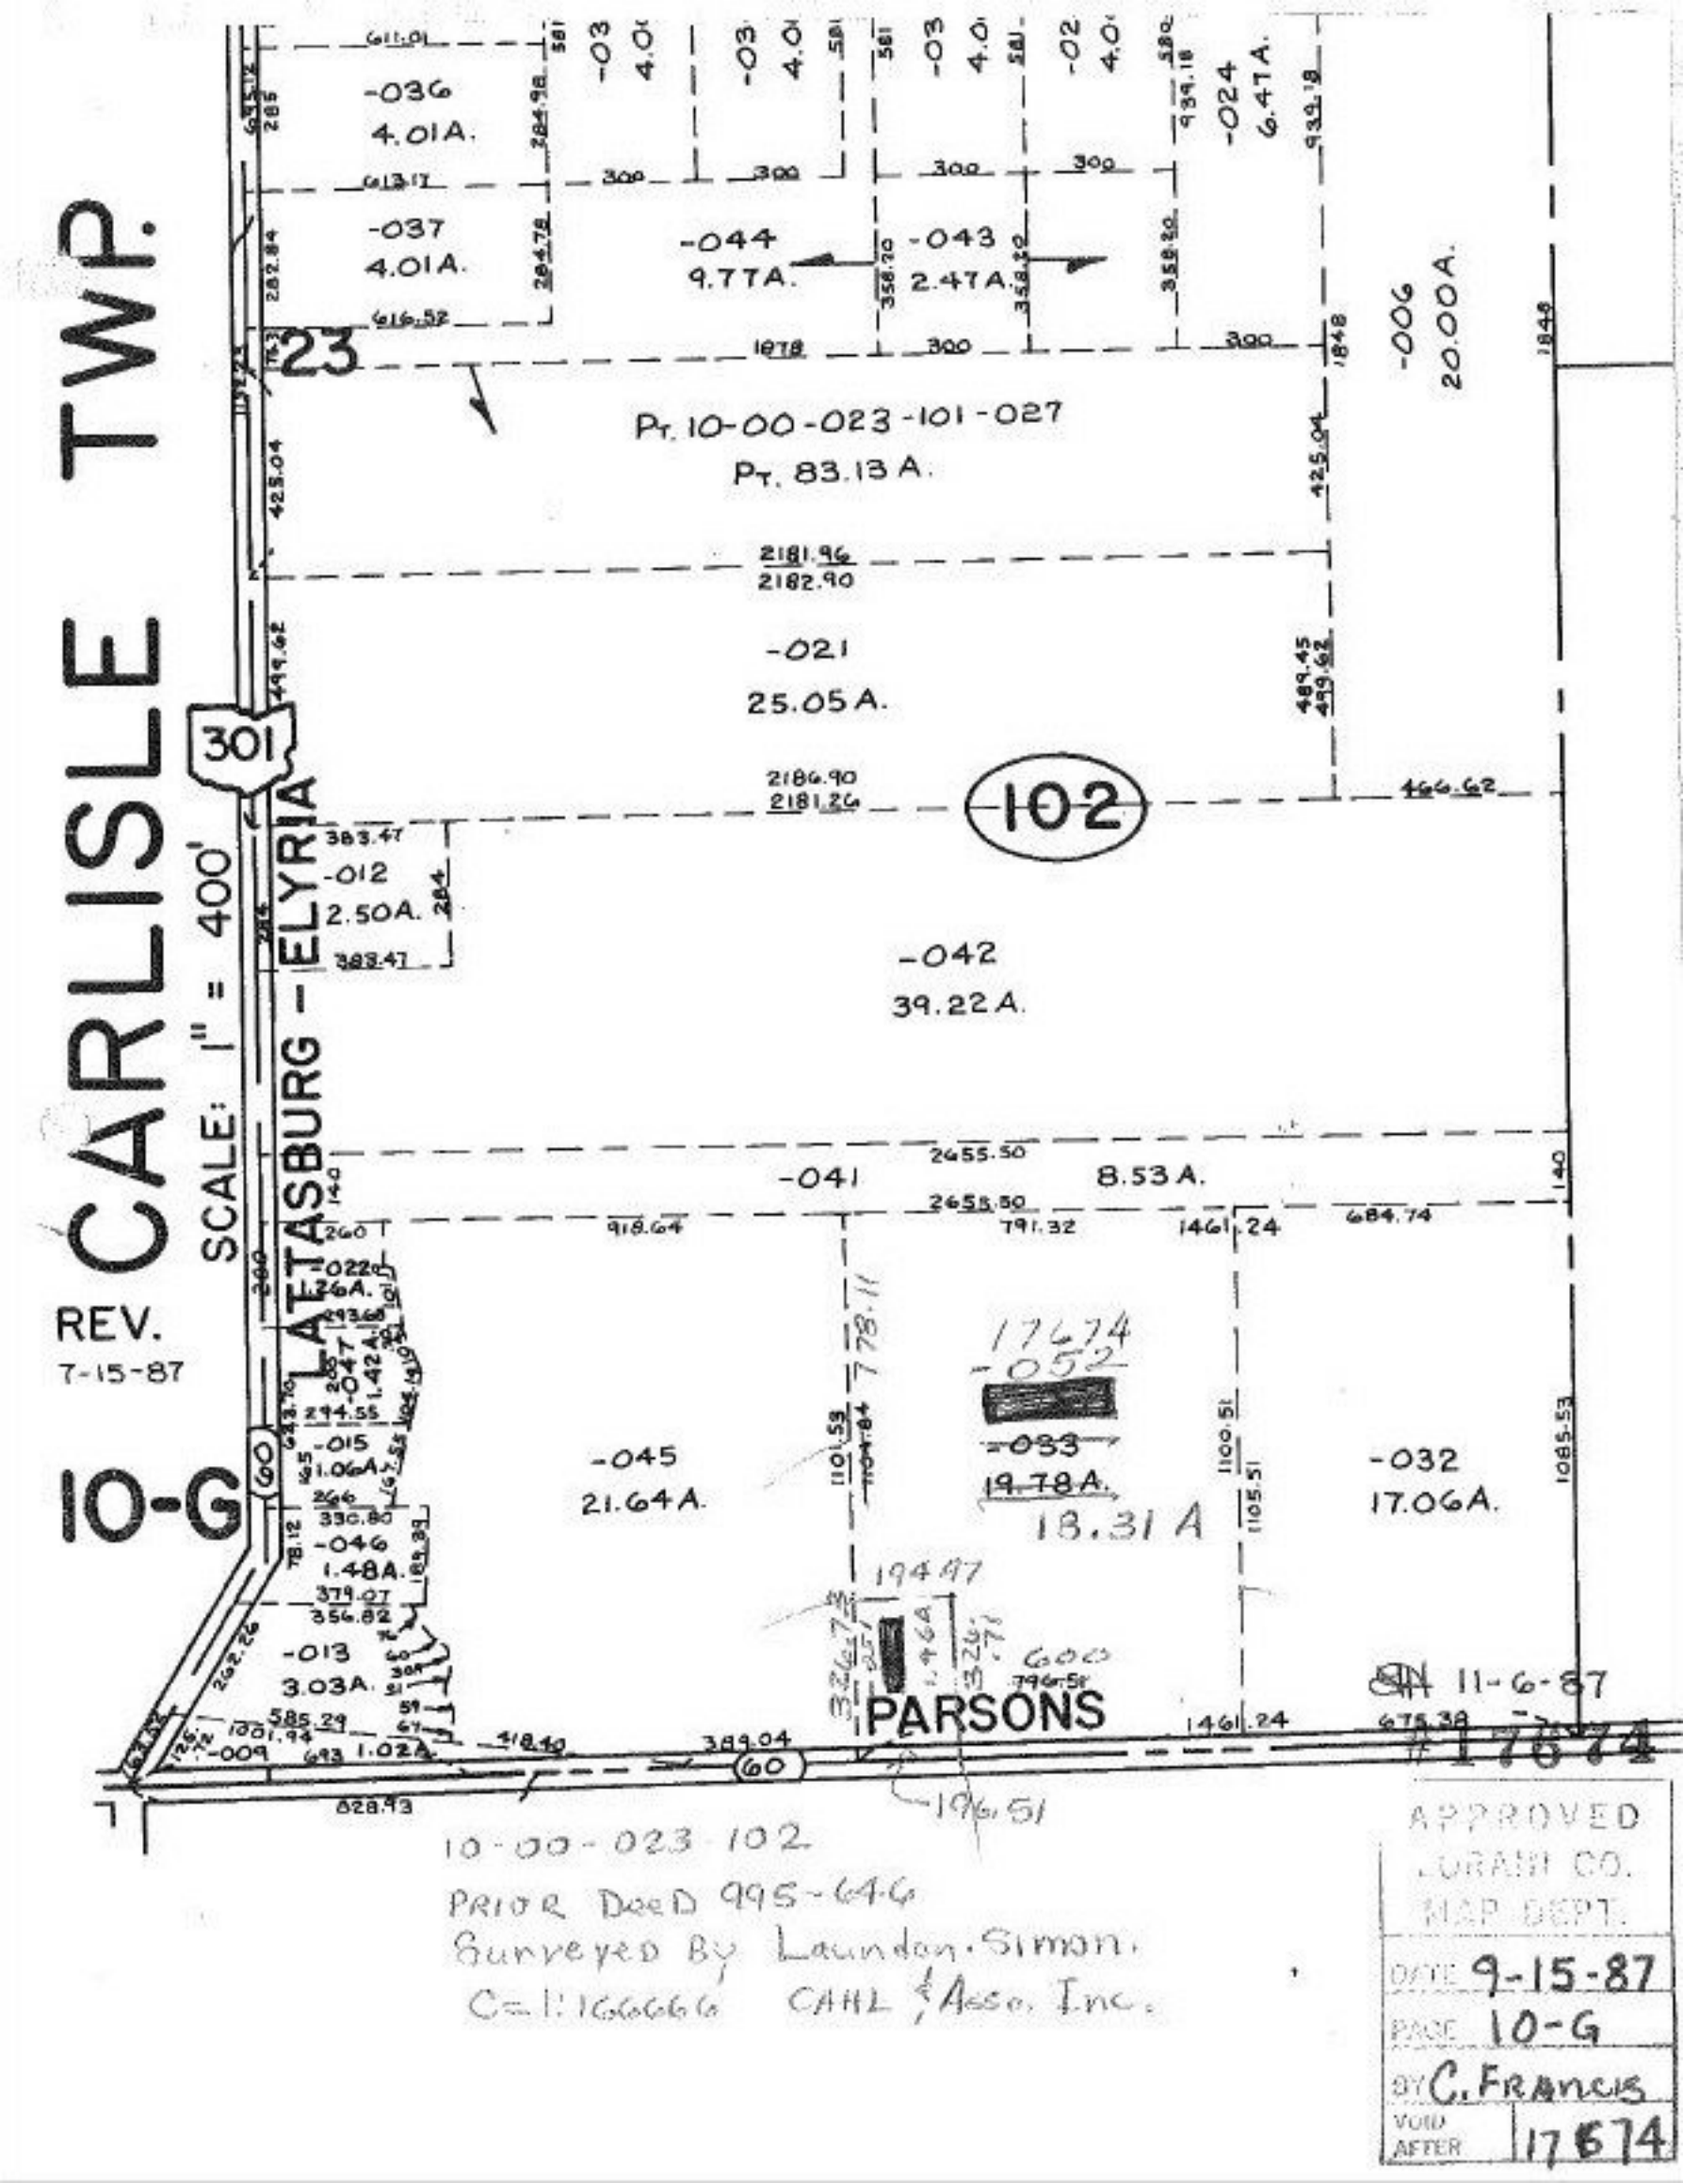
10-G
CARLISLE TWP.
SCALE: 1" = 400'
REV.
7-15-87
ELYRIA
LATASBURG
PARSONS
23
102
30
60
-036
4.01A.
-037
4.01A.
-044
9.77A.
-043
2.47A.
-024
6.47A.
-006
20.00A.
Pt. 10-00-023-101-027
Pt. 83.13 A.
-021
25.05 A.
-042
39.22 A.
-041
8.53 A.
-012
2.50A.
-022
1.26A.
-047
1.42A.
-015
1.06A.
-045
21.64 A.
-052
-033
19.78A.
18.31 A
-032
17.06A.
-046
1.48A.
-013
3.03A.
-009
1.02A.
17674
11-6-87
#17674
10-00-023 102
PRIOR DEED 995-646
Surveyed By Laundon-Simon.
C=1:166666 CAHL & Assoc. Inc.
APPROVED
LORAIN CO.
MAP DEPT.
DATE 9-15-87
PAGE 10-G
BY C. FRANCIS
VOID AFTER 17674