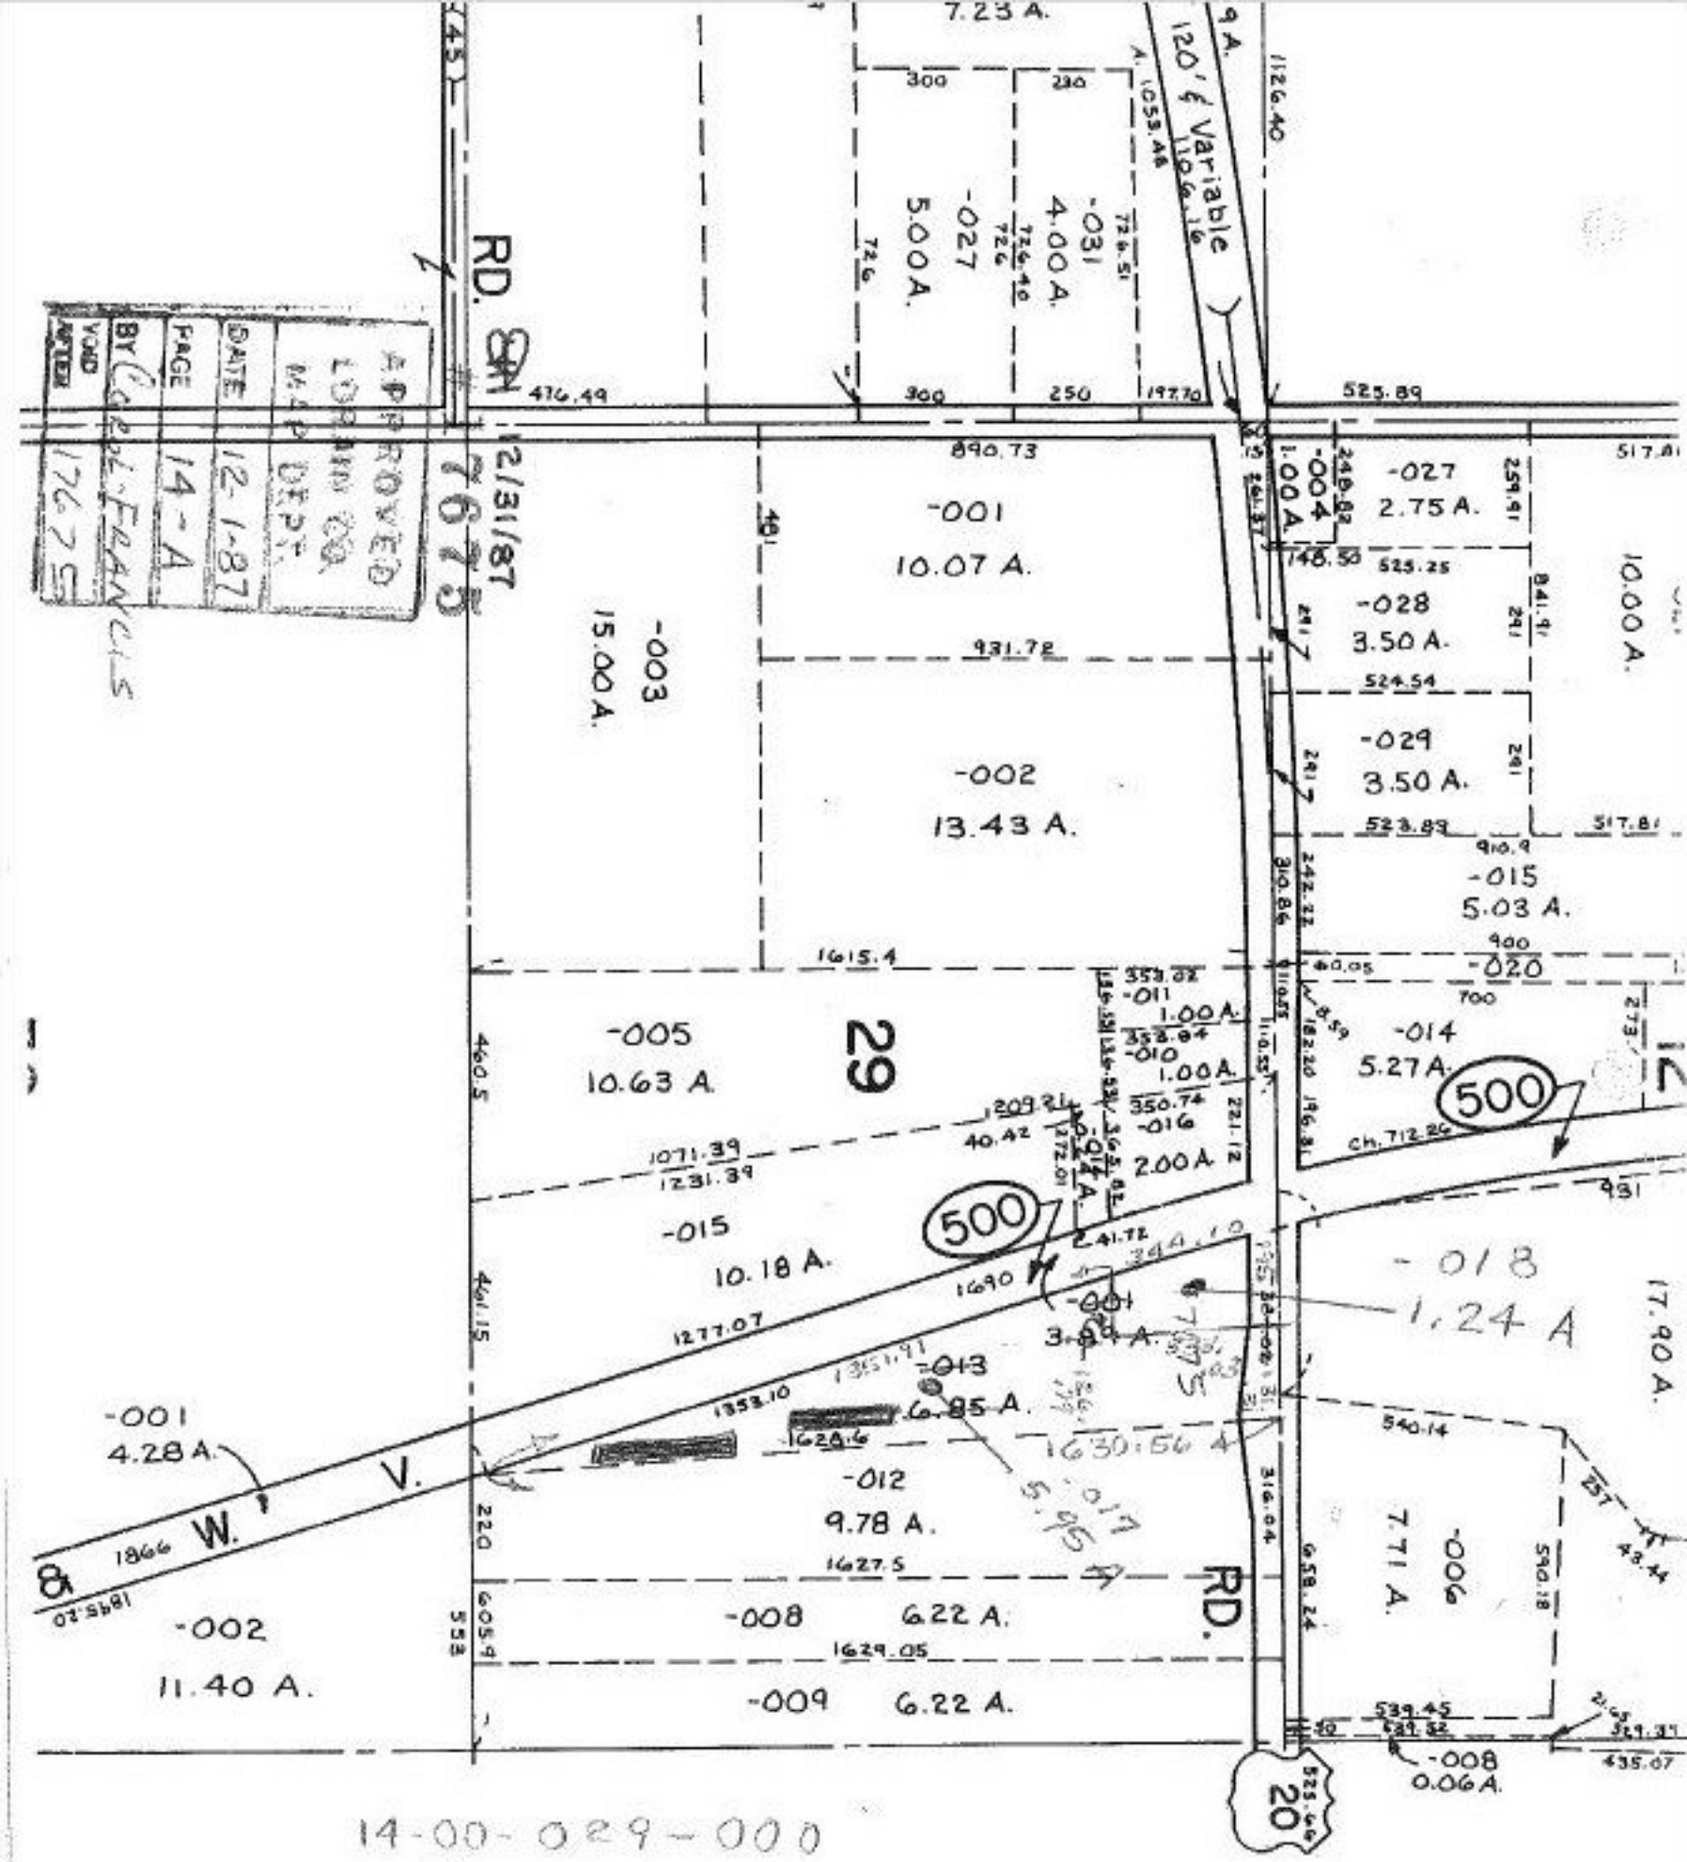

14-00-029-000

Prior Deed 1239-427

Surveyed By Foor & Assoc. Inc.,
C=1:333333