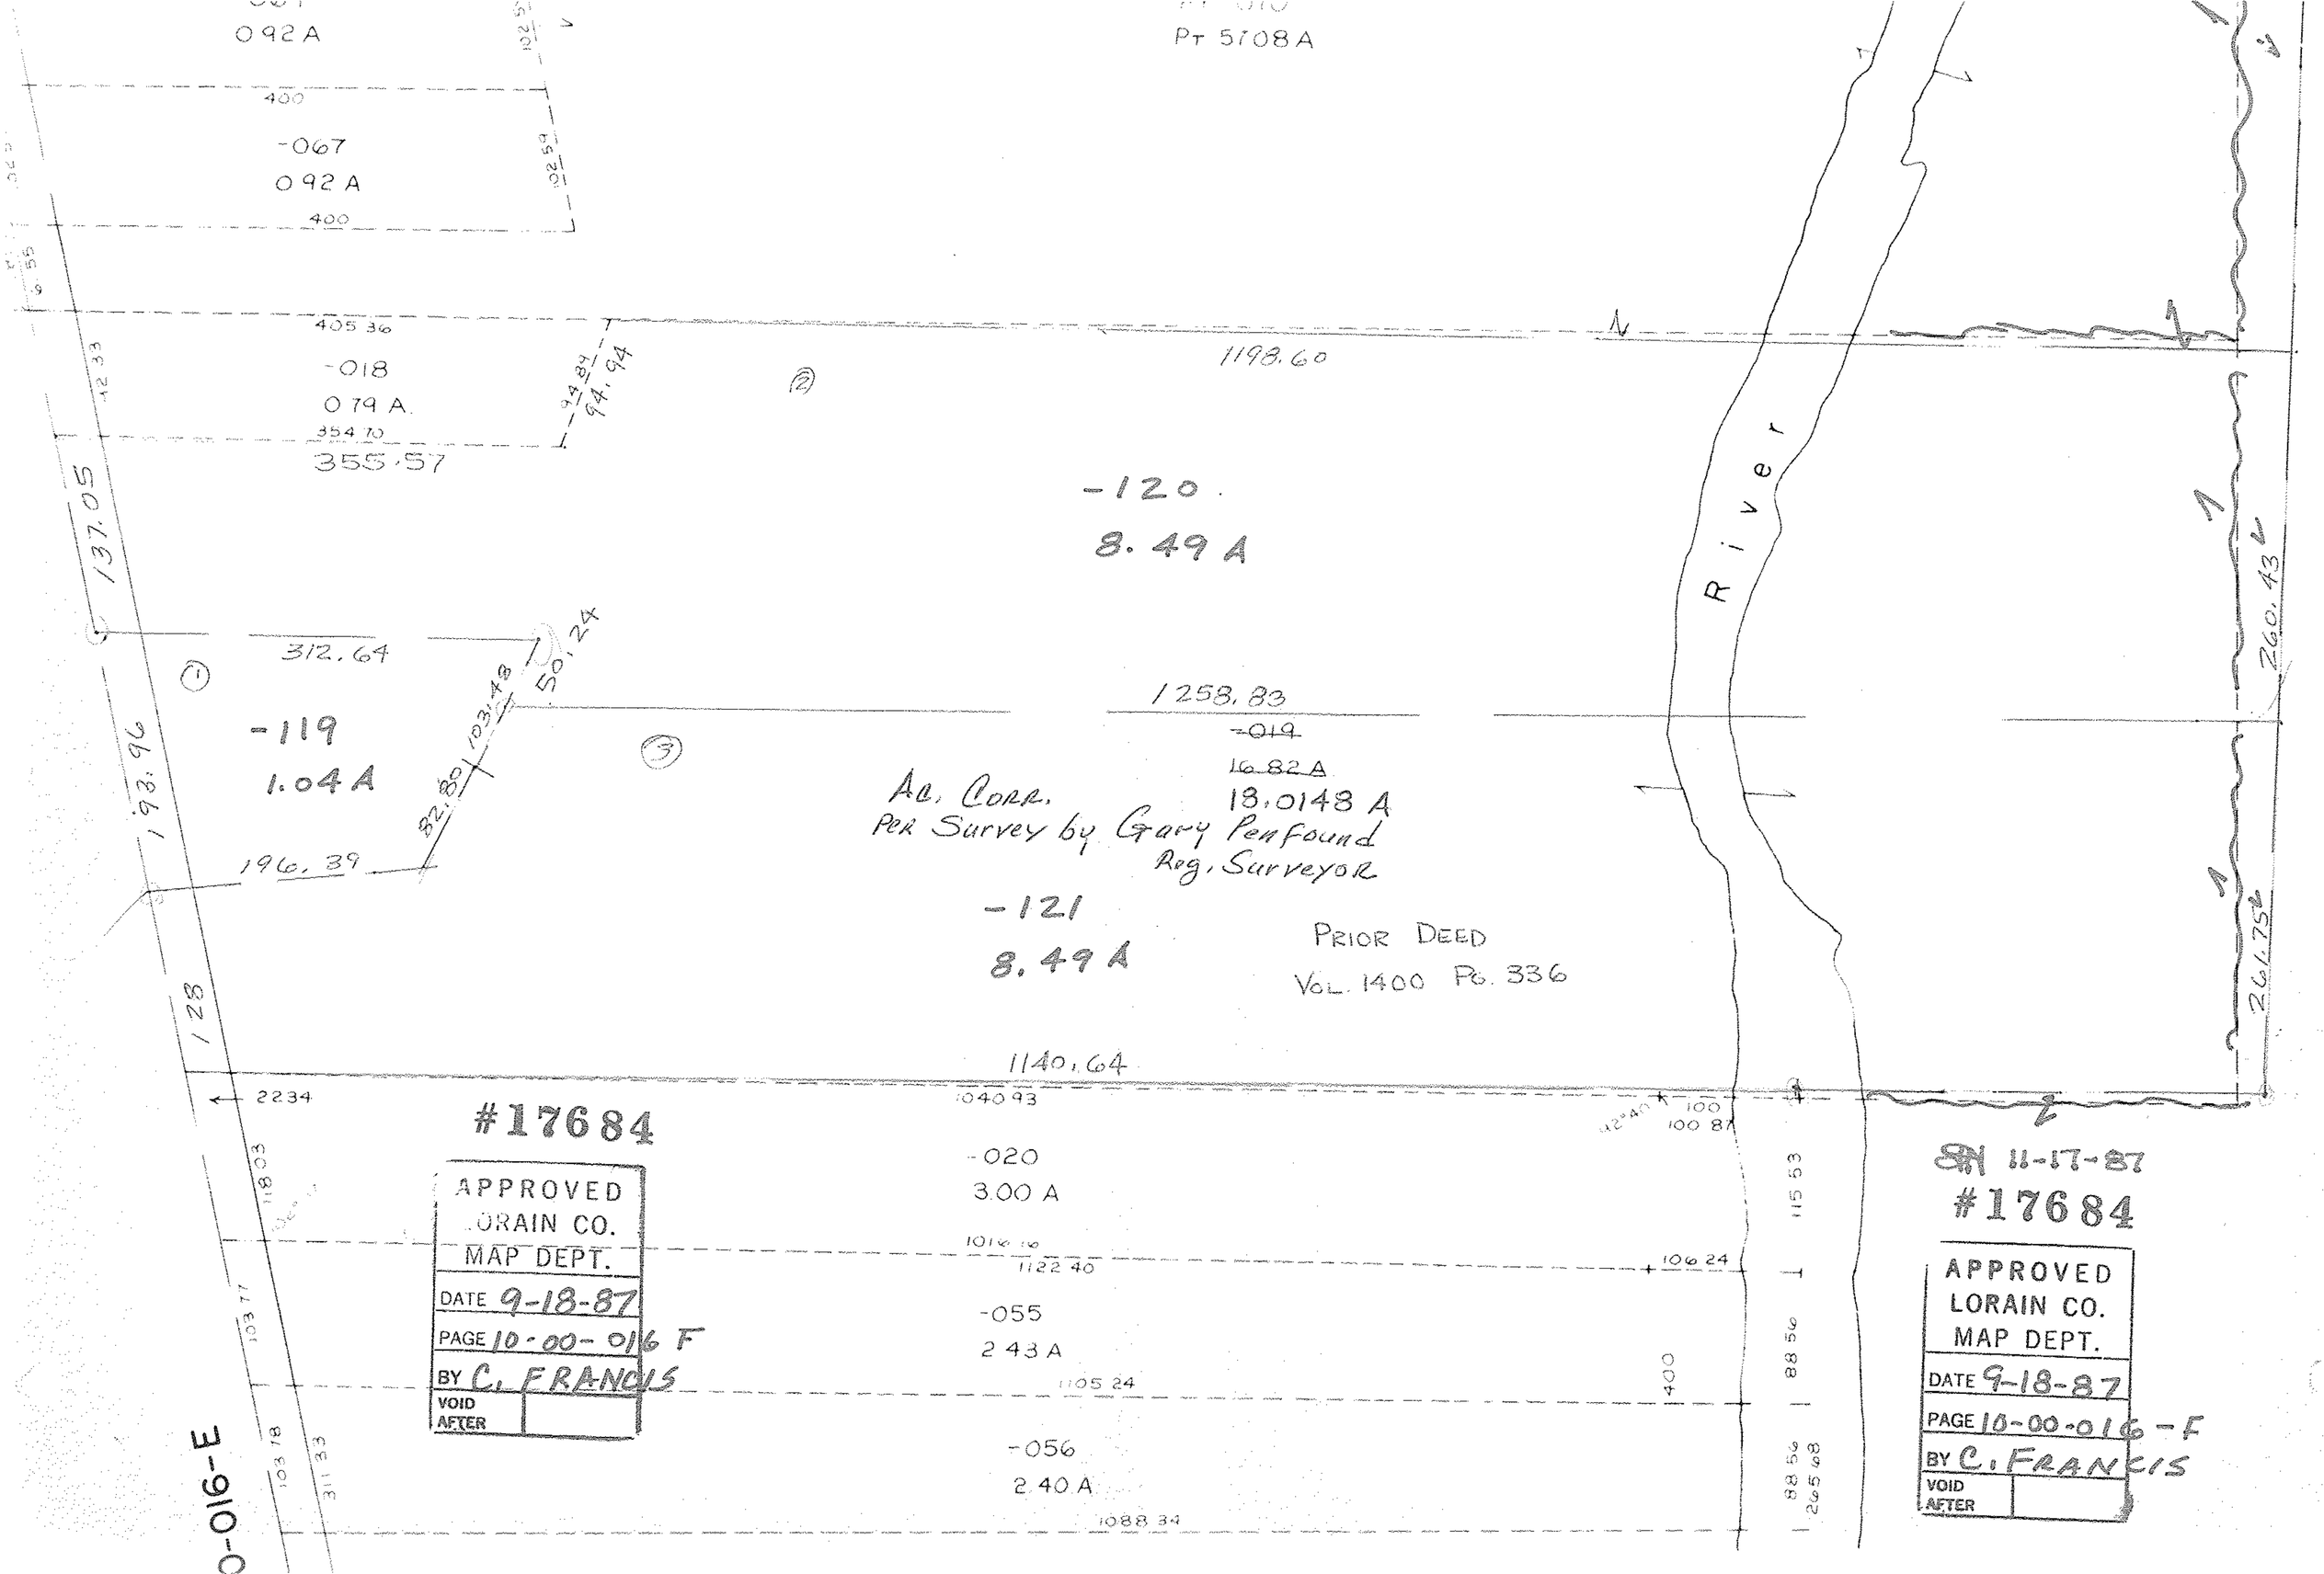

0 92 A
Pt 5708 A
400
-067
0 92 A
400
405 36
-018
0 79 A
354 70
355.57
94.84
94.94
1198.60
-120
8.49 A
137.05
312.64
50.24
-119
1.04 A
103.48
82.80
196.39
193.96
1258.83
-019
16.82 A
18.0148 A
Ac. Corr.
Per Survey by Gary Penfound
Reg. Surveyor
-121
8.49 A
Prior Deed
Vol. 1400 Pg. 336
River
260.43
261.75
128
1140.64
2234
1040 93
100
100 87
#17684
-020
3.00 A
1016 16
1122 40
106 24
-055
2 43 A
1105 24
-056
2 40 A
1088 34
115 53
88 56
88 56
265 68
400
103 77
103 78
311 33
118 03
0-016-E
APPROVED
LORAIN CO.
MAP DEPT.
DATE 9-18-87
PAGE 10-00-016 F
BY C. FRANCIS
VOID AFTER
SN 11-17-87
#17684
APPROVED
LORAIN CO.
MAP DEPT.
DATE 9-18-87
PAGE 10-00-016-F
BY C. FRANCIS
VOID AFTER