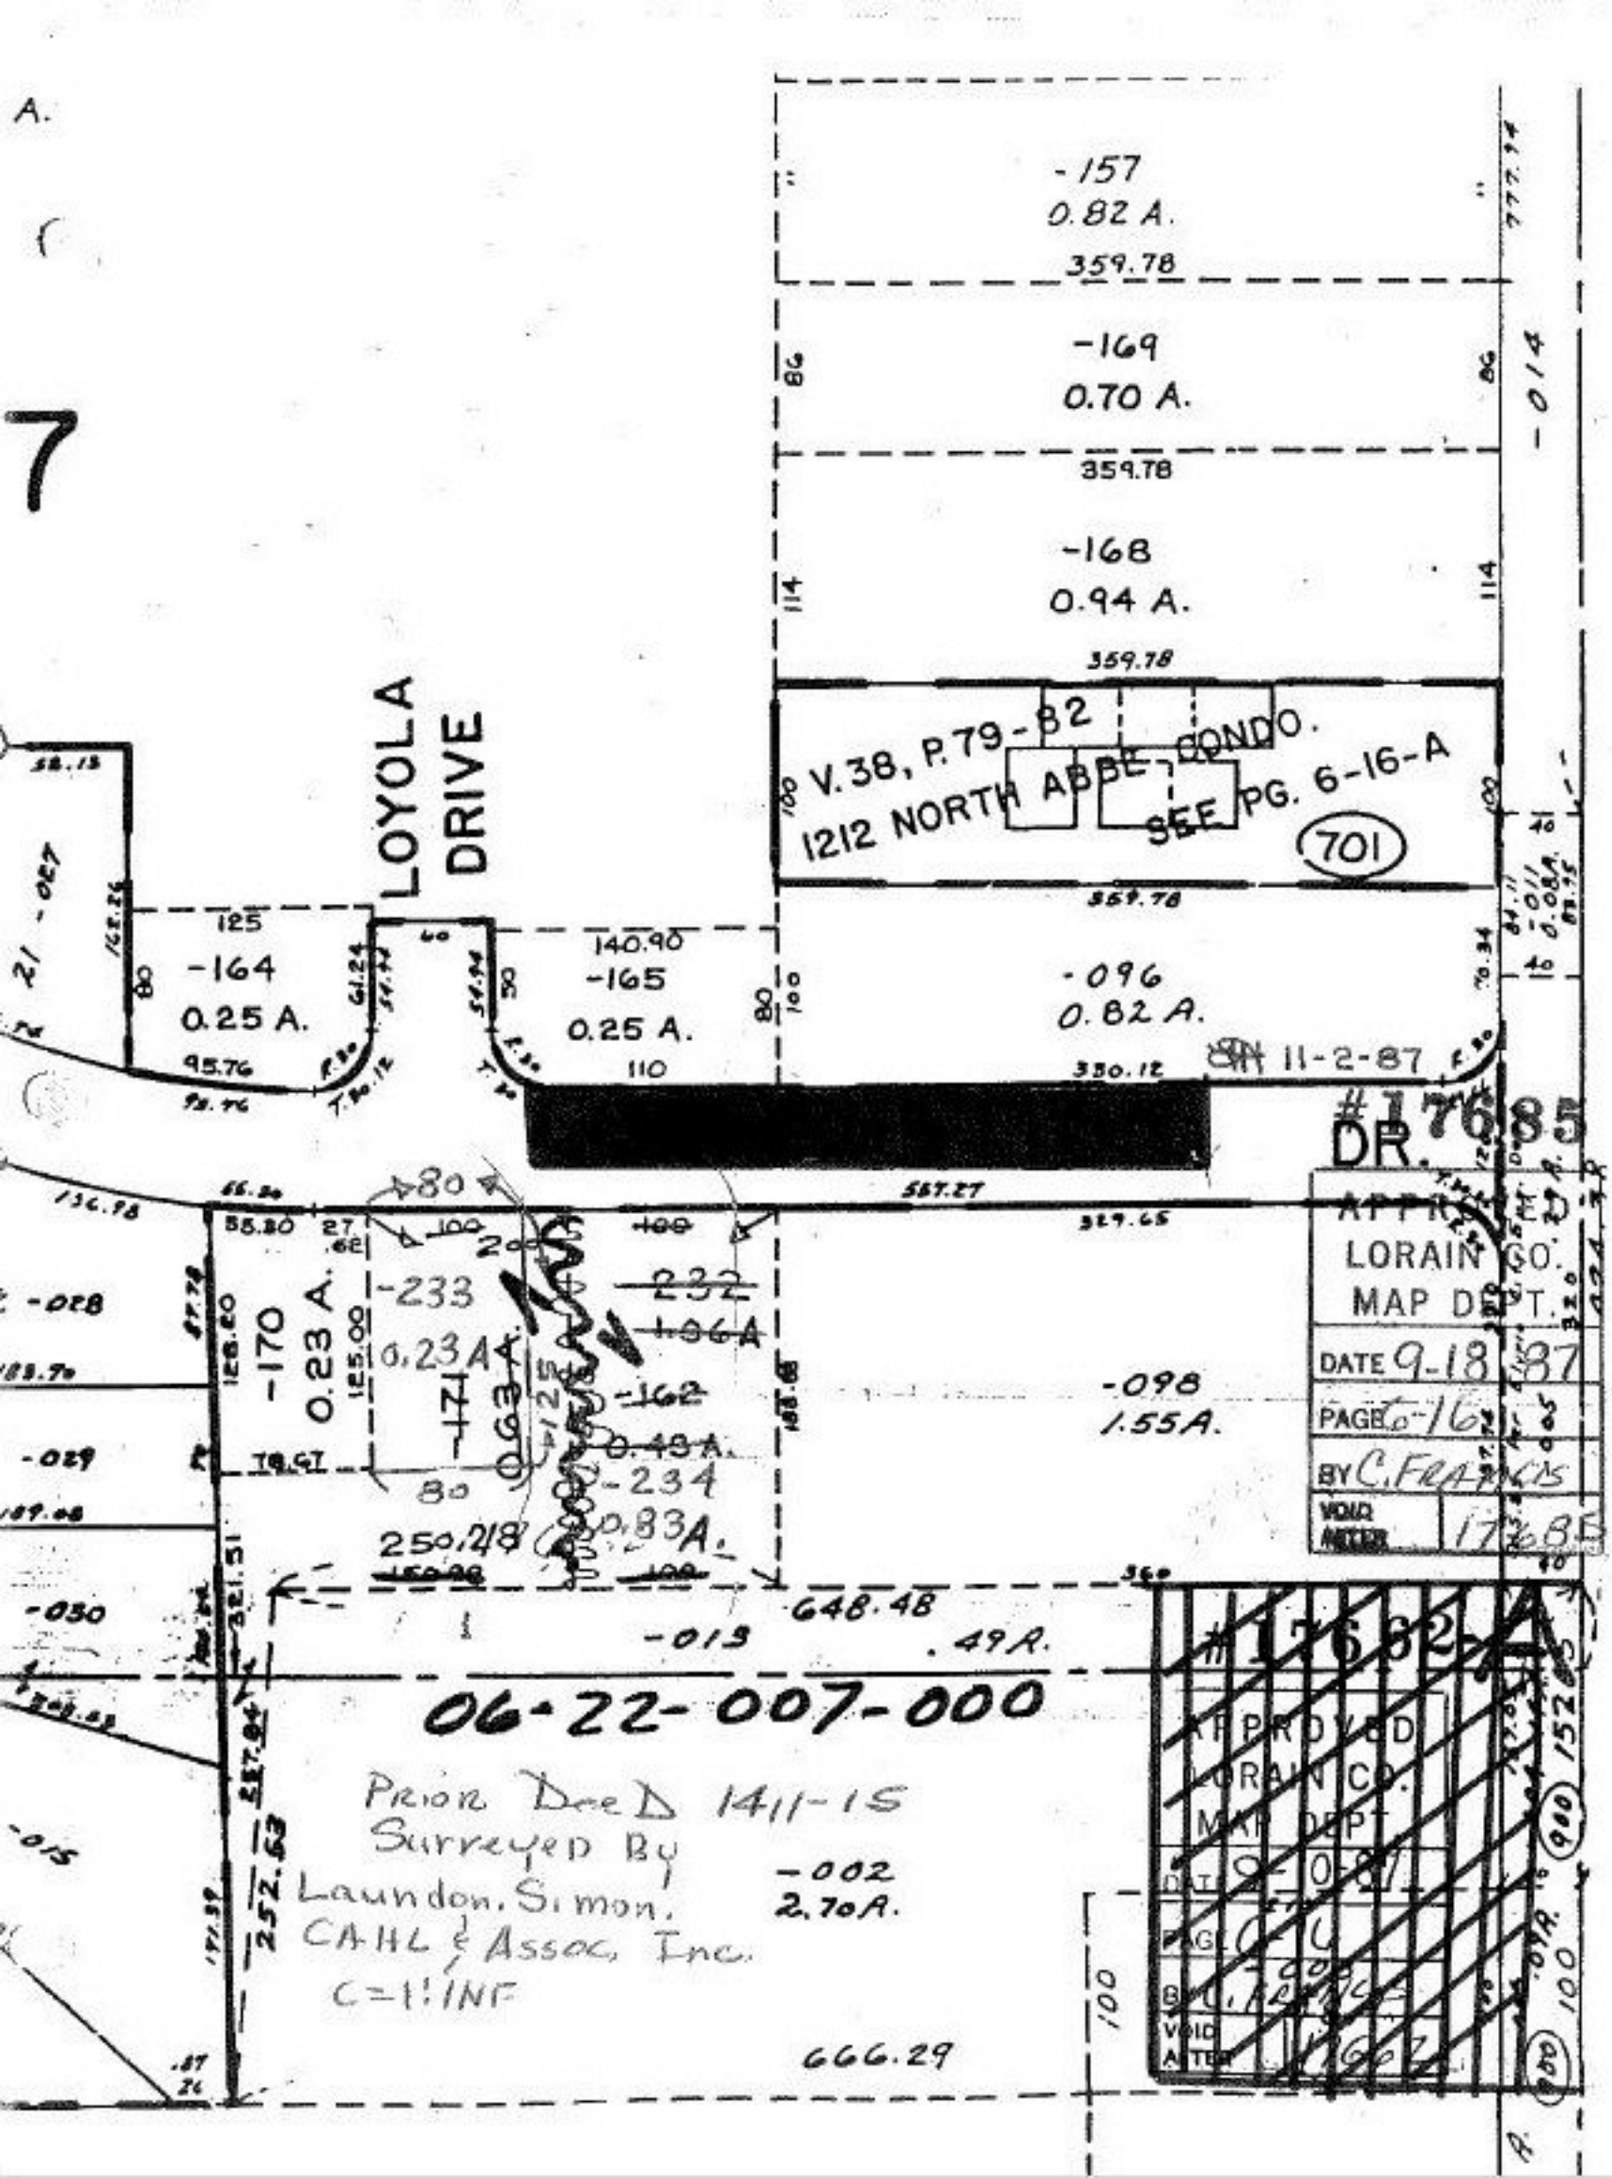
A.
7
-157
0.82 A.
359.78
-169
0.70 A.
359.78
-168
0.94 A.
359.78
LOYOLA DRIVE
V. 38, P. 79-82
1212 NORTH ABBE CONDO.
SEE PG. 6-16-A
701
-164
0.25 A.
-165
0.25 A.
-096
0.82 A.
-170
0.23 A.
-233
0.23A.
-234
0.83A.
-098
1.55A.
-013
.49A.
-002
2.70A.
06-22-007-000
Prior Deed 1411-15
Surveyed By
Laundon, Simon,
CA-HL & Assoc. Inc.
C=1:INF
11-2-87
#17685
DR.
APPROVED
LORAIN CO.
MAP DEPT.
DATE 9-18-87
PAGE 6-16
BY C. FRANCIS
VOID
AFTER
17685
#17682
APPROVED
LORAIN CO.
MAP DEPT.
DATE 9-08-87
PAGE 6-16
BY C. FRANCIS
VOID
AFTER
17682