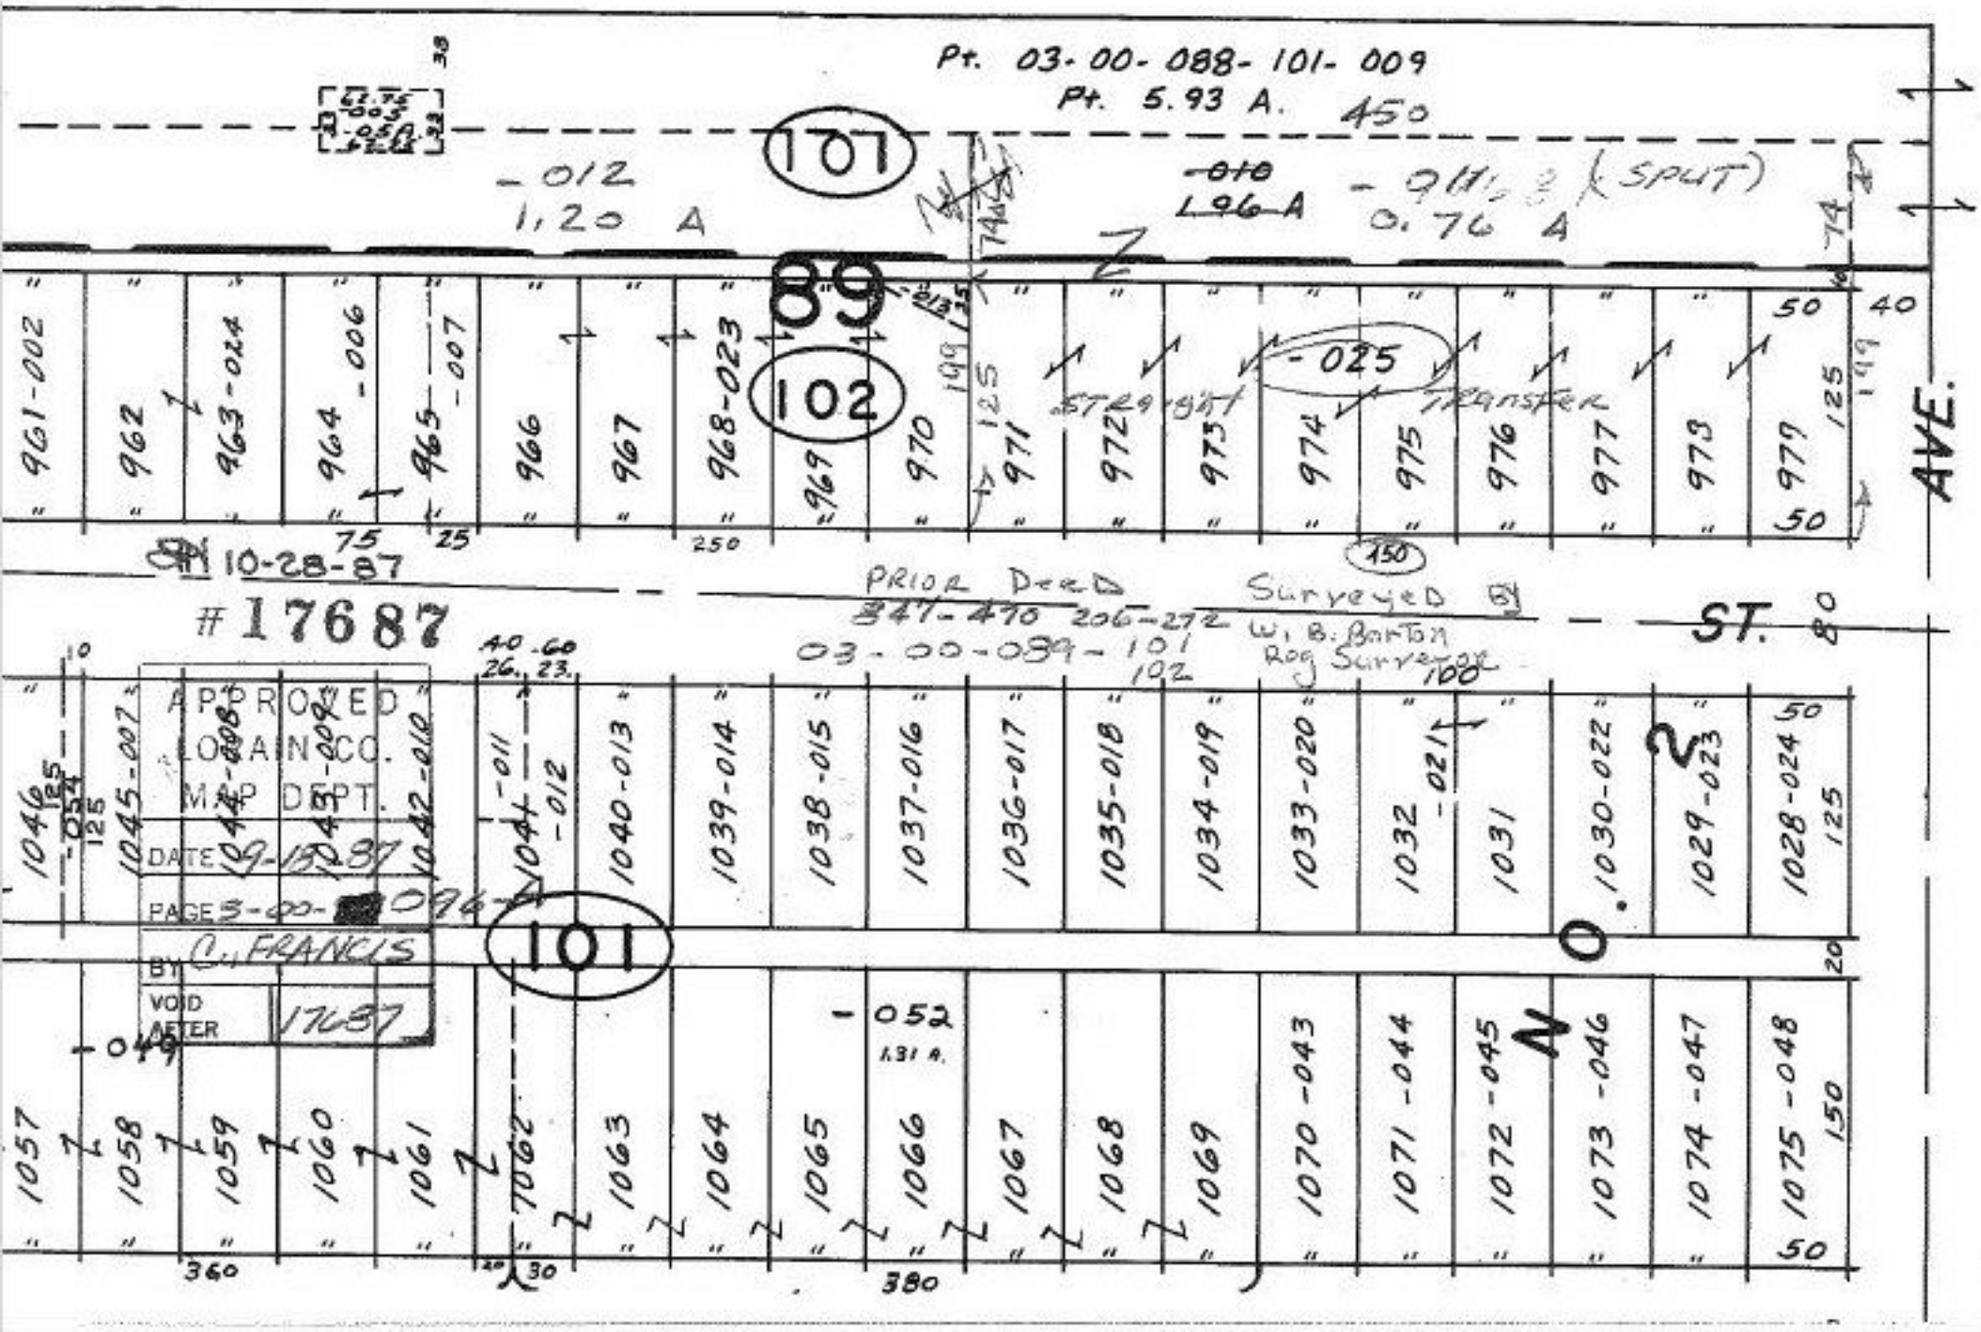
SEE 3-E
Pt. 03-00-088-101-009
Pt. 5.93 A.
450
101
-012
1.20 A
-010
1.96 A
-0168 (SPLIT)
0.76 A
89
102
-025
STRAIGHT TRANSFER
AVE.
ST.
10-28-87
#17687
PRIOR DEED
347-470 206-272
03-00-089-101
102
Surveyed By
W. B. Barton
Reg Surveyor
APPROVED
LORAIN CO.
MAP DEPT.
DATE 9-18-87
PAGE 3-00-[redacted]096-A
BY C. FRANCIS
VOID AFTER 17687
101
-052
1.31 A.
-049
N O. 2