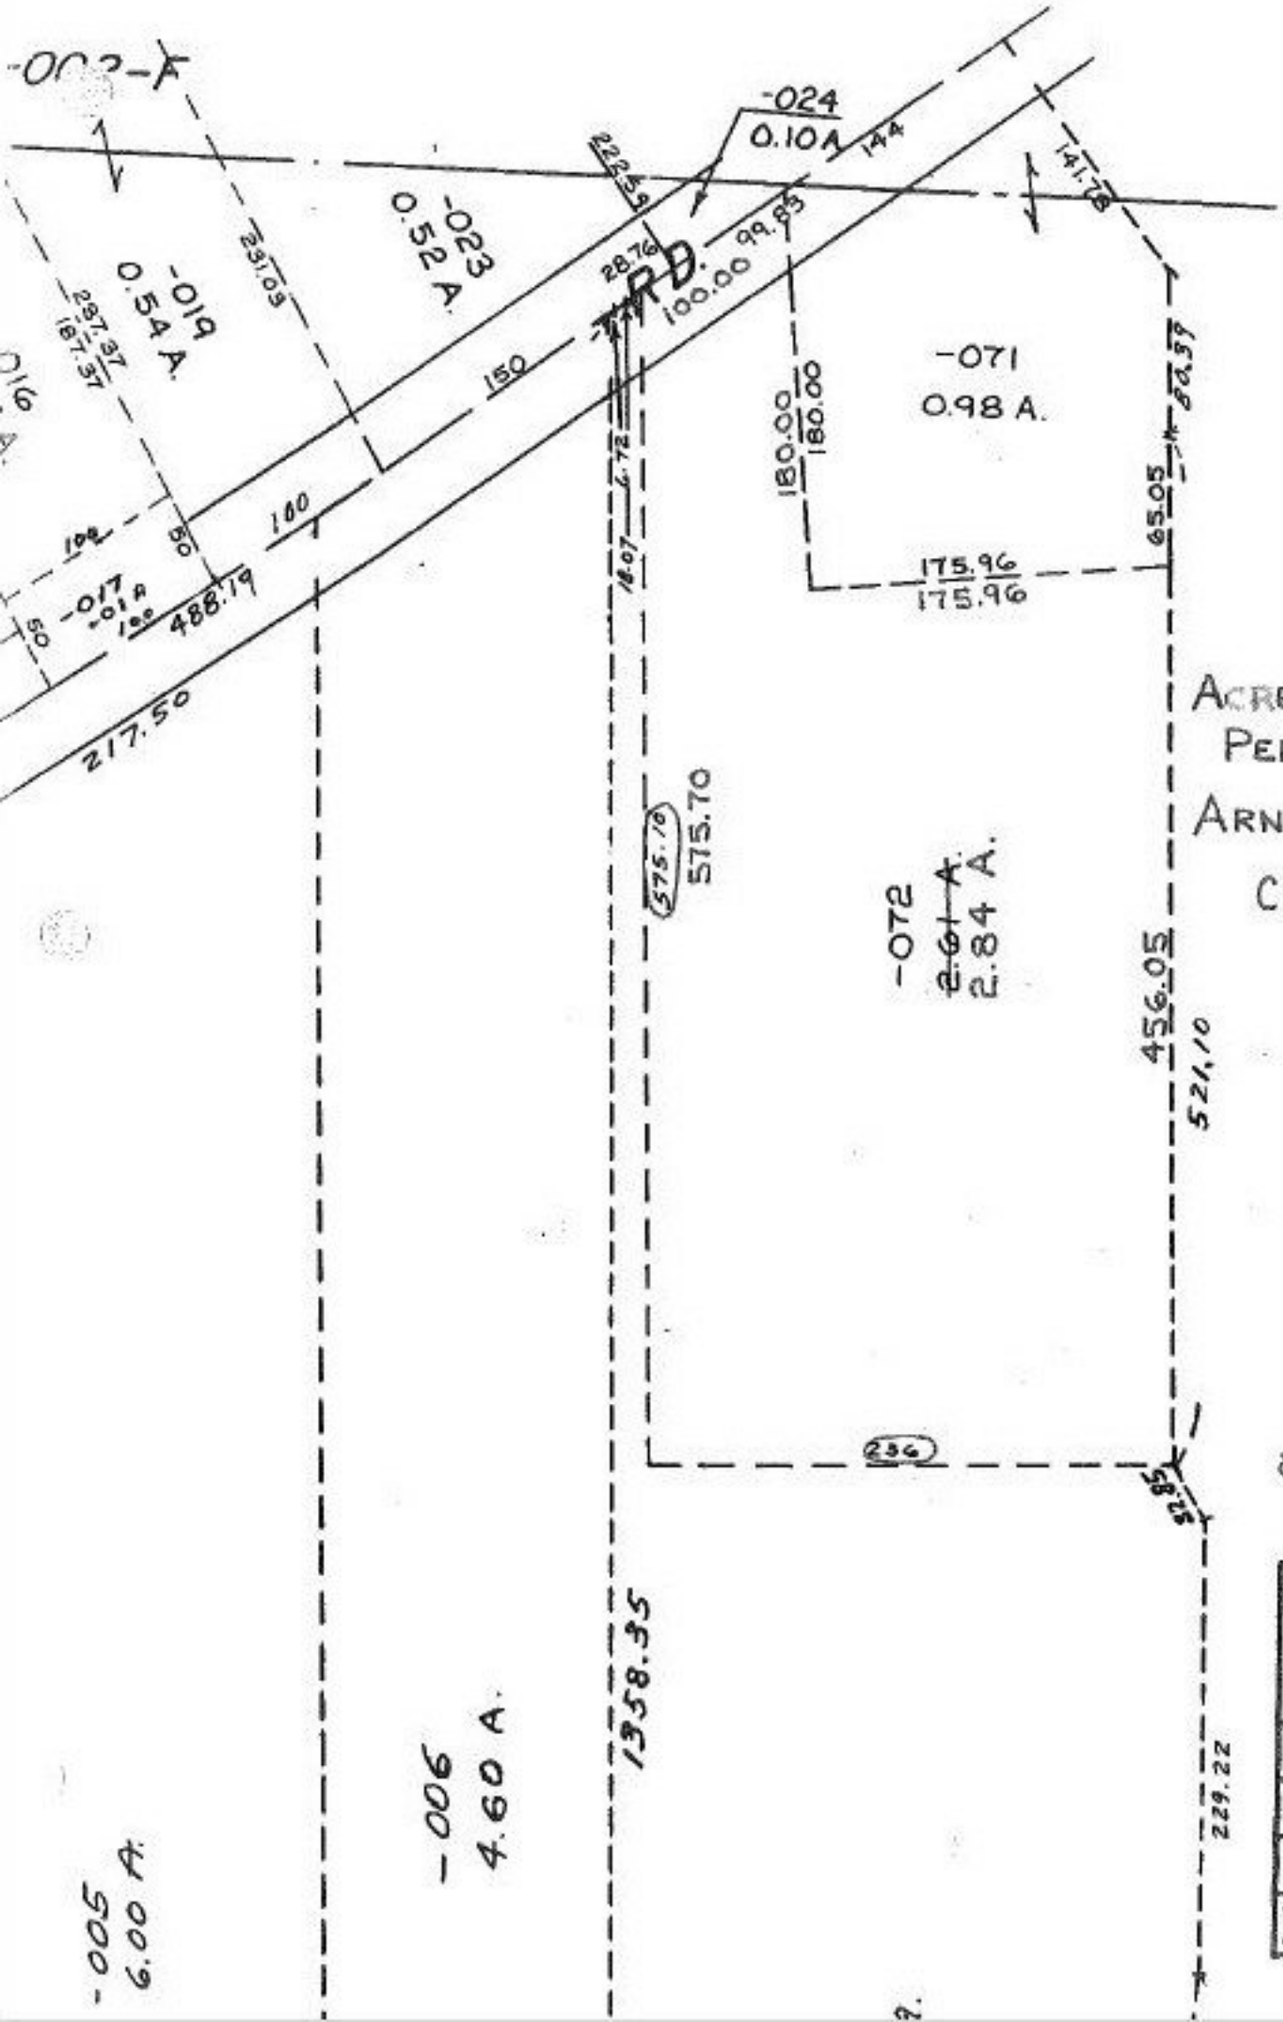

ACREAGE CORR.
PER SURVEY BY
ARNOLD F. KOEPP.
CLOSURE 1:18,181

10-29-87
#17688-A

APPROVED
LORAIN CO.
MAP DEPT.

DATE 9-18-87	
PAGE 4-00-001-B	
BY T. HOLLIS	
VOID AFTER	17688-A