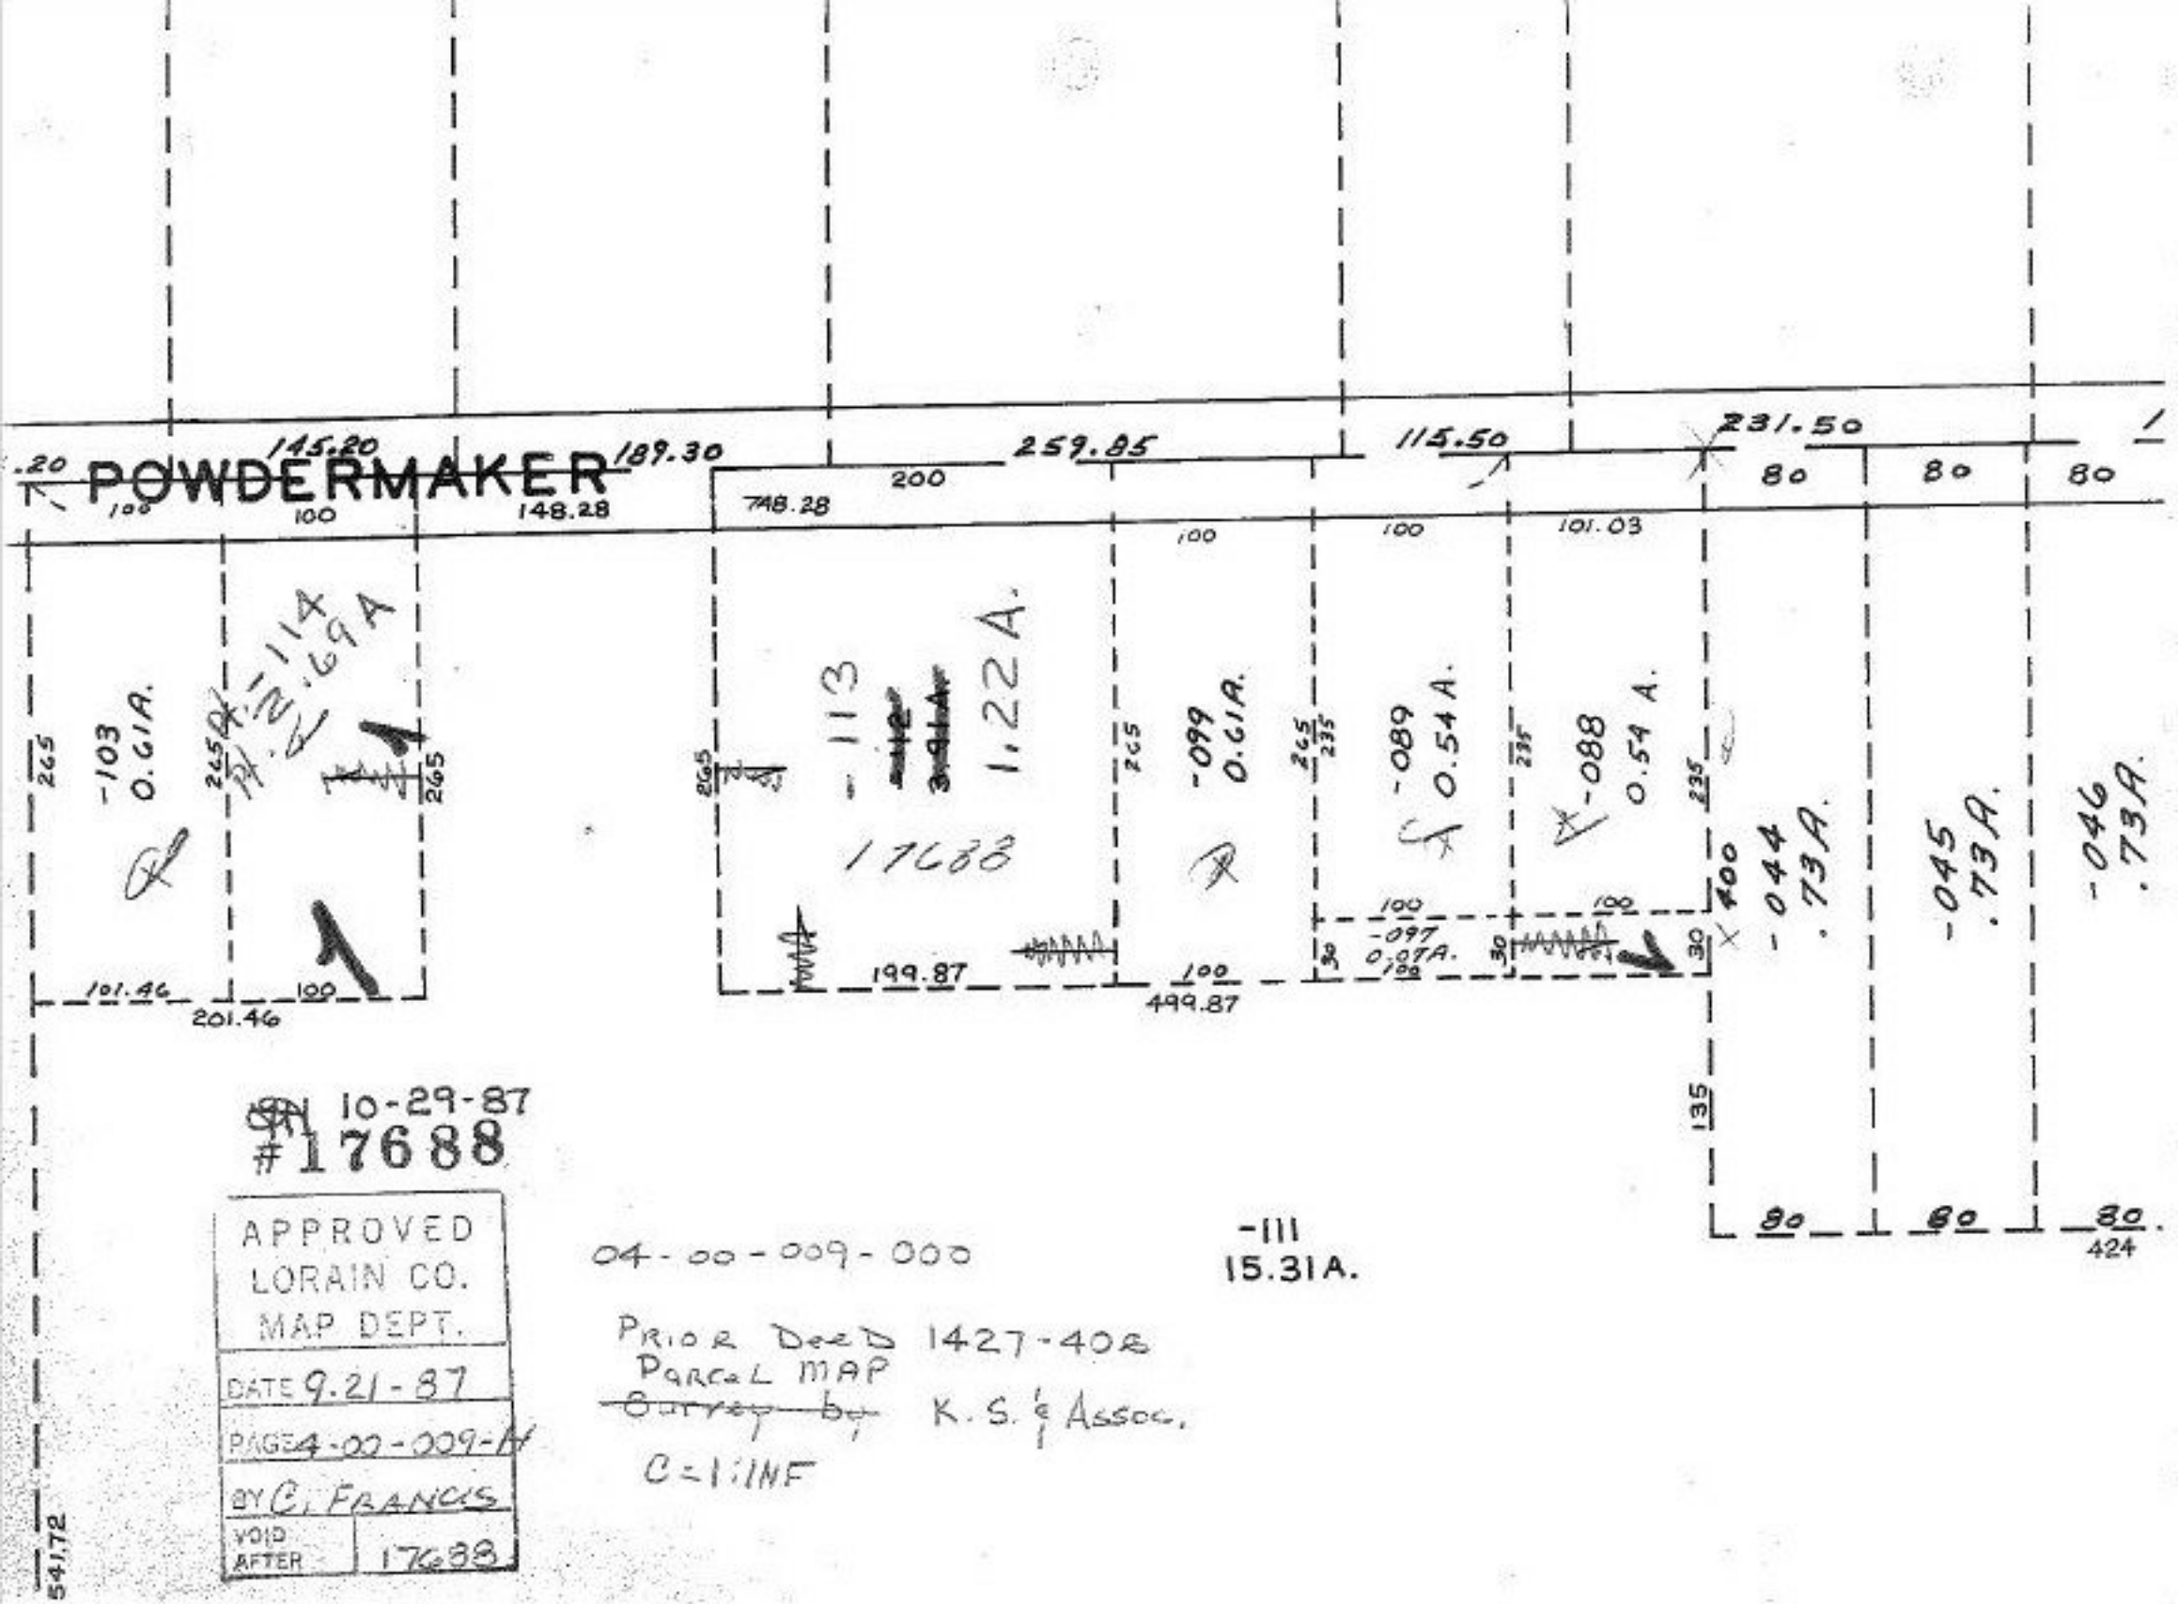

10-29-87
#17688

APPROVED
LORAIN CO.
MAP DEPT.
DATE 9.21-87
PAGE 4-00-009-000
BY C. FRANCIS
VOID AFTER 17688

04-00-009-000

-111
15.31A.

PRIOR DEED 1427-408
PARCEL MAP
~~Survey by~~ K. S. & Assoc.
C=1:INF