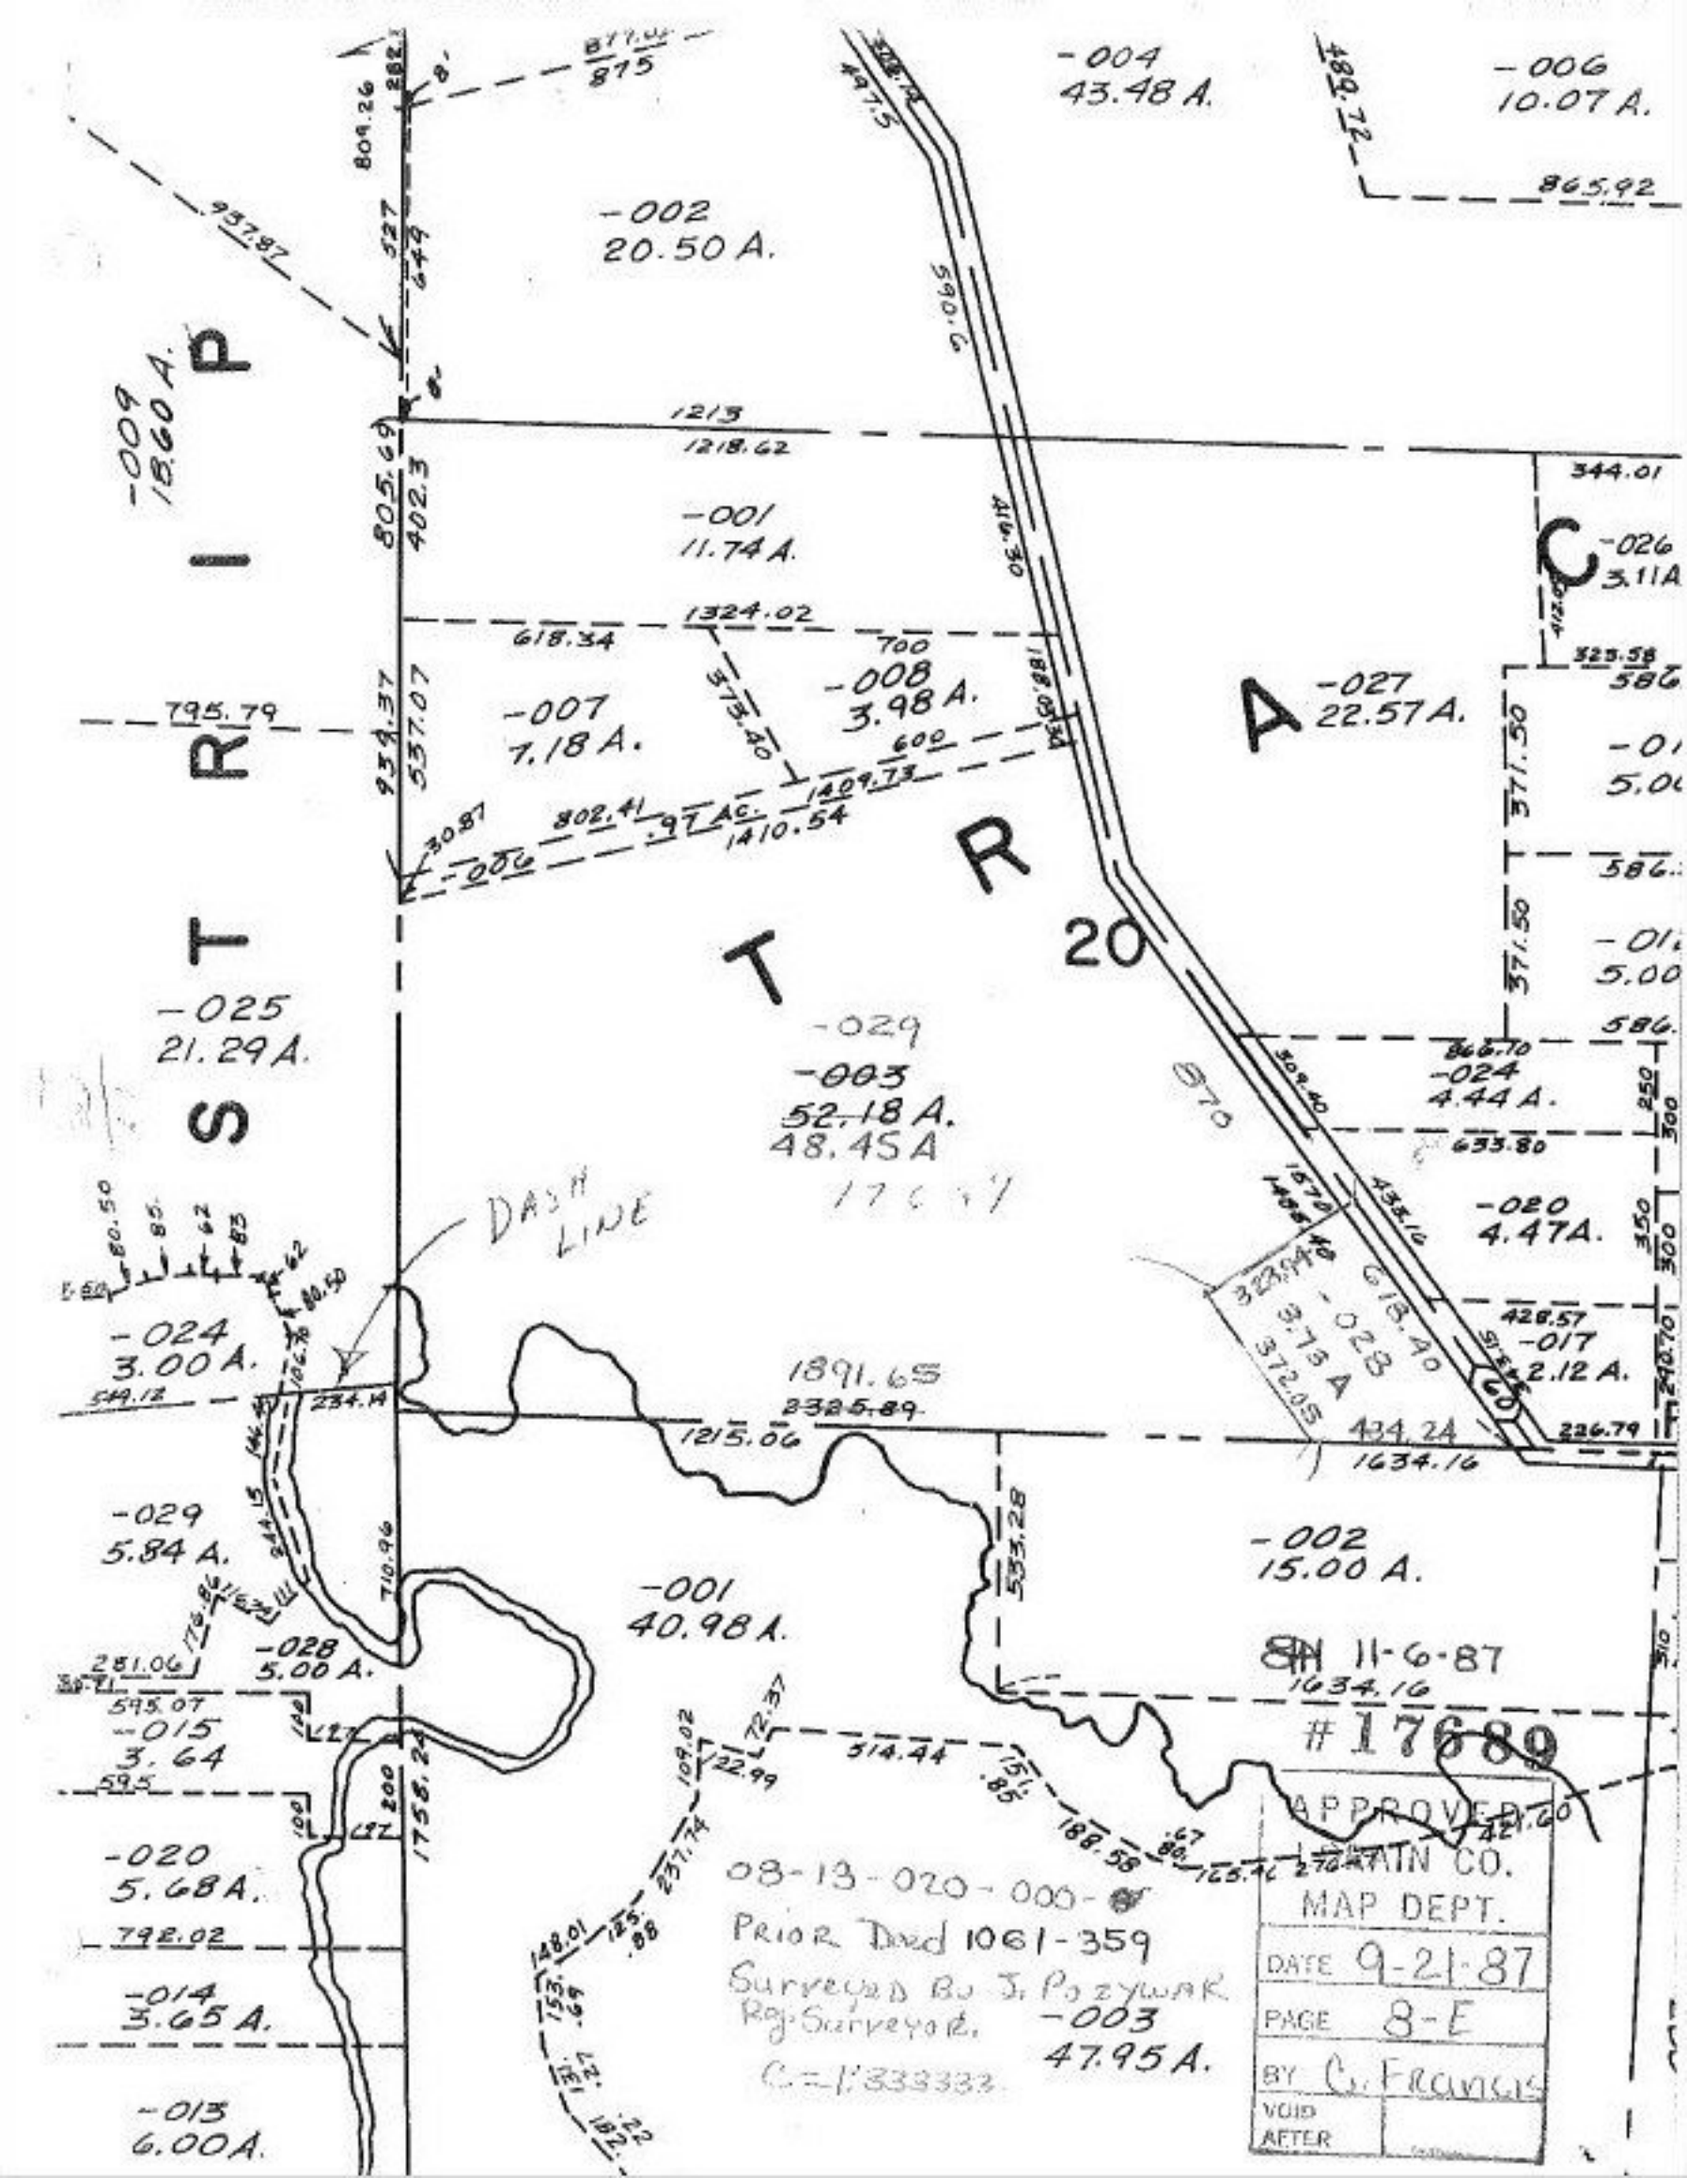

-004
43.48 A.
-006
10.07 A.
865.92
-002
20.50 A.
-009
18.60 A.
1213
1218.62
-001
11.74 A.
344.01
-026
3.11A
1324.02
618.34
700
-008
3.98 A.
-027
22.57 A.
795.79
-007
7.18 A.
600
1409.73
802.41
.97 AC.
1410.54
-006
20
-025
21.29 A.
-029
-003
52.18 A.
48.45 A
-024
4.44 A.
633.80
-020
4.47A.
DASH LINE
-024
3.00 A.
1891.65
2325.89
1215.06
434.24
1634.16
-017
2.12 A.
-029
5.84 A.
-002
15.00 A.
-001
40.98 A.
-028
5.00 A.
11-6-87
1634.16
#17689
-015
3.64
514.44
-020
5.68 A.
08-13-020-000-
Prior Deed 1061-359
Surveyed By J. Pozywak
Reg. Surveyor.
C=1:333333
-003
47.95 A.
-014
3.65 A.
-013
6.00 A.
APPROVED
LORAIN CO.
MAP DEPT.
DATE 9-21-87
PAGE 8-E
BY C. Francis
VOID AFTER