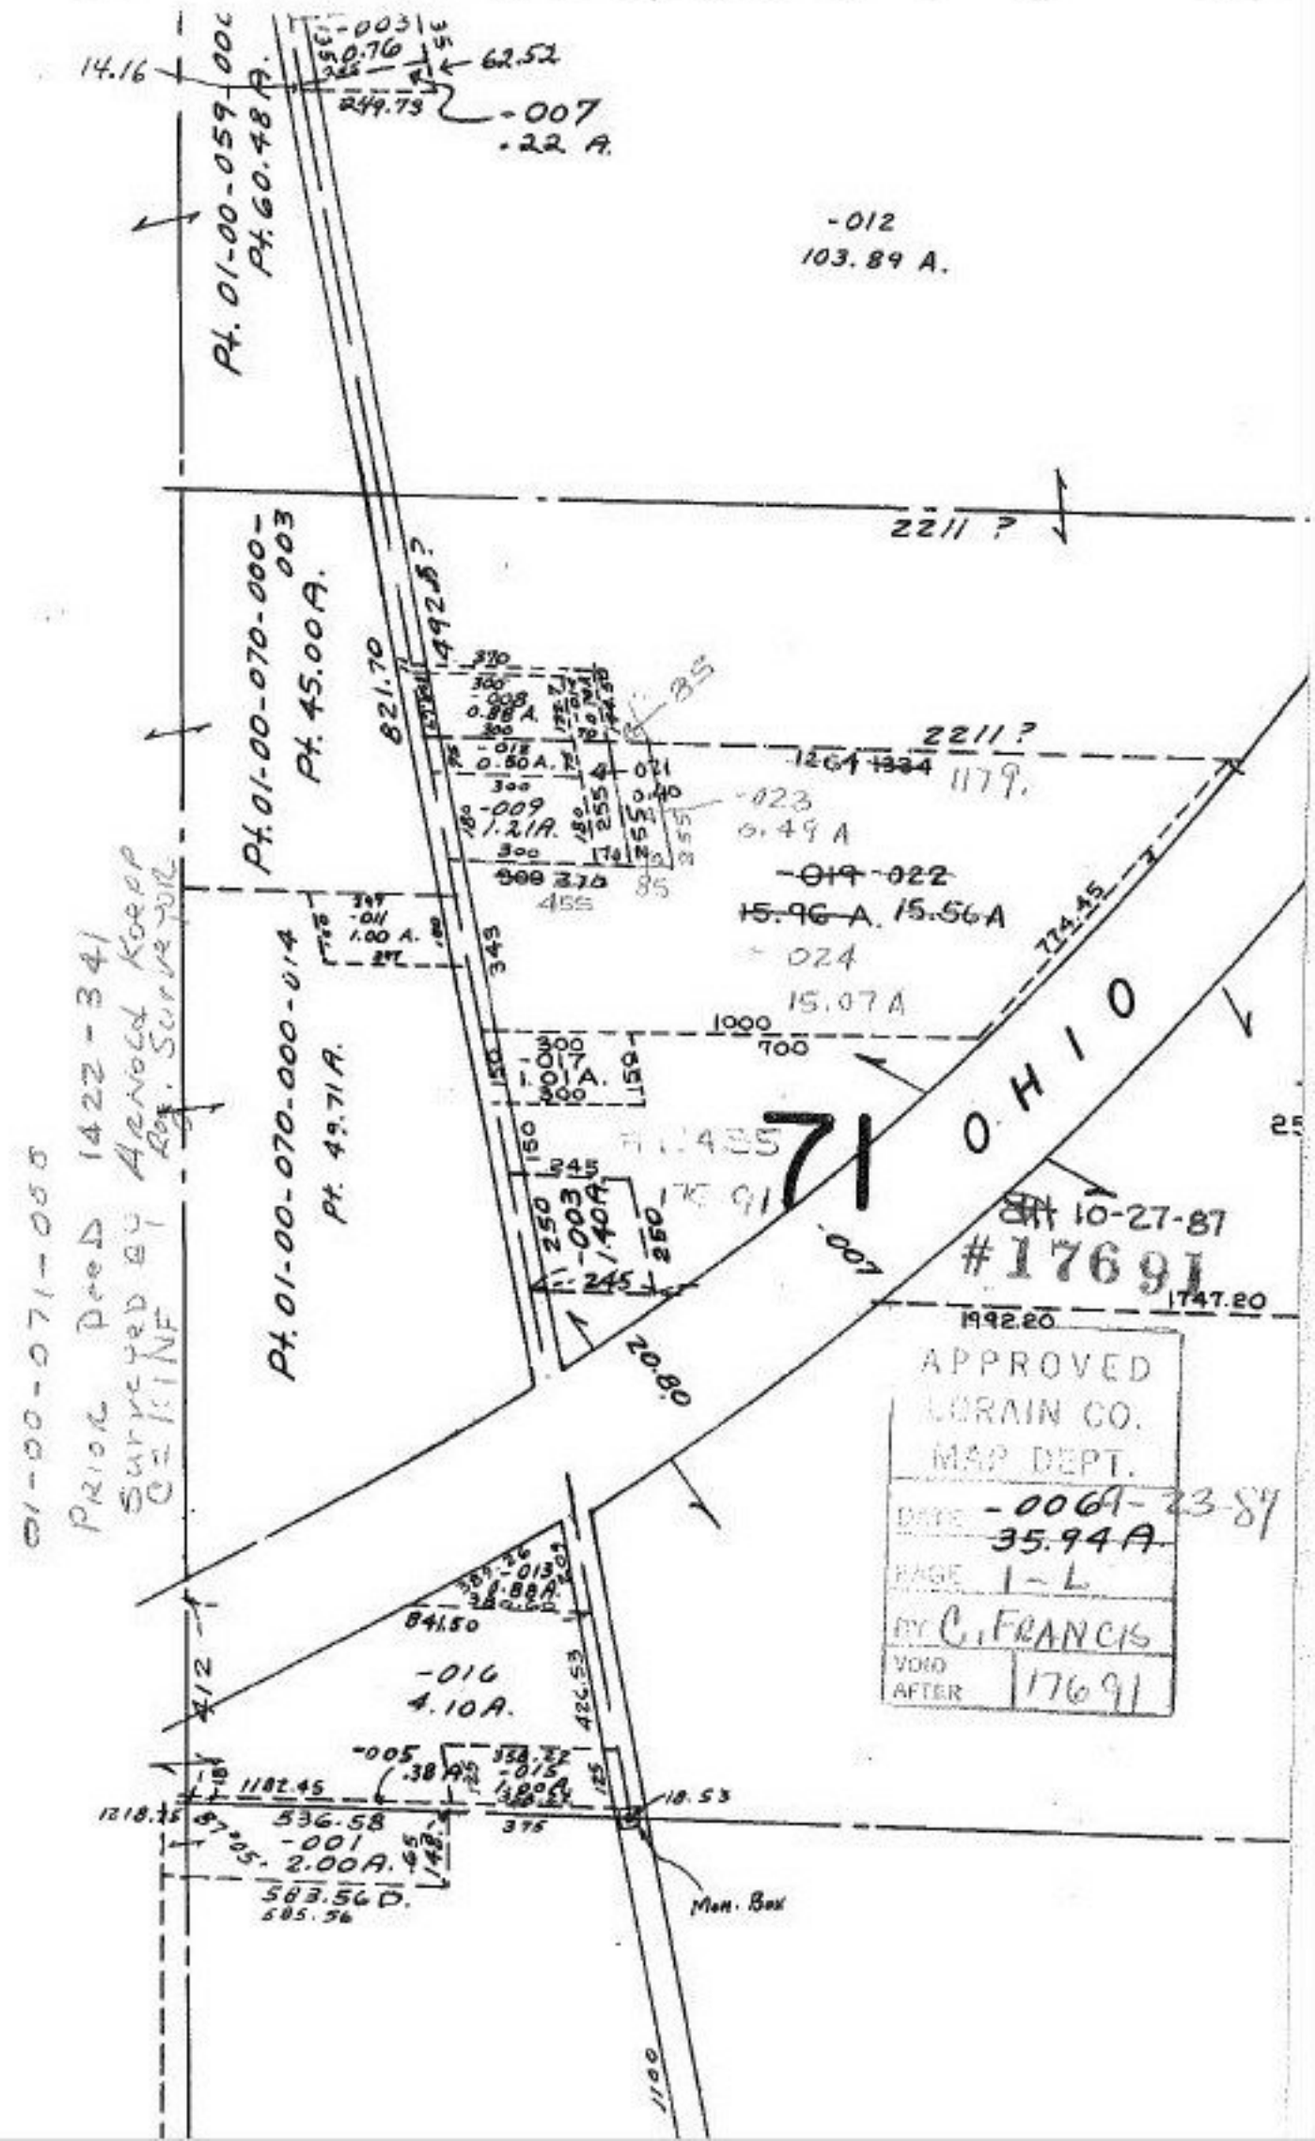
14.16
-003
0.76 A.
62.52
249.73
-007
.22 A.
-012
103.89 A.
Pt. 01-00-059-000
Pt. 60.48 A.
2211 ?
Pt. 01-00-070-000-003
Pt. 45.00A.
821.70
1492.5?
-009
1.21A.
-023
0.49 A
-019 -022
15.96 A. 15.56A
-024
15.07A
724.45
OHIO
71
Pt. 01-00-070-000-014
Pt. 49.71A.
-003
1.40A.
-007
20.80
1992.20
1747.20
APPROVED
LORAIN CO.
MAP DEPT.
DATE 10-27-87
#17691
35.94A.
PAGE 1-L
BY C. FRANCIS
VOID AFTER 17691
841.50
-016
4.10A.
-005
.38 A.
-013
1.88A.
-015
1.80A.
1182.45
536.58
-001
2.00A.
583.56 D.
585.56
18.53
Mon. Box
01-00-071-005
Prior Deed 1422-341
Surveyed by Arnold Koepp
Bk. Surveyor