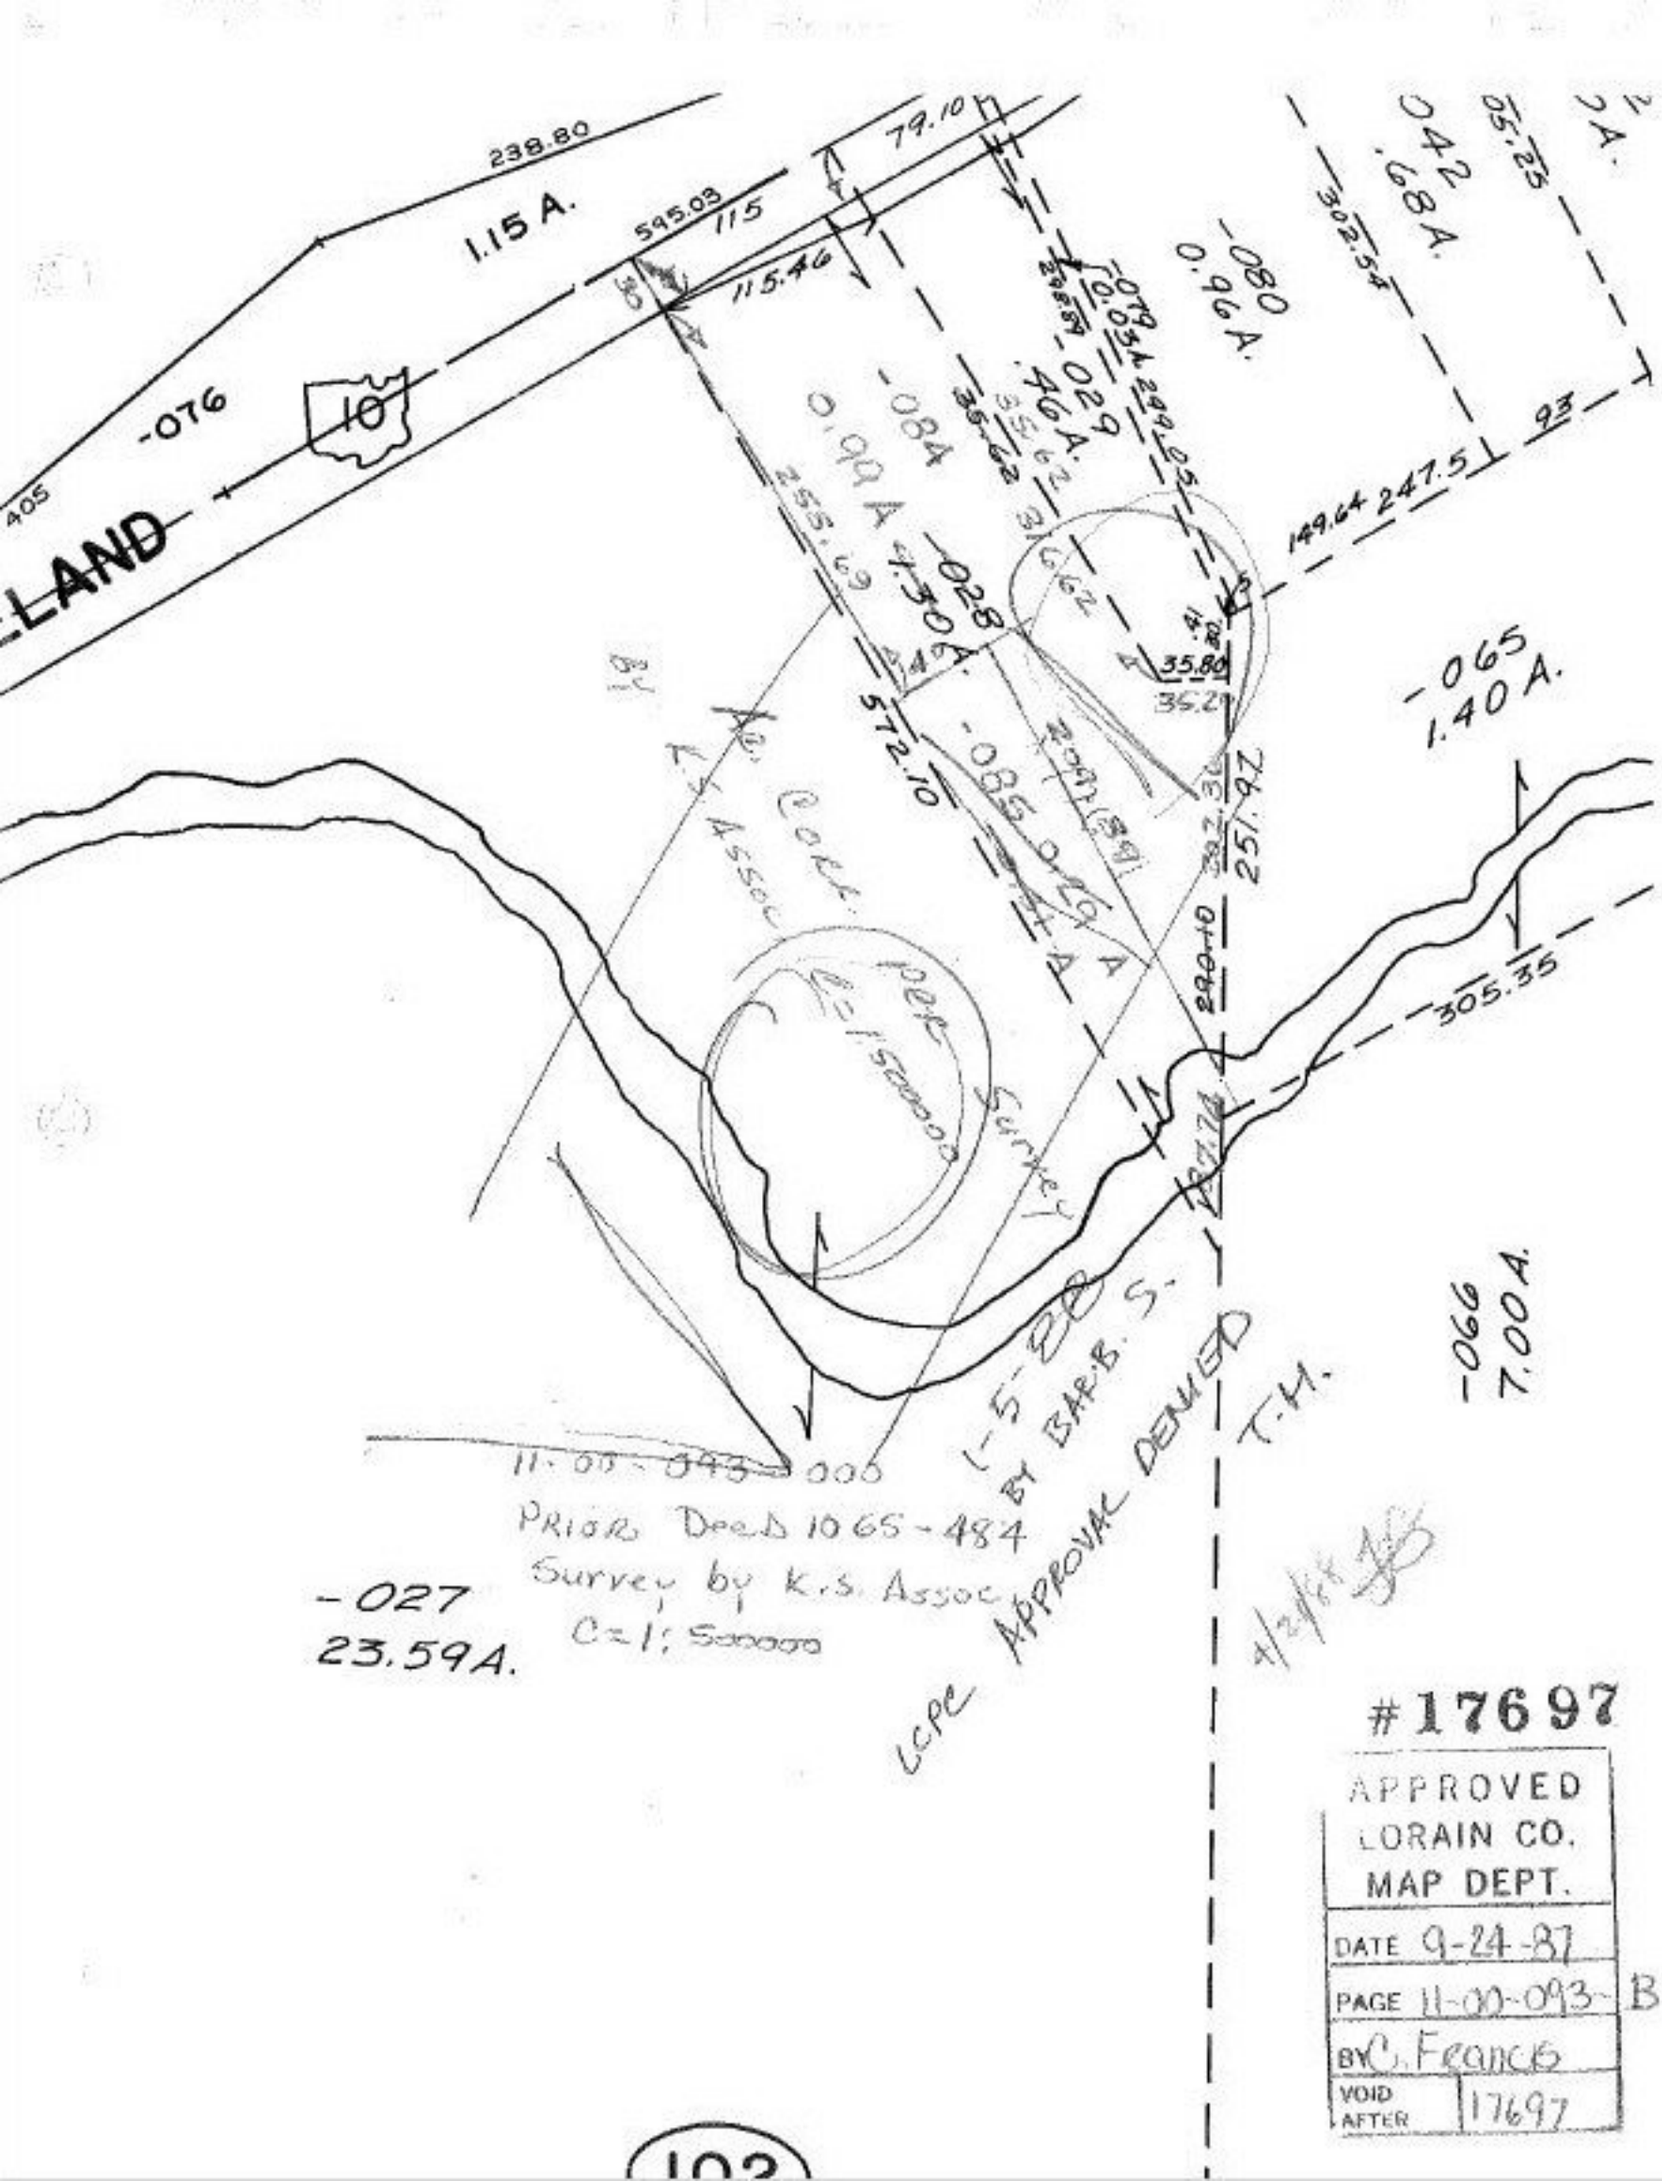

#17697

APPROVED
LORAIN CO.
MAP DEPT.

DATE 9-24-87

PAGE 11-00-093-B

BY C. Frances

VOID AFTER 17697