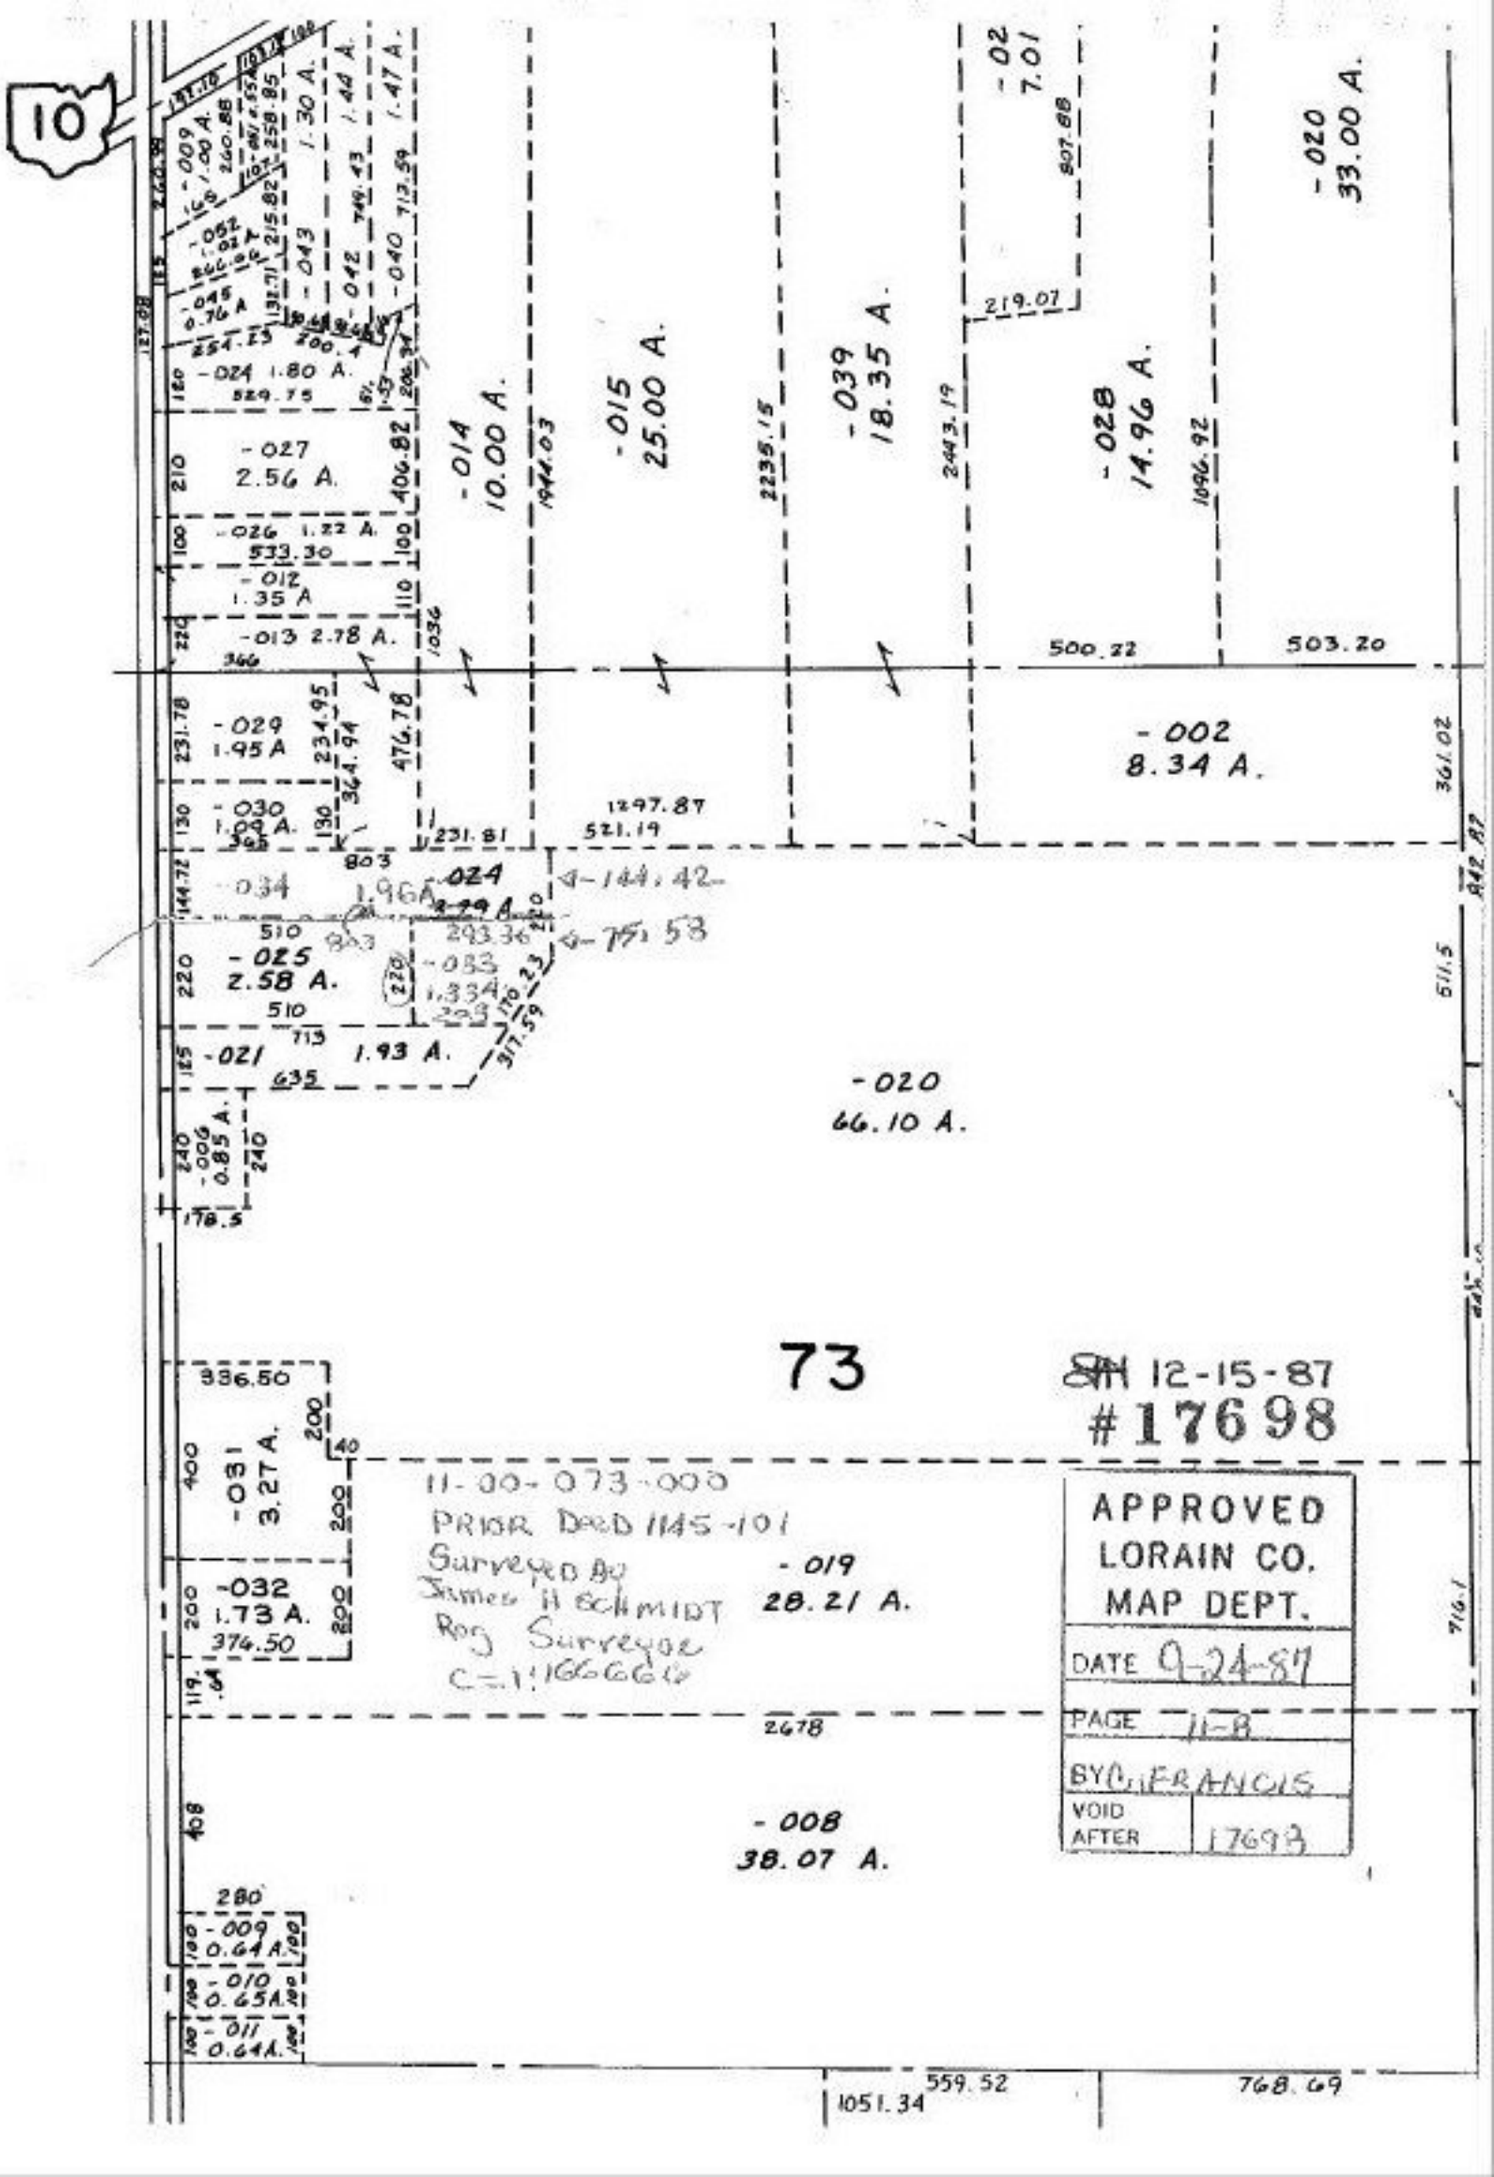
10
-009 1.00 A.
-052
-045 0.76 A.
-043 1.30 A.
-042 1.44 A.
-040 1.47 A.
-024 1.80 A.
-027 2.56 A.
-026 1.22 A.
-012 1.35 A
-013 2.78 A.
-014 10.00 A.
-015 25.00 A.
-039 18.35 A.
-028 14.96 A.
-020 33.00 A.
-029 1.95 A
-030 1.00 A.
-034 1.96A
-024 3.29 A
-025 2.58 A.
-033 1.33A
-021 1.93 A.
-006 0.85 A.
-020 66.10 A.
-002 8.34 A.
-031 3.27 A.
-032 1.73 A.
-019 28.21 A.
-008 38.07 A.
-009 0.64 A.
-010 0.65A.
-011 0.64A.
73
SH 12-15-87
#17698
11-00-073-000
PRIOR DEED 1145-101
Surveyed By
James H Schmidt
Reg Surveyor
C-11666
APPROVED
LORAIN CO.
MAP DEPT.
DATE 9-24-87
PAGE 11-B
BY C.F. FRANCIS
VOID AFTER 17693