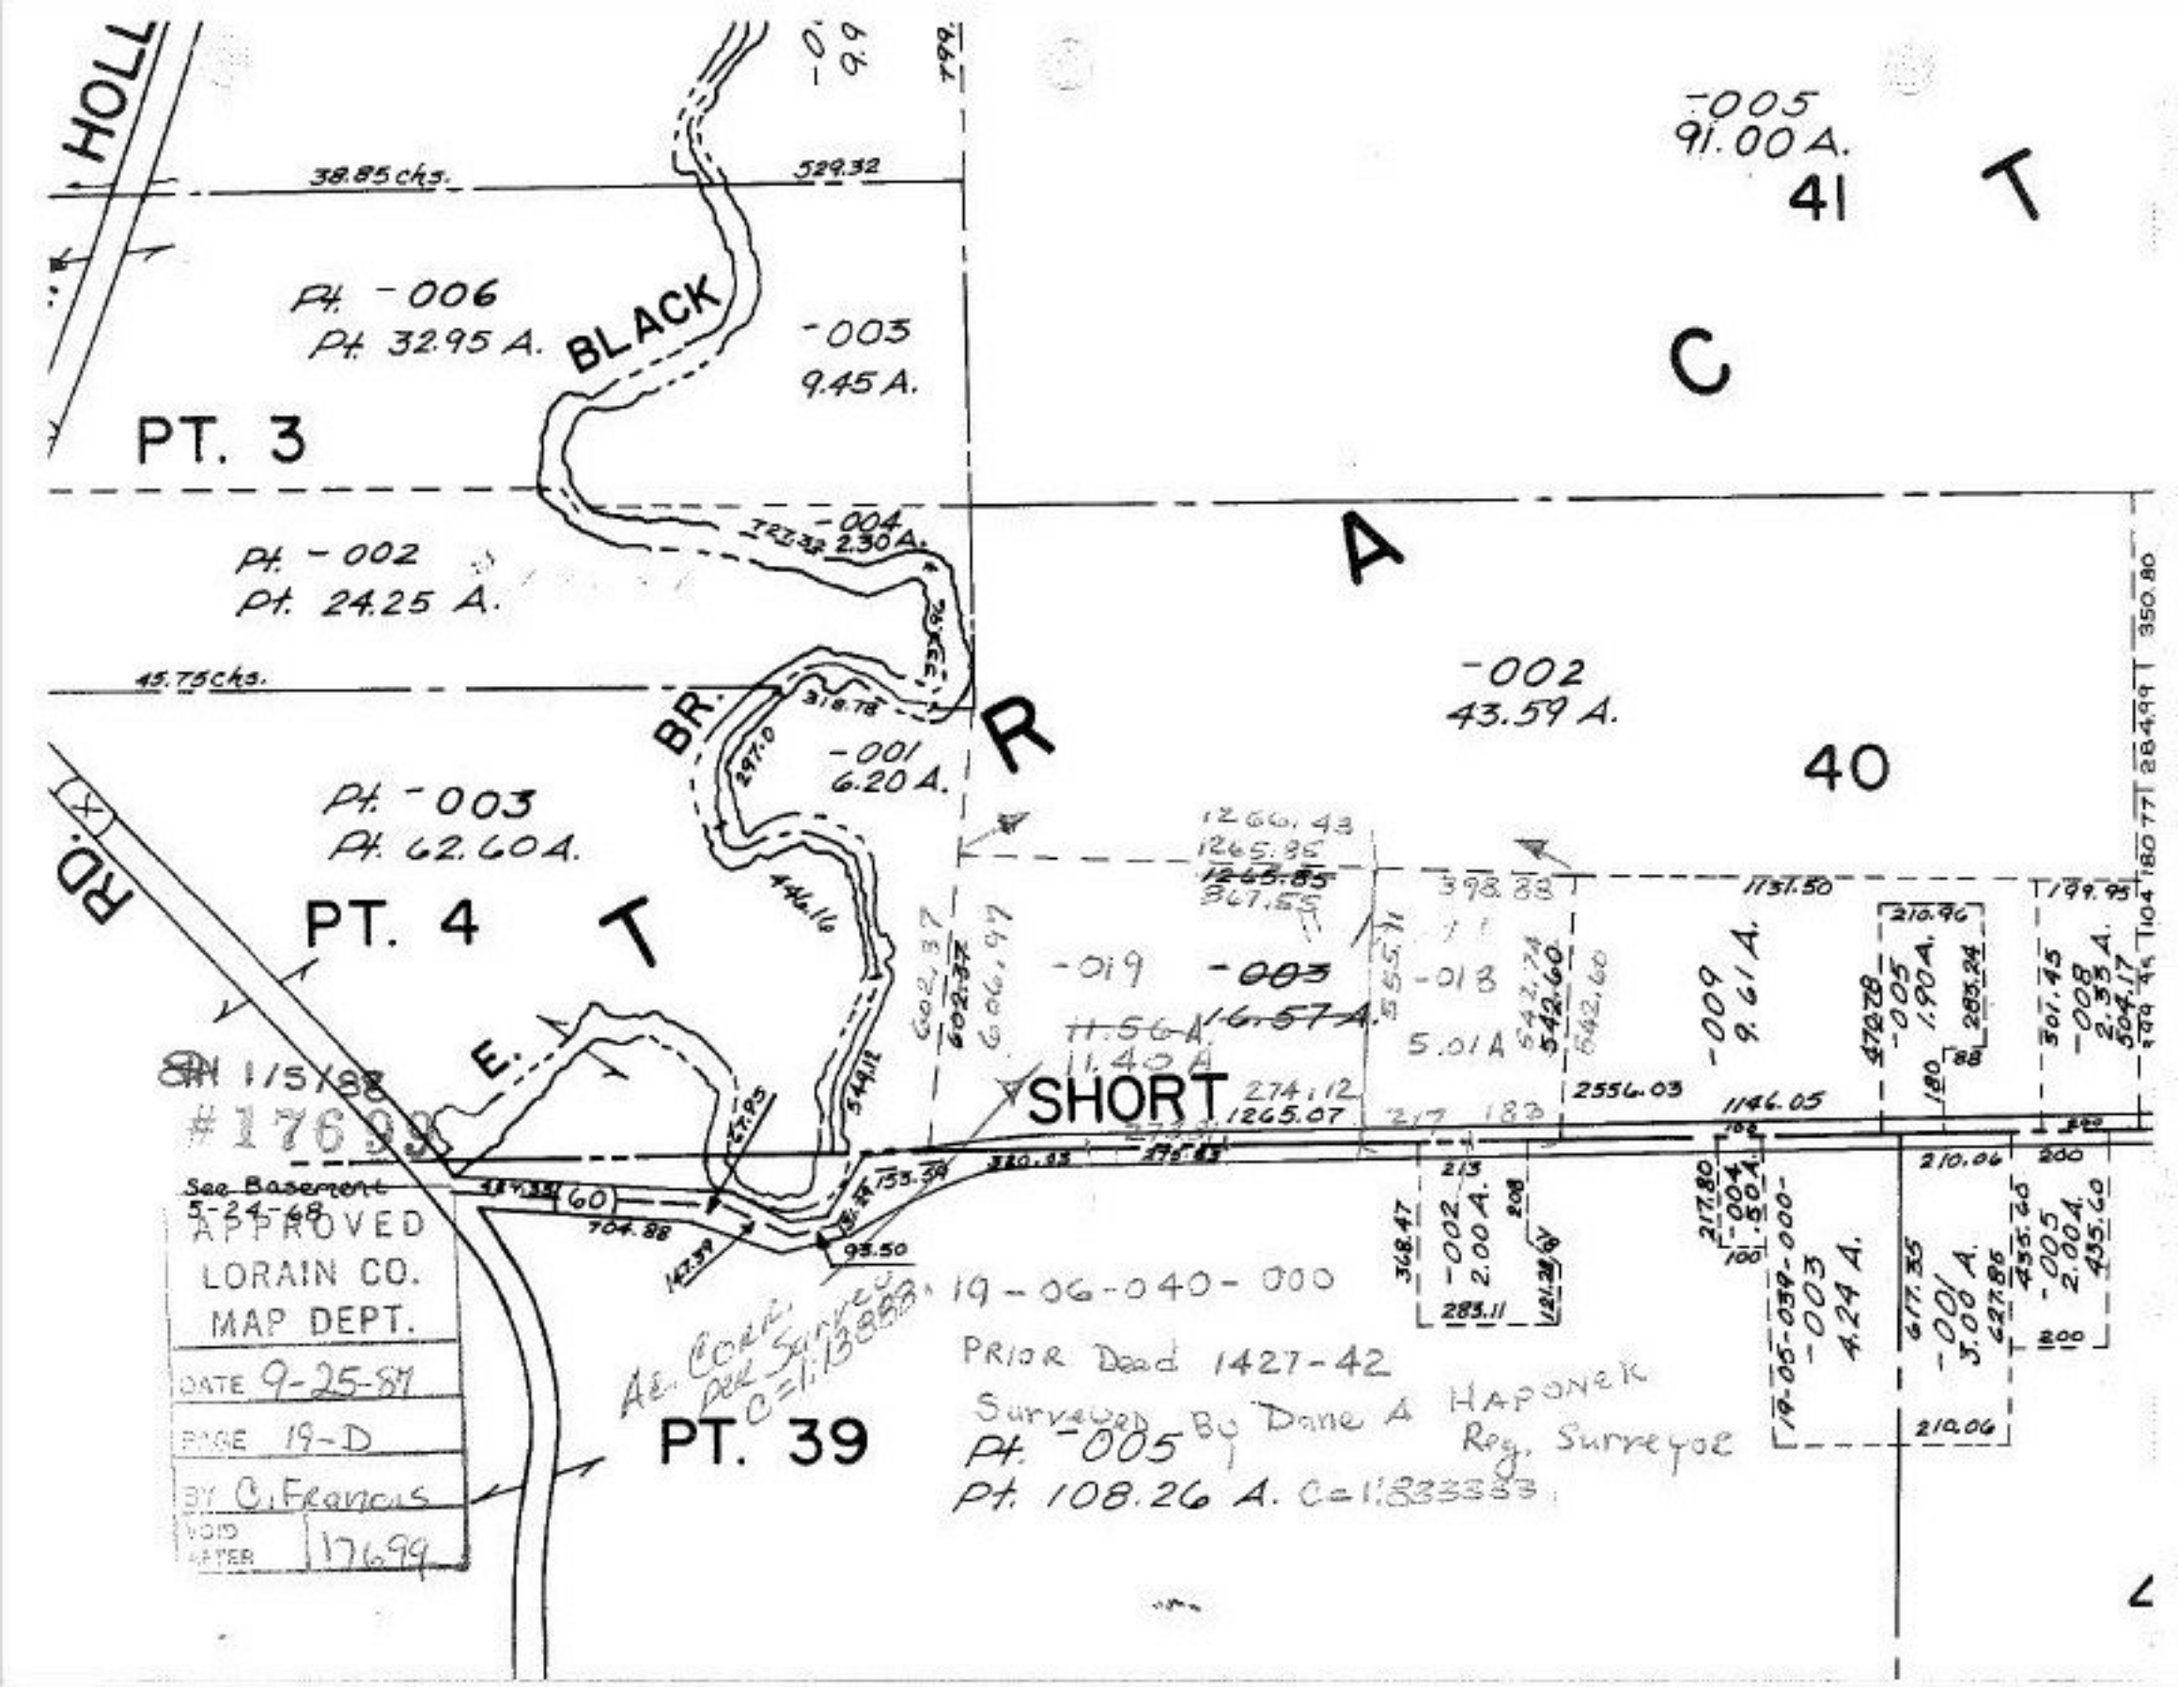
HOLL
38.85 chs.
529.32
-005
91.00 A.
41
T
Pt. -006
Pt. 32.95 A.
BLACK
-003
9.45 A.
C
PT. 3
-004
2.30 A.
Pt. -002
Pt. 24.25 A.
A
45.75 chs.
-002
43.59 A.
BR.
-001
6.20 A.
R
40
Pt. -003
Pt. 62.60 A.
RD.
PT. 4
T
E.
1266.43
1265.85
1265.85
367.55
398.88
1131.50
199.95
-019
-003
16.57 A.
11.56 A.
11.40 A.
-018
5.01 A
542.60
542.60
-009
9.61 A.
210.96
-005
1.90 A.
283.24
301.45
-008
2.33 A.
504.17
SHORT
274.12
1265.07
2556.03
1146.05
1/5/88
#17699
See Basement
5-24-68
60
704.88
93.50
153.59
320.03
-002
2.00 A.
283.11
-004
.50 A.
-003
4.24 A.
19-05-039-000
-001
3.00 A.
-005
2.00 A.
435.60
210.06
19-06-040-000
PRIOR Deed 1427-42
Surveyed By Dane A Haponek
Reg. Surveyor
Pt. -005
Pt. 108.26 A. C=1:833333
PT. 39
Ae. Corr. per Survey C=1:13888
APPROVED
LORAIN CO.
MAP DEPT.
DATE 9-25-87
PAGE 19-D
BY C. Francis
VOID AFTER 17699