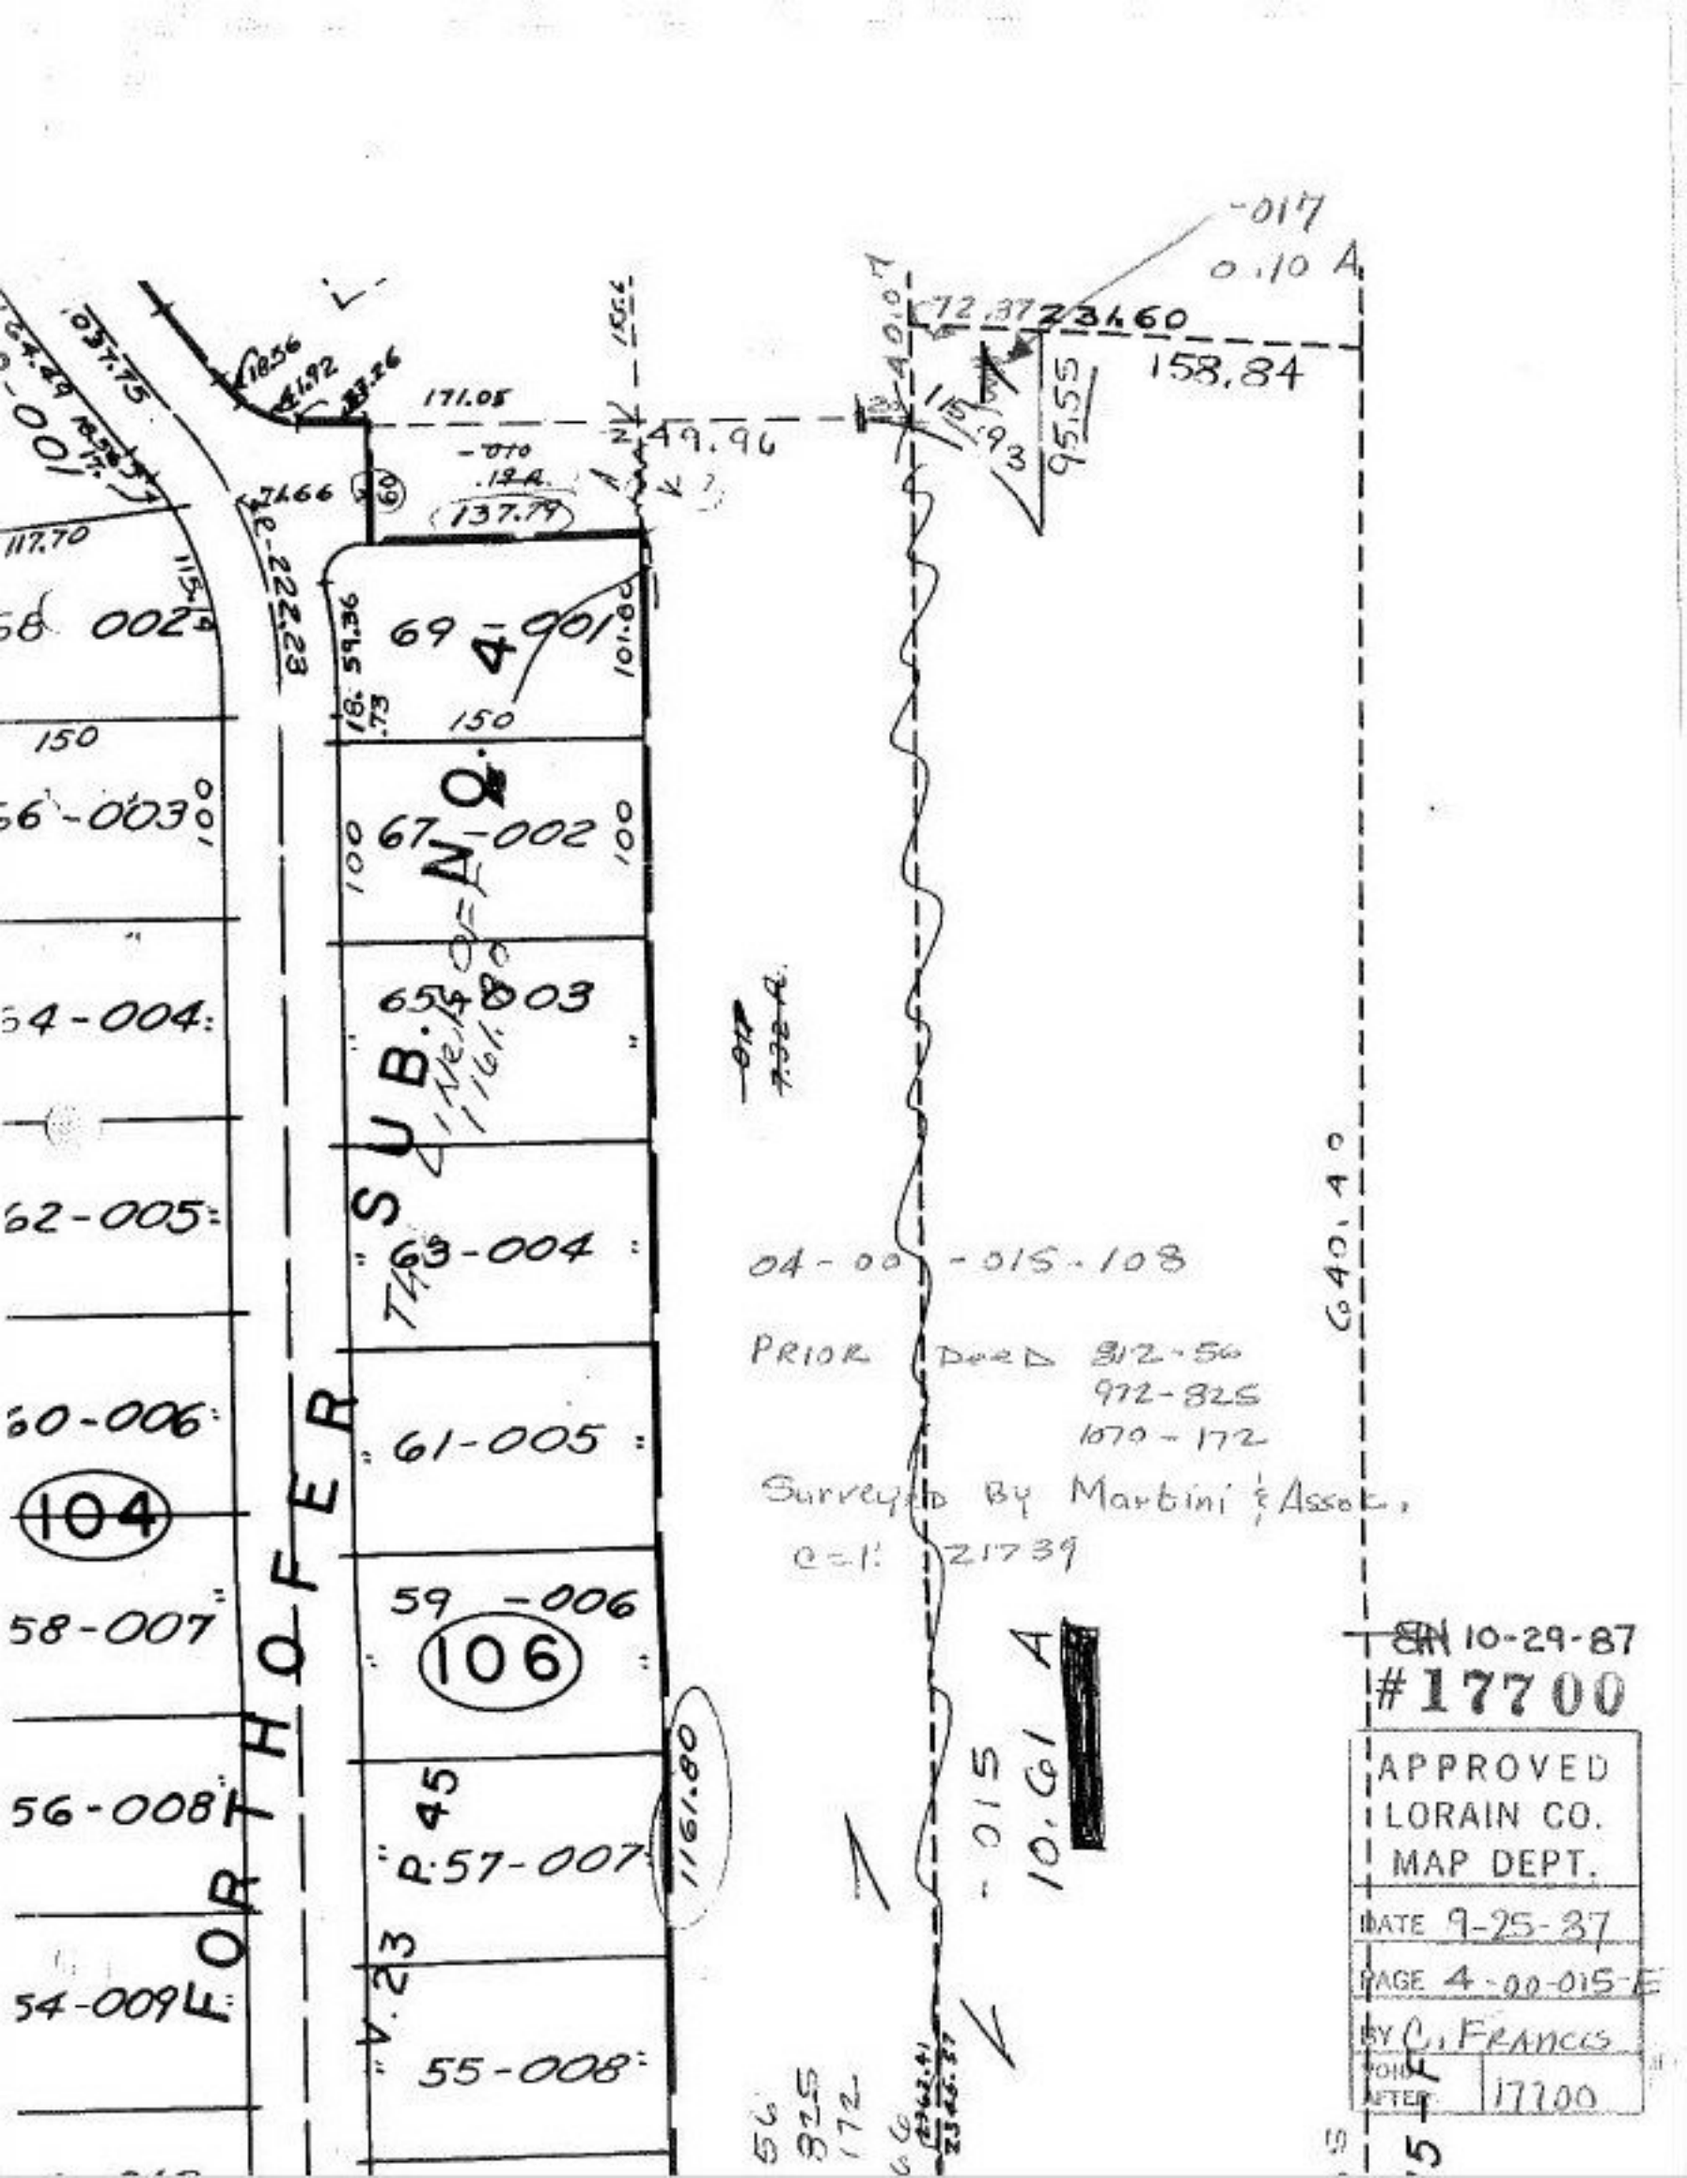
-017
0.10 A
72.37
234.60
158.84
171.05
49.96
95.55
-010
.12 A.
137.79
117.70
150
100
67-002
69 4-001
65 4-003
63-004
61-005
59-006
106
104
58-007
56-008
54-009
55-008
SUB. NO.
NORTHOFER
1161.80
R. 45
V. 23
04-00-015-108
PRIOR DEED 912-50
972-825
1070-172
Surveyed By Martini & Assoc.
C=1: 21739
-015
10.61 A
C40.40
SN 10-29-87
#17700
APPROVED
LORAIN CO.
MAP DEPT.
DATE 9-25-87
PAGE 4-00-015-E
BY C. FRANCIS
VOID AFTER 17700