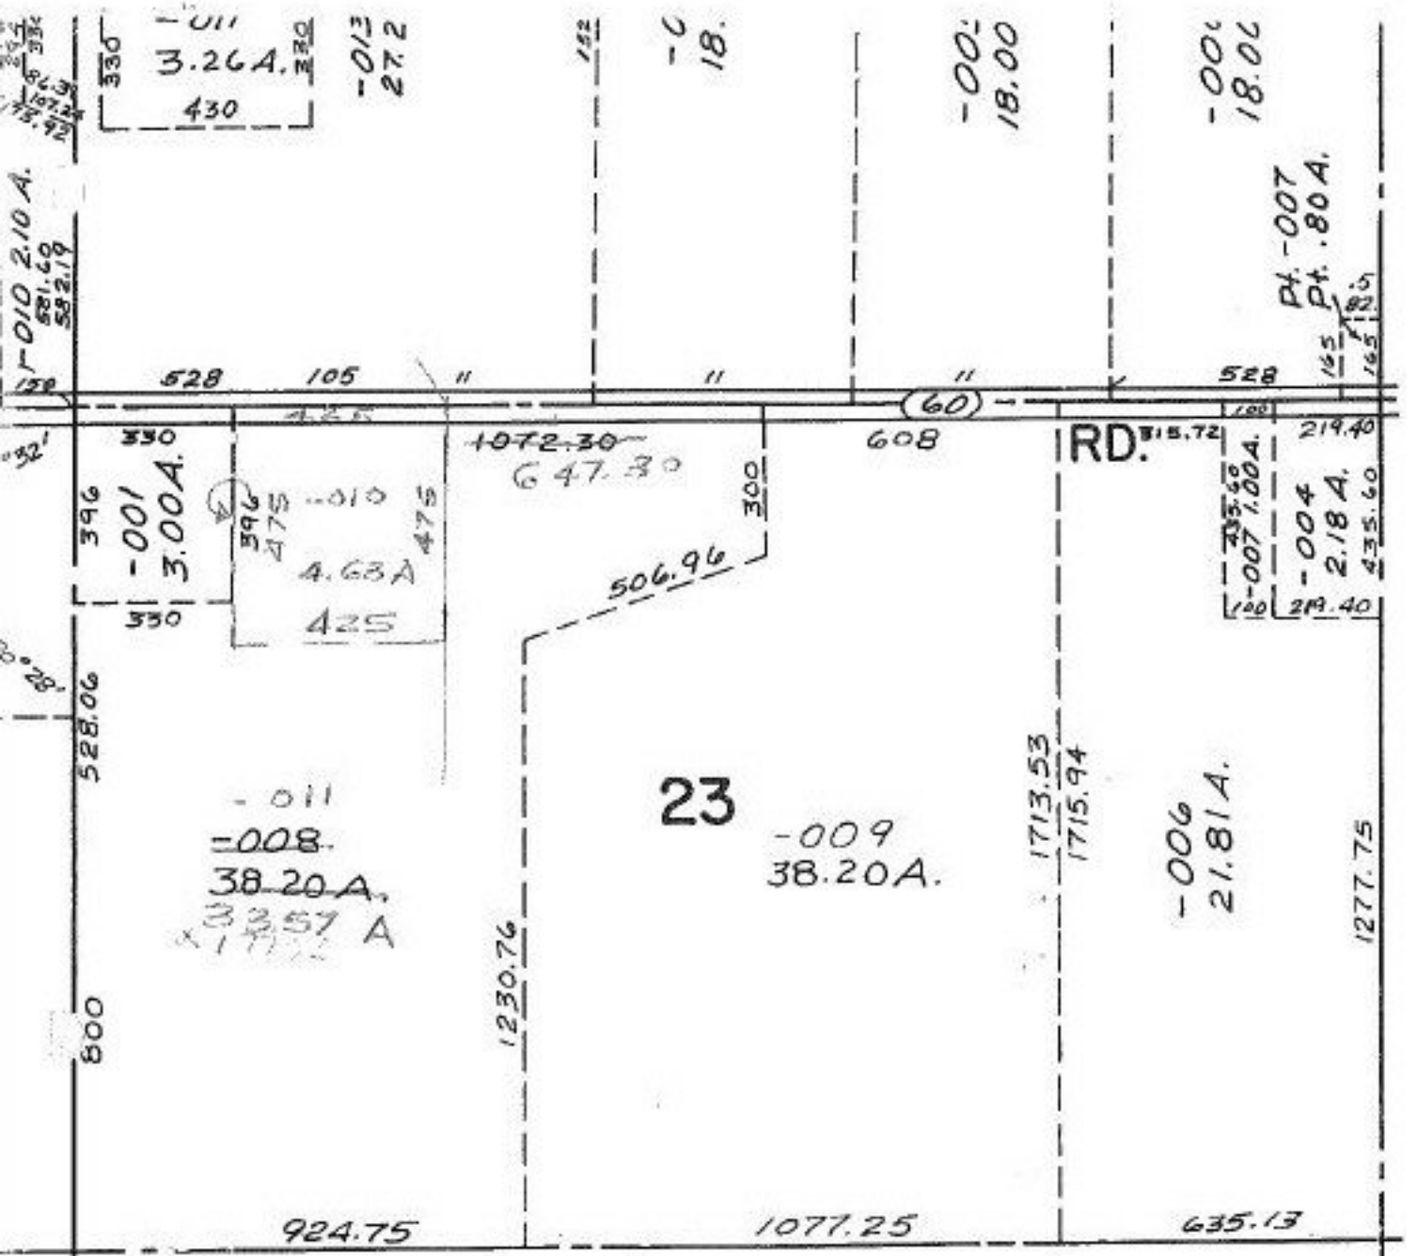


14-00-023-000

Prior Deed

Survey By John Pozywak

Cal INF 38 Reg Surveyor

-003

202.86 A.

12/31/87

#17702

APPROVED
LORAIN CO.
MAP DEPT.

DATE 9-29-87

PAGE 14-C

BY C. FRANCIS

YEAR AFTER 17702