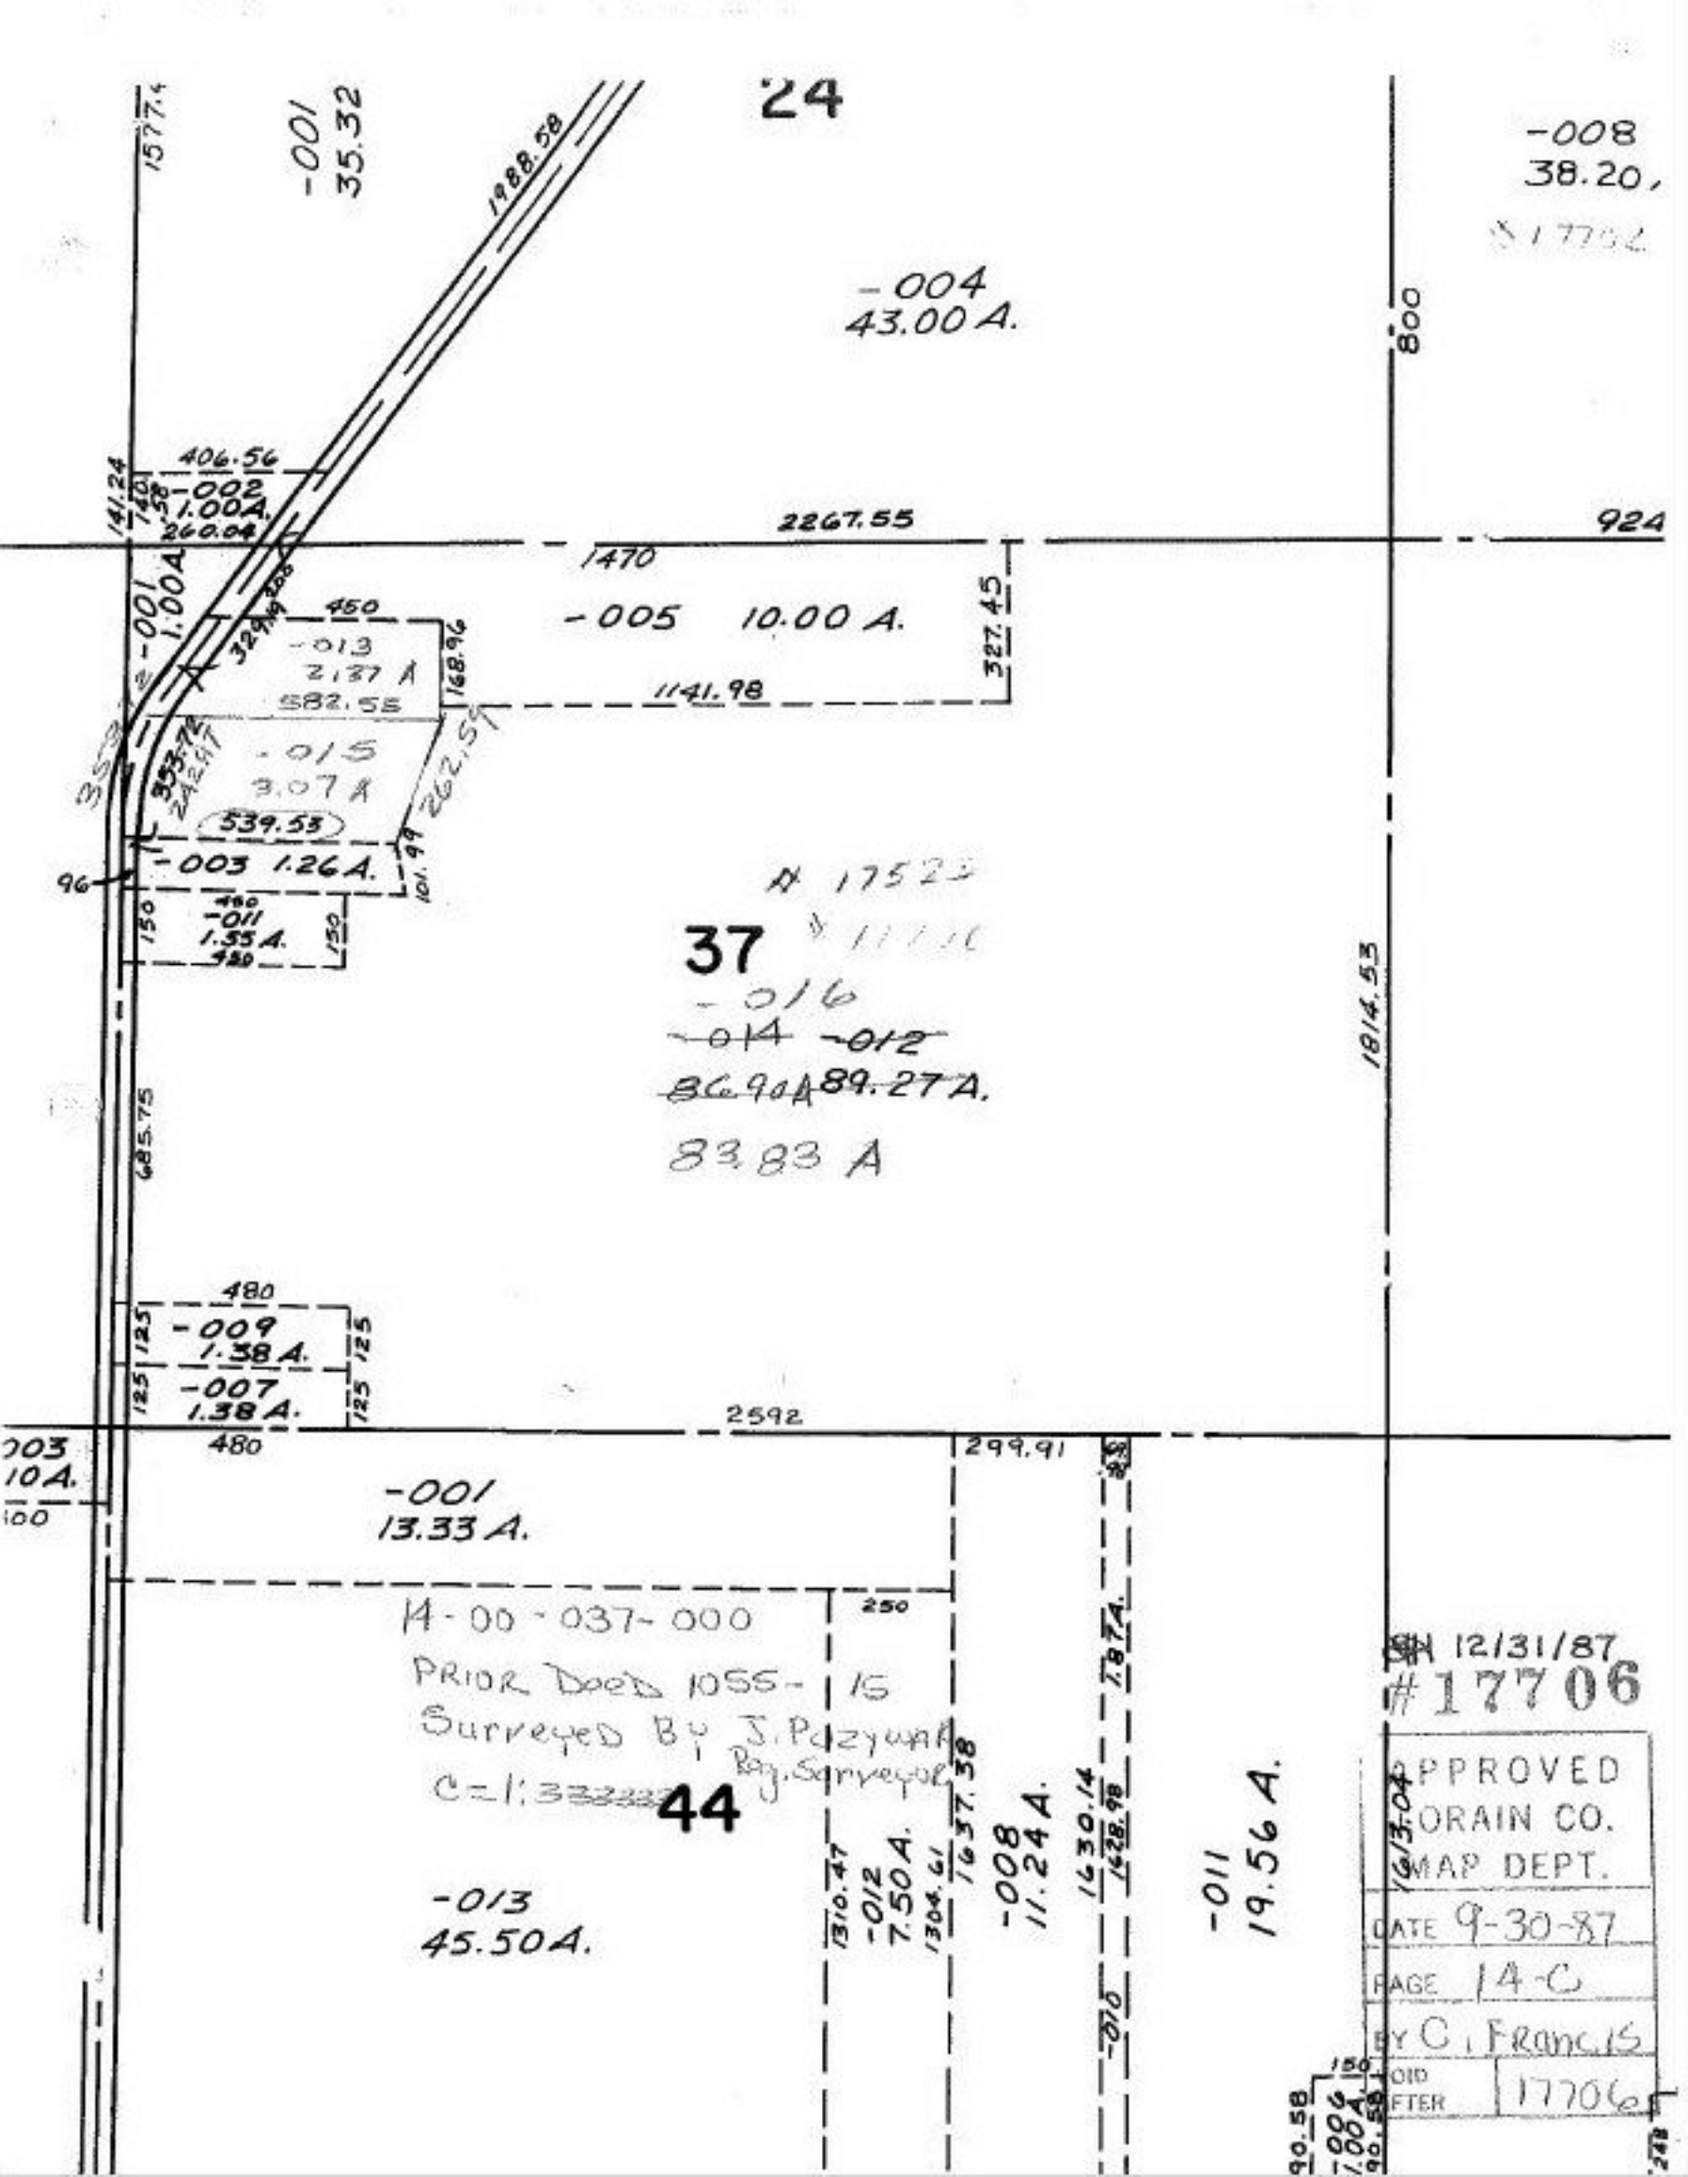
24
-001
35.32
1988.58
-008
38.20,
-004
43.00 A.
800
406.56
-002
1.00A.
260.04
2267.55
924
1470
-001
1.00A.
-005 10.00 A.
327.45
450
-013
2.37 A
582.55
168.96
1141.98
-015
3.07 A
539.53
262.59
-003 1.26A.
96
480
-011
1.55 A.
150
150
37
-016
-014 -012
89.27A.
83.83 A
1814.53
685.75
480
-009
1.38 A.
125
125
-007
1.38 A.
125
125
2592
480
299.91
-001
13.33 A.
14-00-037-000
PRIOR DEED 1055-15
Surveyed By J. Palzynak
Reg. Surveyor
44
250
1310.47
-012
7.50A.
1304.61
1637.38
-008
11.24A.
1630.14
1628.98
1.87A.
-010
-011
19.56A.
12/31/87
#17706
APPROVED
LORAIN CO.
MAP DEPT.
DATE 9-30-87
PAGE 14-C
BY C. Francis
VOID AFTER 17706
150
-006
1.00A.
90.58