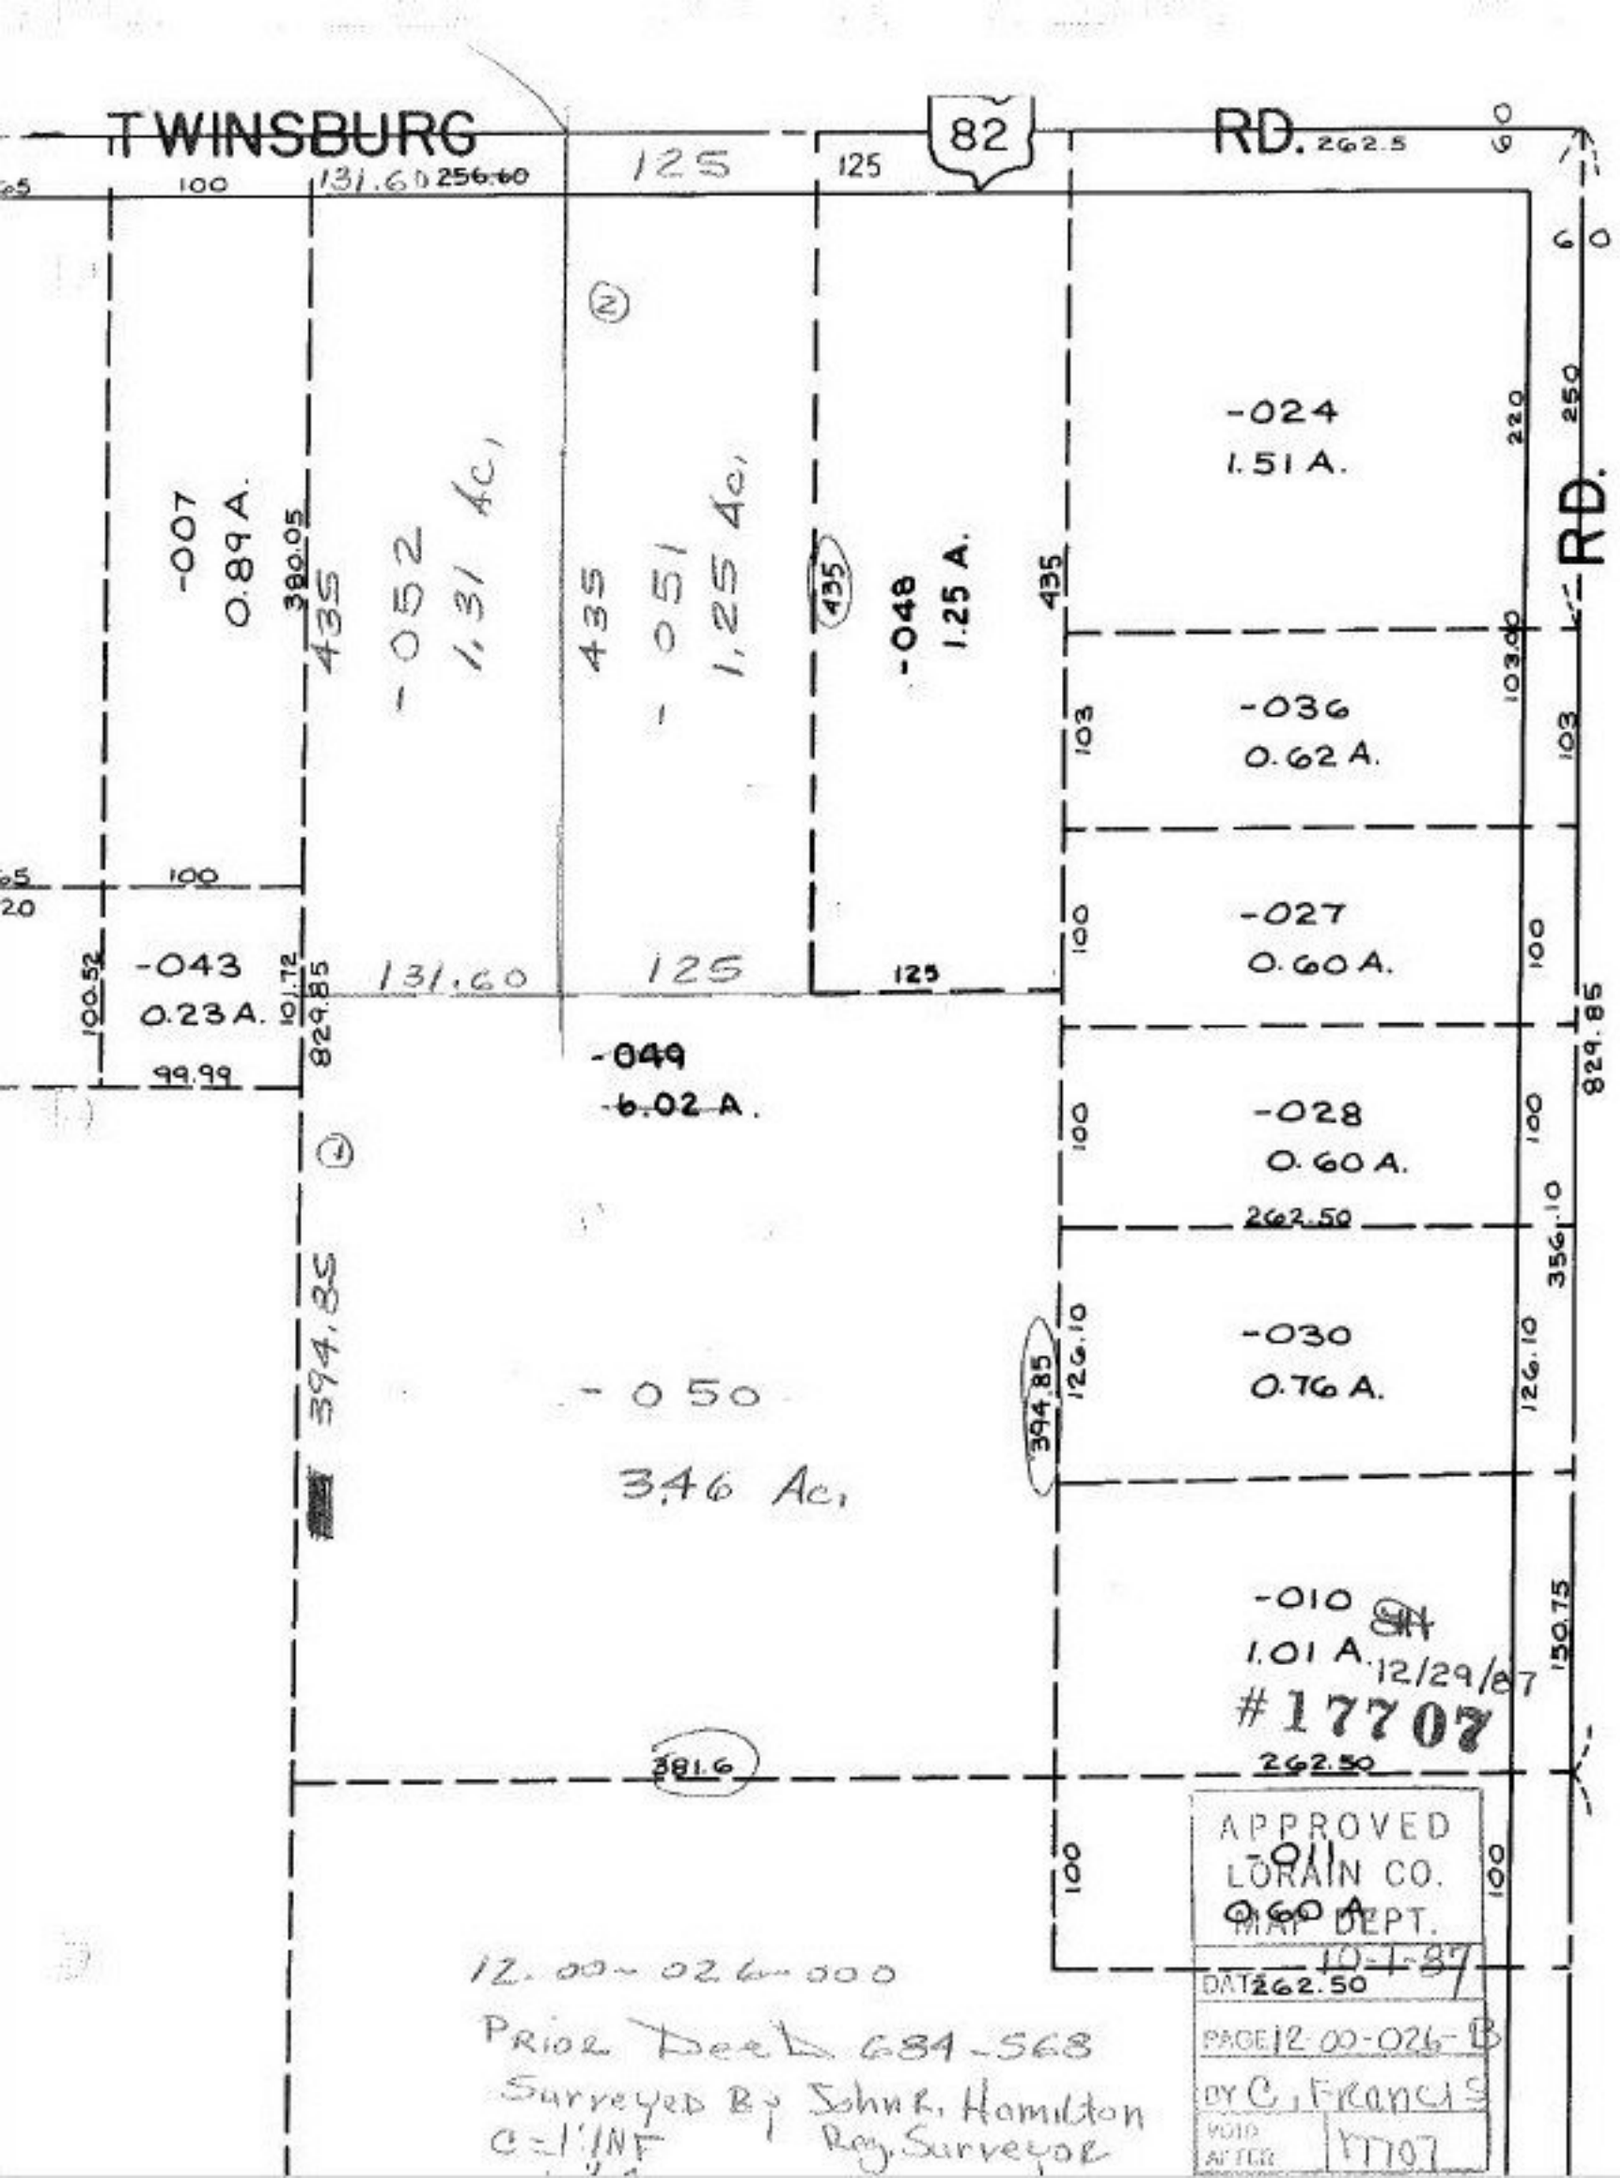
TWINSBURG
RD.
82
RD.
RD.
-007
0.89 A.
-052
1,31 Ac,
-051
1,25 Ac,
-048
1.25 A.
-024
1.51 A.
-036
0.62 A.
-027
0.60 A.
-043
0.23 A.
-049
6.02 A.
-028
0.60 A.
-030
0.76 A.
-050
3.46 Ac,
-010
1.01 A.
12/29/87
#17707
-011
0.60 A.
APPROVED
LORAIN CO.
MAP DEPT.
DAT 10-1-87
PAGE 12-00-026-B
BY C. Francis
VOID AFTER 17707
12.00-026.000
PRIOR DEED 684-568
Surveyed By John R. Hamilton
Reg. Surveyor
C=1'INF