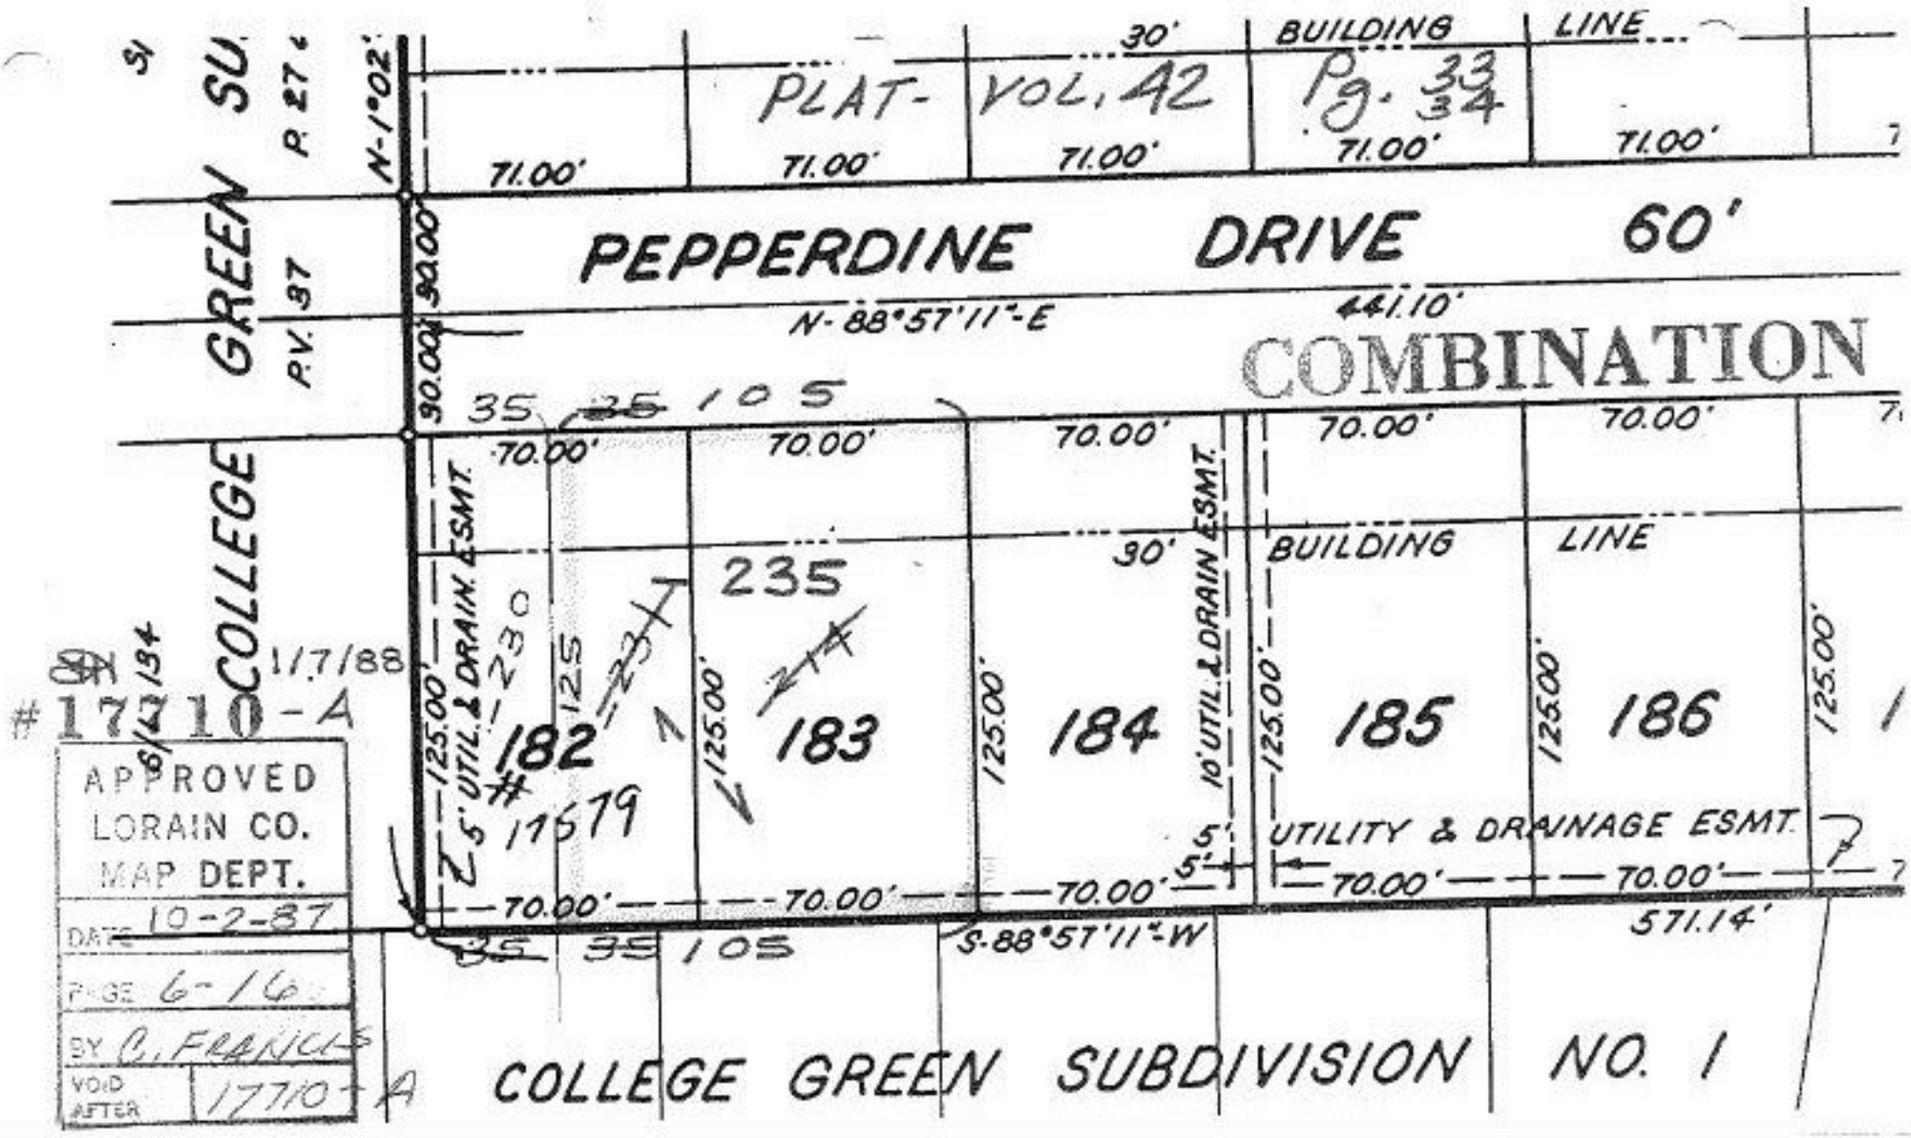Not on TAX MAP
At this Time