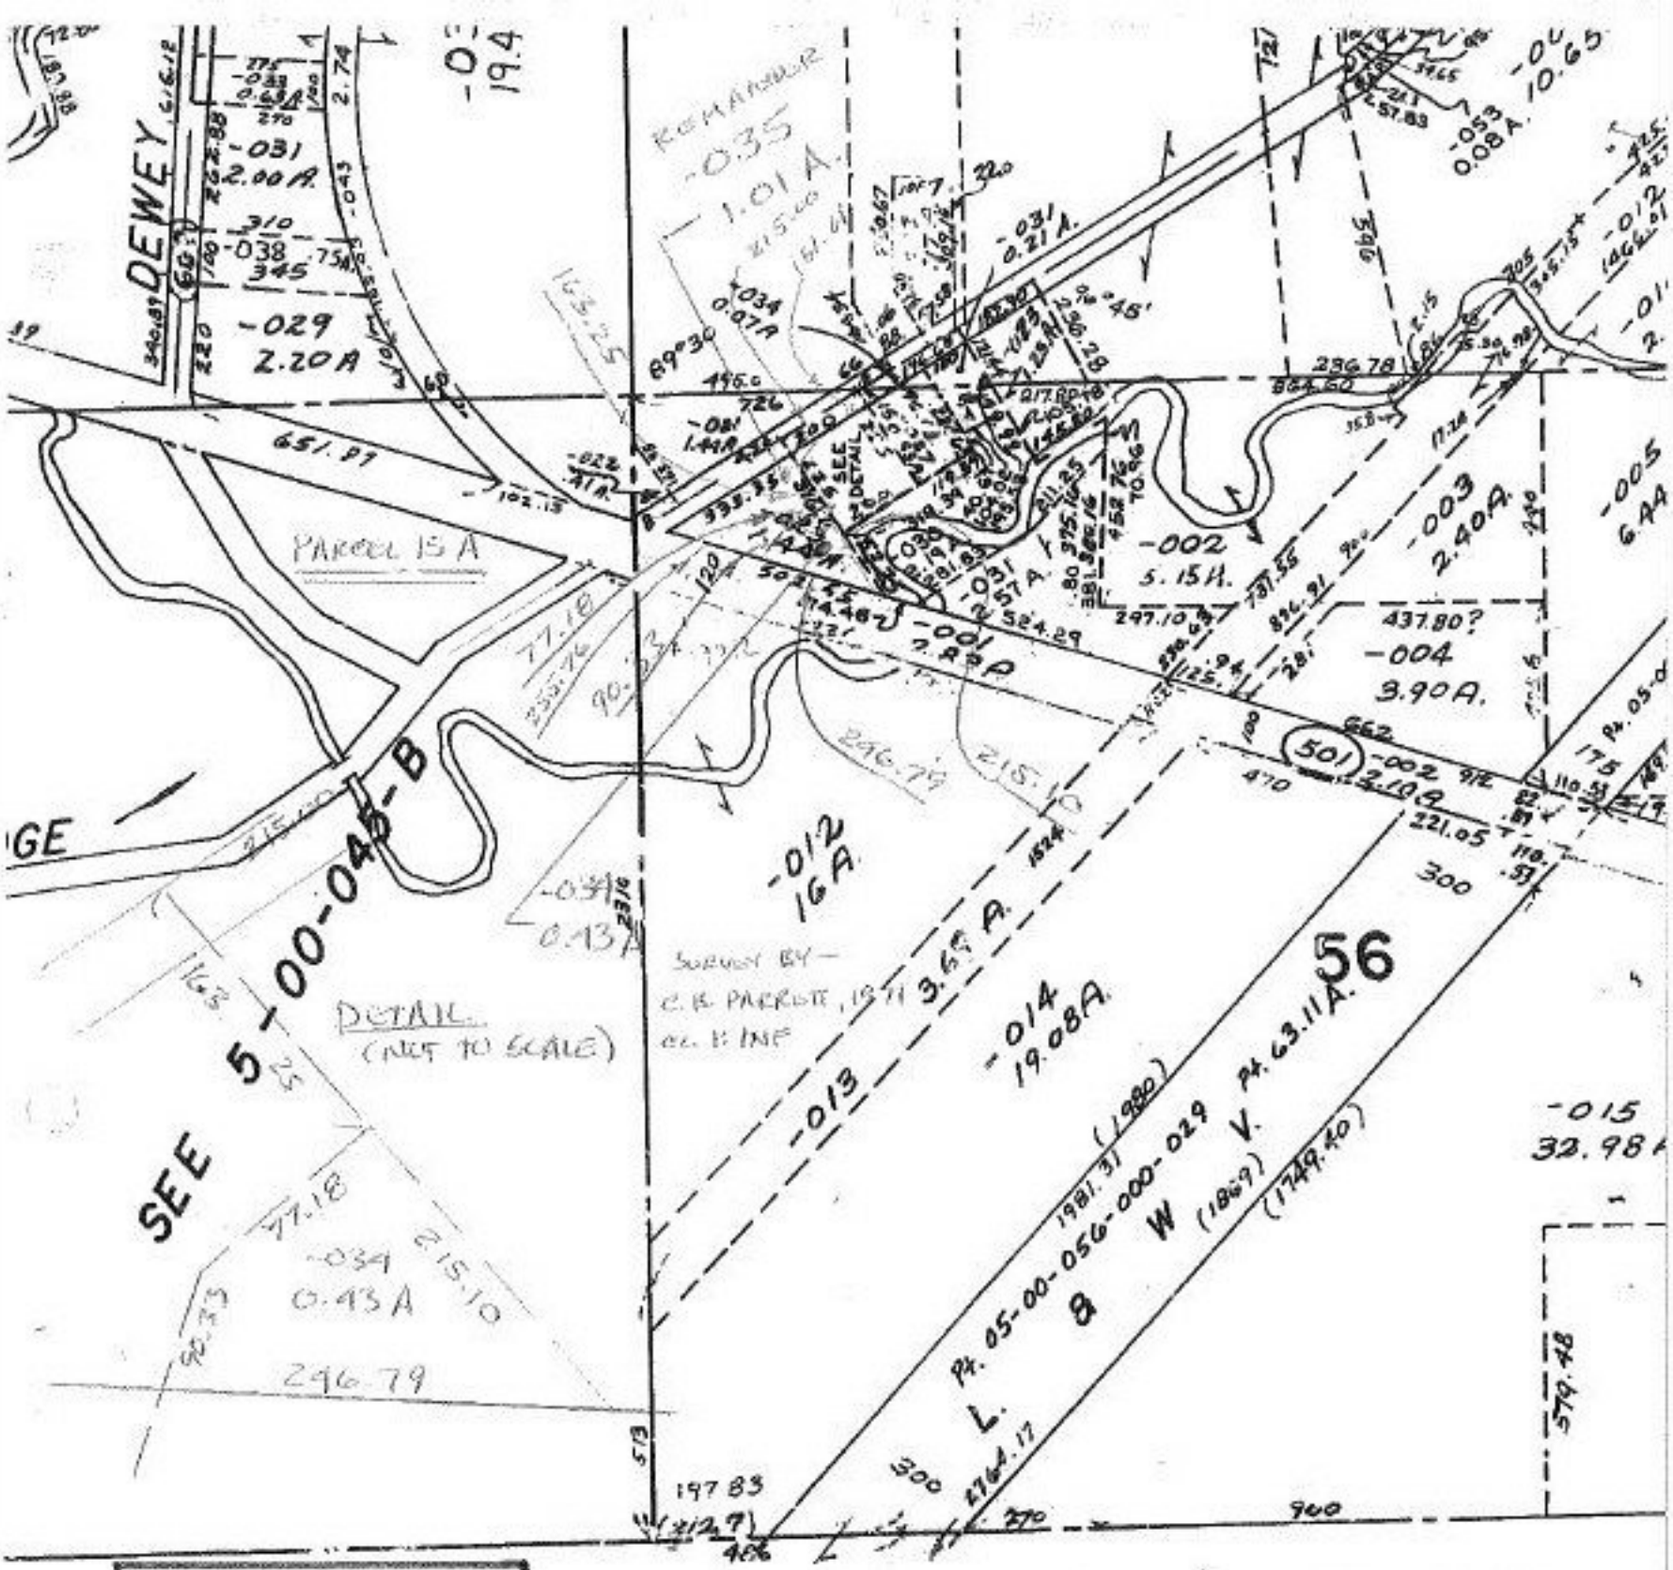

PRIOR INSTRUMENT -

1092/747

SN 11-2-87

#17712

APPROVED
LORAIN CO.
MAP DEPT.
DATE 10-8-87
PAGE 5-C
BY T. Mahan
VOID AFTER