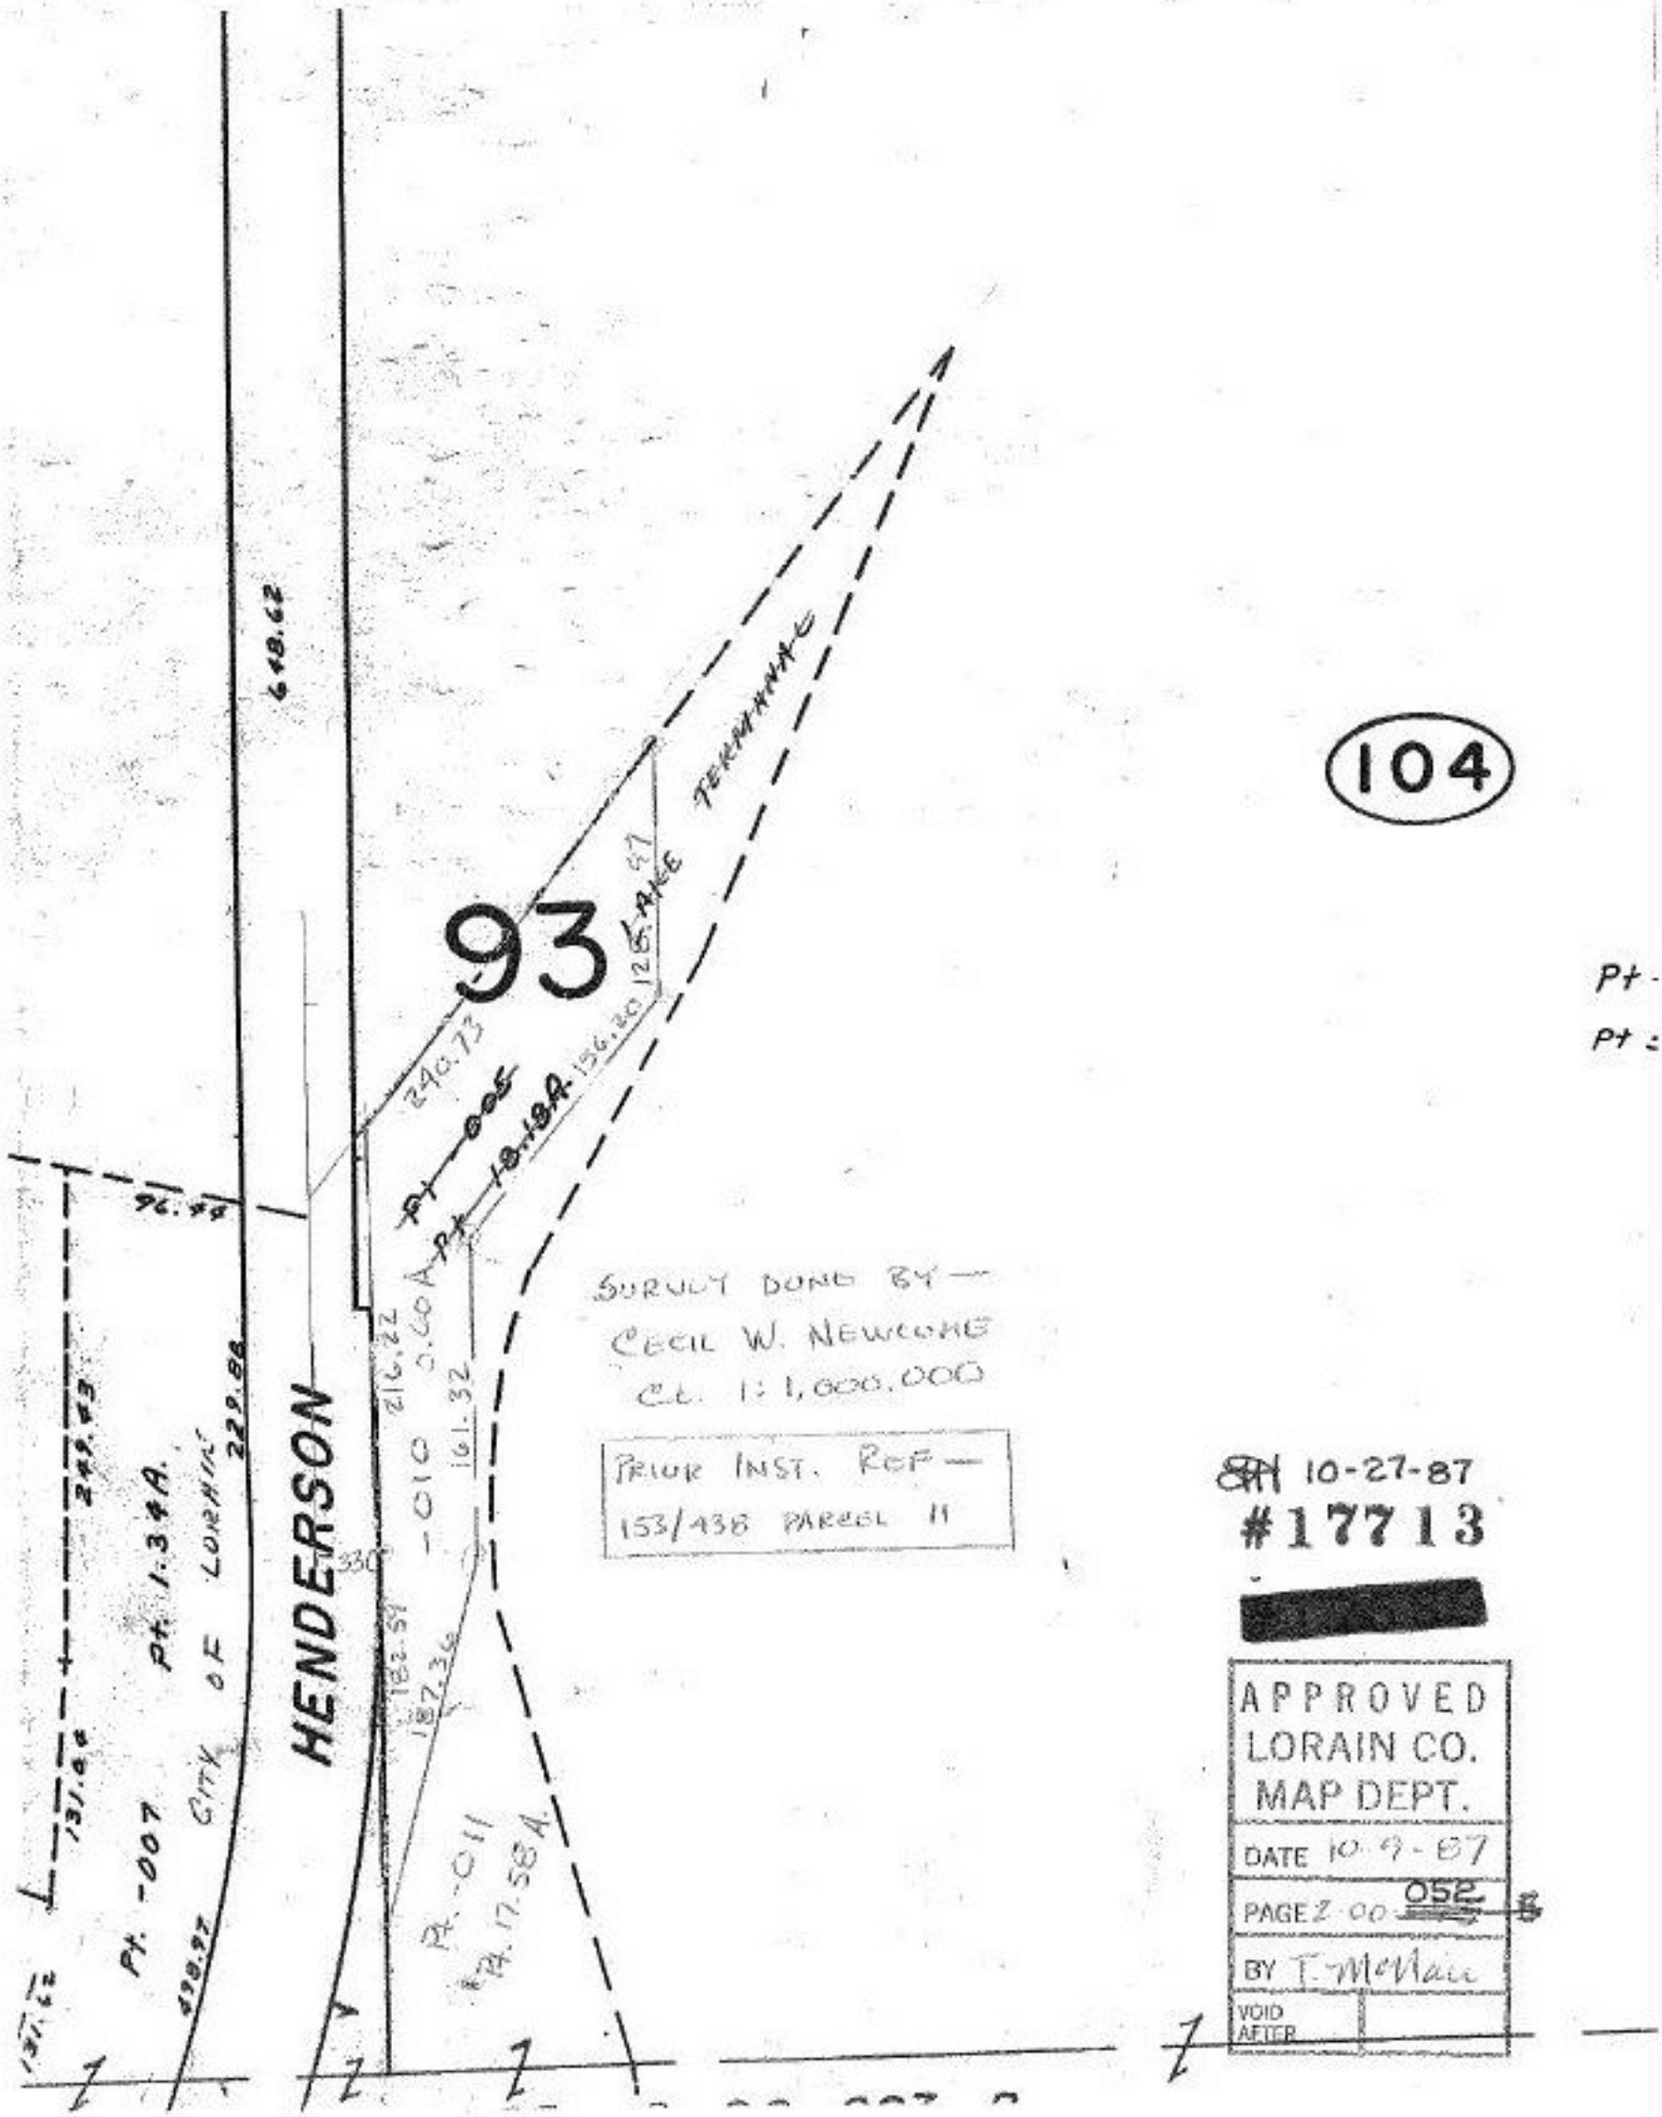
104
93
HENDERSON
LAKE TERMINAL
Pt. 1.34A.
Pt. -007
CITY OF LORAIN
Pt. -005
Pt. 18.18A.
Pt. -010
Pt. -011
Pt. 17.58A.
648.62
96.44
249.43
229.88
131.04
131.62
498.97
240.73
156.20
128.47
216.22
0.60A
161.32
182.59
187.36
330
SURVEY DONE BY —
CECIL W. NEWCOME
Ct. 1:1,000,000
PRIOR INST. REF —
153/438 PARCEL 11
10-27-87
#17713
[redacted]
APPROVED
LORAIN CO.
MAP DEPT.
DATE 10-9-87
PAGE 2-00-052
BY T. McNair
VOID AFTER